

UNT SYSTEM™

Strategic Infrastructure,
Planning & Construction

DATE: February 28, 2025
TO: Potential Respondents
FROM: Carrie Stoeckert—Construction Contract Expeditor III
SUBJECT: Addendum #1
RFQ752-25-1004CS
Chilton Hall 111 Renovation

NOTICE:

Addendum Number 1:

Revisions to Construction Drawings found attached. This Addendum becomes a part of the Contract Documents and shall be acknowledged by each bidder on the proposal form.

ADDENDUM NO. 01

PROJECT: Chilton Hall Level 1 Renovation
HE0569.240100

DATE: February 27, 2025

DISTRIBUTION: [Client, Consultants, Contractor]

For corrections or clarifications, contact: Nada Hamida
nhamida@treanor.design

This Addendum becomes part of the Contract Documents and shall be acknowledged by each bidder on the proposal form. All parties of the original specifications and drawings shall remain in force except as noted below:

ITEM	DETAIL
	GENERAL
1.1	<u>Revisions to room 108E</u> <ol style="list-style-type: none">1. Eliminate the casework on the west and east sides of the room. The only casework that will remain will be on the north end of the rooms (right-hand side of plan).2. Eliminate the two sinks within the room and the sink just to the east of the room, on the north counter in room 108.3. The overhead security grille will be removed and replaced with a solid partition (A3a). The 4 vending machines will be located on the west side of this new partition.4. Eliminate door 108E and the associated wall to the west of the door opening. The wall to the east of the door opening will remain in order to hide the side of the vending machines.5. The two microwaves in the room will be located on the north counter – these will be the only two microwaves. There will be no microwave in the seating area in room 108.6. The ceiling will remain mostly the same but adjusted to accommodate changing the security grille with a partition.
1.2	<u>DSI/Classroom tech scope</u> <p>A standalone DX/hydronic unit will be added to provide dedicated cooling for the server rooms. Sizing and specs will be in a forthcoming addendum/ASI this</p>
1.3	<u>UNT WISE area:</u> <p>Seal all abandoned penetrations in the slab at this area.</p>
	DRAWINGS (REISSUED SHEETS WITH MODIFICATIONS)
1.4	<u>G002 CODE PLAN:</u> <ol style="list-style-type: none">A. Added 1-hour designation at Corridor.
1.5	<u>A005 PARTITION DETAILS AND NOTES:</u> <ol style="list-style-type: none">A. Changed Partition Type K3a1 to K3a.B. Added A3a1 to “WALL SCHEDULE”.
1.6	<u>AD101 DEMOLITION LEVEL 1</u> <ol style="list-style-type: none">A. Changed graphics to show Conference Room wall demo.

ITEM	DETAIL
1.7	<u>A101 FLOOR PLAN – LEVEL 1</u> A. Adjusted door tags. B. Revised partition tag.
1.8	<u>A401 ENLARGED PLANS</u> A. Revised partition tag.
1.9	<u>A411 ENLARGED RESTROOM PLANS, ELEVATIONS, AND ACCESSORY SCHEDULE</u> A. Revised misc. partition tags.
1.10	<u>A501 INTERIOR DETAILS</u> A. A1; Revised notes. B. A1; Adjusted graphics. C. A3; Revised notes.
1.11	<u>A601 DOOR, INTERIOR GLAZING, AND EQUIPMENT SCHEDULE</u> A. Revised Door Schedule as indicated. B. Added dimensions at 'N' door. C. Revised glazing types. D. Added Model and Manufacturer to Equipment Schedule.
1.12	<u>A701 FINISH SCHEDULE</u> A. Added product for Concrete Sealer. B. Added PT-4. C. Removed Unreferenced items.
1.13	<u>A711 FINISH PLANS – LEVEL 1</u> A. Removed Level 5 finish. B. Corrected detail reference. C. Corrected paint tag.
1.14	<u>A751 CASEWORK DETAILS</u> A. Added notes to Lavatory section. B. Revised Spec. Section reference.
1.15	<u>A801 SIGNAGE FLOOR PLAN</u> A. Added signage associated with <i>Area of Refuge</i> .
1.16	<u>S2.02 SECOND FLOOR FRAMING PLAN</u> A. Added detail reference.
1.17	<u>ED201</u> A. Called out location of main electrical room for reference. Called out (2) locations where conduits need to be investigated and rerouted.
1.18	<u>E201</u>

ITEM	DETAIL
	A. Called out location of main electrical room for reference. Added a note about bringing up to code any electrical items that remain.
1.19	<u>E501</u>
	A. Clarified one-line diagram to show Dist. Panel DP1 attached to Main Switchboard.
1.20	<u>T101</u>
	A. Telecom Floor Plan – General Notes Remove all inactive category cabling above ceiling, along with associated data jacks, tracing them back to the patch panel and ensuring proper disconnection and disposal.
1.21	<u>T151</u>
	A. Telecom RCP – General Notes <ul style="list-style-type: none"> a. Remove all inactive category cabling above ceiling, along with associated data jacks, tracing them back to the patch panel and ensuring proper disconnection and disposal. b. Ensure proper support for existing category cabling above the ceiling by installing j-hook supports where feasible.
1.22	<u>MD101</u>
	A. UPDATED: Area A, B, & C note on the floor plan. B. ADDED: Location of existing abandoned equipment to be removed. C. ADDED: Notes by symbol #15, #16, #17, and #18.
1.23	<u>M101</u>
	A. ADDED: Fire dampers to existing ductwork at the new corridor rated partitions. B. ADDED: Fire dampers to the transfer air devices at the new corridor rated partitions. C. MODIFIED: Notes by symbol #17. D. ADDED: Notes by symbol #19. E. ADDED: Sheet notes #5 and #6.
1.24	<u>M201</u>
	A. ADDED: Location of abandoned hydronic piping to be capped. B. MODIFIED: Sheet notes #1. C. ADDED: Notes by symbol #7. D. ADDED: Sheet notes #4 and #5.
1.25	<u>M301</u>
	A. MODIFIED: Mechanical general notes #17. B. ADDED: Mechanical general notes #19, #20, and #21.
1.26	<u>PD101</u>
	A. UPDATED: Area A, B, & C note on the floor plan. B. ADDED: Location of existing floor cleanouts and existing couplings to be replaced. C. ADDED: Notes by symbol #9 and #10. D. ADDED: Sheet notes #3, #4, and #5.
1.27	<u>P301</u>
	A. ADDED: Plumbing general notes #20 and #21.
PROJECT MANUAL/SPECIFICATIONS (REISSUED SPECIFICATION SECTIONS W/ MODIFICATIONS)	
1.28	<u>Section 011000 Table of Contents:</u>
	A. Removed 081116 B. Removed 101100 C. Removed 101419

ITEM	DETAIL
------	--------

	D. Removed 10 1423
--	--------------------

1.29	<u>Section 01 1000 Table of Contents-Volume 1:</u>
------	--

- | | |
|--|--------------------|
| | A. Removed 08 1116 |
| | B. Removed 10 1100 |
| | C. Removed 10 1419 |
| | D. Removed 10 1423 |

1.30	<u>Section 01 1000 Table of Contents-Volume 2:</u>
------	--

- | | |
|--|--------------------|
| | A. Removed 26 2213 |
| | B. Removed 26 2923 |

1.31	<u>Section 08 1213 Hollow Metal Frames</u>
------	--

- | | |
|--|-------------------------------|
| | A. Removed paragraph 2.01, I. |
|--|-------------------------------|

END OF ADDENDUM

YOUR INITIALS/admin staff

2/27/2025 7:02:23 AM Autodesk Docs\\HE0569-2401.00 UNT Chilton Hall Level 1 Renovation\\Chilton Hall Level 1 Renovation_1204_Arch.rvt

PLUMBING FIXTURE COUNT

OCC. TYPE	# OF OCC.	OCC/ GENDER	MIN. # OF WATER CLOSETS RATIO		REQ'D WATER CLOSETS		MIN. # OF LAVATORIES RATIO		REQ'D LAVATORIES		MIN. # OF DRINKING FOUNTAINS RATIO	REQ'D DRINKING FOUNTAINS	SERVICE SINKS
			M	W	M	W	M	W	M	W			
BUSINESS	48	24	(1/25) FOR THE 1ST 50 (1/50) FOR REMAINING		0.96	0.96	(1/40) FOR THE 1ST 80 (1/80) FOR REMAINING		0.6	0.6	(1/100)	0.24	(1) SERVICE SINK
A-3	68	44	(1/125)	(1/65)	0.352	0.677	(1/200)		0.22	0.22	(1/500)	0.088	
STORAGE	3	1.5	(1/100)		0.015	0.015	(1/100)		0.015	0.015	(1/1000)	0.0015	
CLASSROOM	76	38	(1/50)		0.76	0.76	(1/50)		0.76	0.76	(1/100)	0.38	
TOTAL:	215	107.5			2.087	2.412			1.595	1.595		0.7095	
REQ'D					2	3			2	2			1
PROVIDED					6	7			2	3			2
DEFICIENT					-	-			-	-			-

IBC 2021 FUNCTION OF SPACE OCCUPANCY COUNT

- ASSEMBLY - FIXED
3 OCC.
- ASSEMBLY - UNCONCENTRATED
100 OCC.
- BUSINESS
40 OCC.
- EDUCATIONAL - CLASSROOMS
76 OCC.
- STORAGE
3 OCC. **
- STORAGE - MECHANICAL

CODE REVIEW

GOVERNING CODES

- 2021 IBC INTERNATIONAL BUILDING CODE
- 2021 IMC INTERNATIONAL MECHANICAL CODE
- 2021 IPC INTERNATIONAL PLUMBING CODE
- 2021 IFGC INTERNATIONAL FUEL GAS CODE
- 2021 IFC INTERNATIONAL FIRE CODE
- 2018 IECC INTERNATIONAL ENERGY CONSERVATION CODE
- 2020 NFPA 1 FIRE CODE
- 2020 NFPA 101 LIFE SAFETY CODE
- 2023 NFPA 70 NATIONAL ELECTRICAL CODE
- 2013 NFPA 72 NATIONAL FIRE ALARM SIGNALING CODE
- 2012 TAS TEXAS ACCESSIBILITY STANDARDS

OCCUPANCY

B - BUSINESS

CONSTRUCTION TYPE

TYPE I-B*
*EXISTING BUILDING CLASSIFIED AS II-F-R UNDER THE 1985 U.B.C.

GENERAL BUILDING HEIGHTS AND AREAS

Allowable: Type IB NIS:
Business: Height: 160' - 0" (11 stories), Unlimited SF

Actual:
Business: Height: 48' - 0" (3 stories), 118,000 SF (9,542 SF in scope)

FIRE RESISTANCE RATINGS - BUILDING ELEMENTS

Structural frame	2 hours
Exterior bearing walls	2 hours
Interior bearing walls	2 hours
Exterior non-bearing walls	0 hours
Non-bearing walls	0 hours
Shells	2 hours
Floors/ceiling	2 hours
Roofs/ceiling	1 hours

FIRE PROTECTION SYSTEM

Fire Extinguishers
Provided throughout per NFPA 10. Max travel distance to be the nearest fire extinguisher location = 75' - 0"

MEANS OF EGRESS

Egress Width Factor without Sprinkler System .2
Egress Width Factor without Sprinkler System for Stairs .3


Exit Requirements per Floor:

1-500	2
501-1,000	3
>1,000	4

*All other levels are existing conditions with no changes
** Not in scope (Diagonal Hatch)

LIFE SAFETY LEGEND

USE DESIGNATION / OCCUPANT LOAD TAG

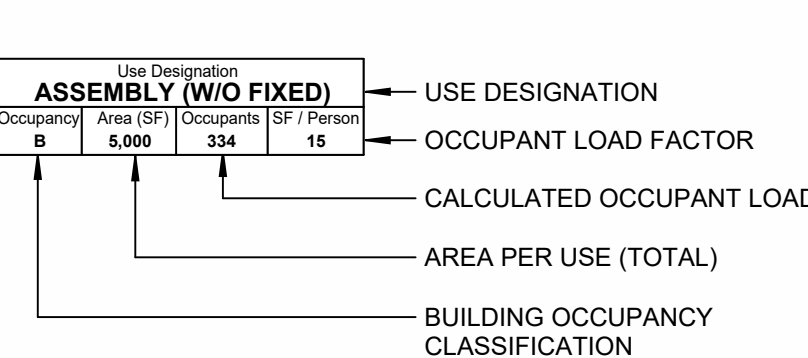

LIFE SAFETY FIRE WALL GRAPHICS

- 0 HR FRR "SMOKE PARTITION"
- 1 HR FRR "FIRE BARRIER"
- 1 HR FRR "SMOKE BARRIER"
- 2 HR FRR "FIRE BARRIER"
- 2 HR FRR "FIRE WALL"
- 2 HR FRR "SMOKE BARRIER"
- 3 HR FRR "FIRE BARRIER"
- 3 HR FRR "FIRE WALL"

- EXIT ACCESS TRAVEL DISTANCE
- COMMON PATH OF TRAVEL DECISION POINT
- 42' - 6" TOTAL TRAVEL DISTANCE
- (300' - 0") ALLOWABLE DISTANCE
- 25' - 0" COMMON PATH DISTANCE
- (75' - 0") MAX. COMMON PATH

EGRESS COMPONENT CAPACITY

- ACTUAL EXIT WIDTH (CAPACITY) ACTUAL OCCUPANT LOAD EXTERIOR EXIT/ EXIT INFORMATION
- ACTUAL EXIT WIDTH (CAPACITY) ACTUAL OCCUPANT LOAD INTERIOR EXIT/ EXIT INFORMATION

- ACTUAL OCCUPANT LOAD AT EXIT
- EXIT WIDTH FACTOR
- REQUIRED EXIT WIDTH
- DIRECTION OF EXIT

- FEC FIRE EXTINGUISHER & CABINET
- FEC EXISTING FIRE EXTINGUISHER & CABINET
- FE FIRE EXTINGUISHER & WALL MOUNTING BRACKET
- KNOX BOX - FIRE DEPARTMENT KEYS KEYS

TREANOR

2554 Elm Street, Suite 200
Dallas, TX 75226
P: 214.752.0118
www.treanor.design

UNIVERSITY OF NORTH TEXAS

CHILTON HALL LEVEL 1 RENOVATION

410 Avenue C
Denton, Texas 76201



This drawing is an instrument of service and shall remain the property of Treanor. This drawing and the concepts and ideas contained herein shall not be used, reproduced, revised, or related without the express written approval of Treanor, unless the Architect-Client agreement requires otherwise.
Submission or distribution of this drawing to meet official or regulatory requirements or for other purposes in connection with this project is not to be construed as publication in derogation of any of the rights of Treanor.

Issue For: CONSTRUCTION
Date: 01/16/2025

REVISIONS		
NO	DESCRIPTION	DATE
1	ADDENDUM 1	02/27/2025

G002

CODE PLAN

Treanor NO. HE0569-2401.00

LEVEL 1 CODE PLAN

A1

1/8" = 1'-0"







WALL SCHEDULE						
TYPE	Type	DIM.	GYP. BD.	FIRE RATING	UL NO.	STC(SOUND)
A3a	A3a - MTL STUD, SGL LAYER OF GYP BD, BS. TO ROOF OR BOTTOM OF DECK, ACOUSTIC	4 7/8"				
A3f1	A3f1 - MTL STUD, SGL LAYER OF GYP BD, BS. TO ROOF OR BOTTOM OF DECK, FIRE PARTITION, 1 HR	4 7/8"		1HR (Fire)	UL U419	
A6f1	A6f1 - MTL STUD, SGL LAYER OF GYP BD, BS. TO ROOF OR BOTTOM OF DECK, FIRE PARTITION, 1 HR	7 1/4"		1HR (Fire)		
D3a1	D3a1 - MTL STUD, DBL LAYER OF GYP BD, BS. TO ROOF OR BOTTOM OF DECK, 1 HR	8 1/8"		1HR (Fire)		
D3a2	D3a2 - MTL STUD, DBL LAYER OF GYP BD, BS. TO ROOF OR BOTTOM OF DECK, ACOUSTIC	8 1/8"				
D3a2	D3a2 - MTL STUD, DBL LAYER OF GYP BD, BS. TO ROOF OR BOTTOM OF DECK, FIRE BARRIER, 2 HR	6 1/8"		2HR (Fire)		
D3a2	D3a2 - MTL STUD, DBL LAYER OF GYP BD, BS. TO ROOF OR BOTTOM OF DECK, FIRE WALL, 2 HR	6 1/8"		2HR (Fire Wall)		
F2a	F2a - MTL STUD, SGL LAYER OF GYP BD, SS. TO ROOF OR BOTTOM OF DECK	3 1/8"				
F3	F3 - MTL STUD, SGL LAYER OF GYP BD, SS. TO ROOF OR BOTTOM OF DECK	4 1/4"				
F3a	F3a - MTL STUD, SGL LAYER OF GYP BD, SS. TO ROOF OR BOTTOM OF DECK, ACOUSTIC	4 1/4"				
K3a	K3a - MTL DBL STUD, SGL LAYER OF GYP BD, BS. TO ROOF OR BOTTOM OF DECK, ACOUSTIC	8 3/8"				

LEGEND:


- PARTITION TYPE
- DIMENSIONAL MODIFIER
- TYPE MODIFIER
- RATING - WHERE APPLIES

PARTITION TYPE MARK: [A3f1]

PARTITION TYPE:	DIMENSIONAL MODIFIER	TYPE MODIFIER:	RATING:
A. MTL STUD, SGL LAYER OF GYP BD, BS. TO ROOF OR BOTTOM OF DECK	MTL STUD	a. ACOUSTIC, SOUND, STC	0 - NON-RATED
E. MTL STUD, SGL LAYER OF GYP BD, SS, DBL LAYER OF GYP BD, SS. TO ROOF OR BOTTOM OF DECK	0 - 7/8"	b. EXPANDED METAL	1 - 1 HOUR
F. MTL STUD, SGL LAYER OF GYP BD, SS, 4" ABV CLG	1 - 1 5/8"	c. EXPANDED METAL/ACOUSTIC, SOUND, STC	2 - 2 HOUR
H. MTL STUD, DBL LAYER OF GYP BD, SS, SGL LAYER OF GYP BD, SS. TO ROOF OR BOTTOM OF DECK	2 - 2 1/2"	d. FIRE BARRIER	3 - 3 HOUR
K. MTL DBL STUD, SGL LAYER OF GYP BD, BS. TO ROOF OR BOTTOM OF DECK	3 - 3 5/8"	e. FIRE BARRIER/ACOUSTIC, SOUND, STC	4 - 4 HOUR
	4 - 4"	f. FIRE PARTITION	5 - 1/2 HOUR
	5 - 5"	g. FIRE PARTITION/ACOUSTIC, SOUND, STC	
	6 - 6"	h. FIRE WALL	S - SMOKE
		i. Do not use	
		j. FIRE WALL/ACOUSTIC, SOUND, STC	
		k. LEAD	
		l. Do not use	
		m. LEAD/ACOUSTIC, SOUND, STC	
		n. RF SHIELDED/ACOUSTIC, SOUND, STC	
		o. RF SHIELDED/ACOUSTIC, SOUND, STC/EXPANDED METAL	
		p. SECURITY	
		q. SECURITY/ACOUSTIC, SOUND, STC	
		r. SMOKE BARRIER	
		s. Do not use	
		t. RF SHIELDED/ACOUSTIC, SOUND, STC/LEAD	

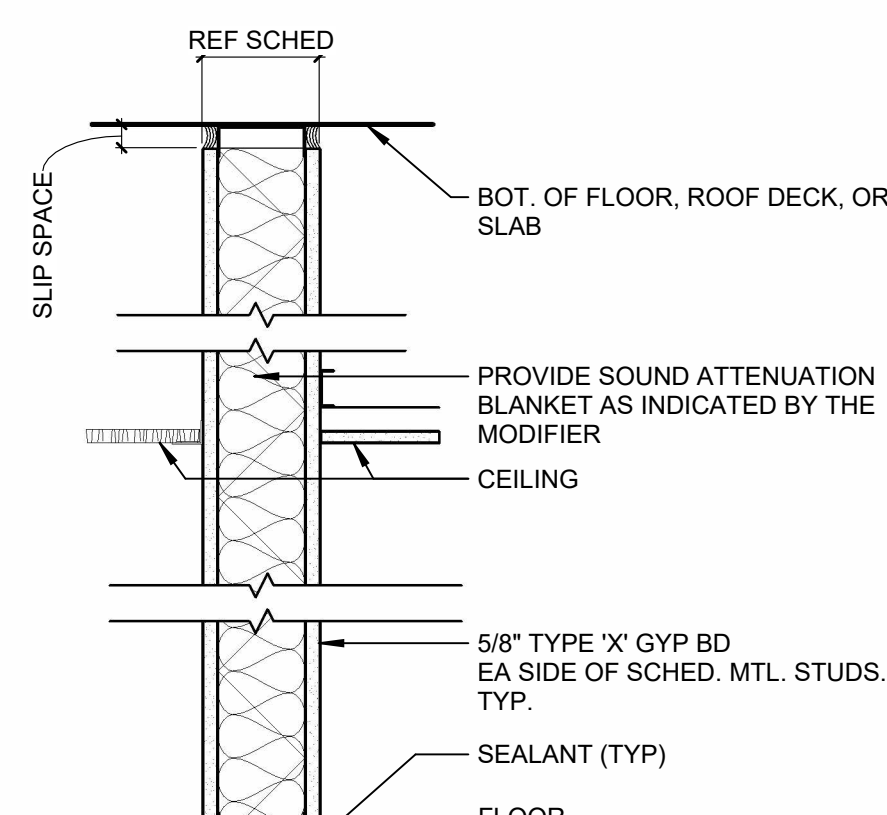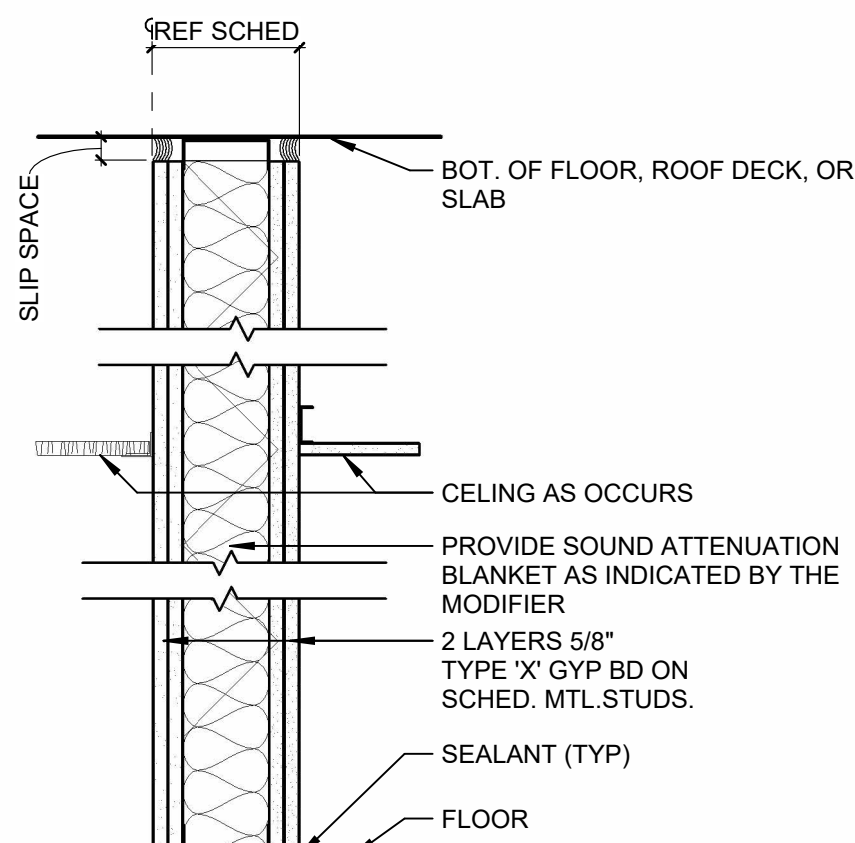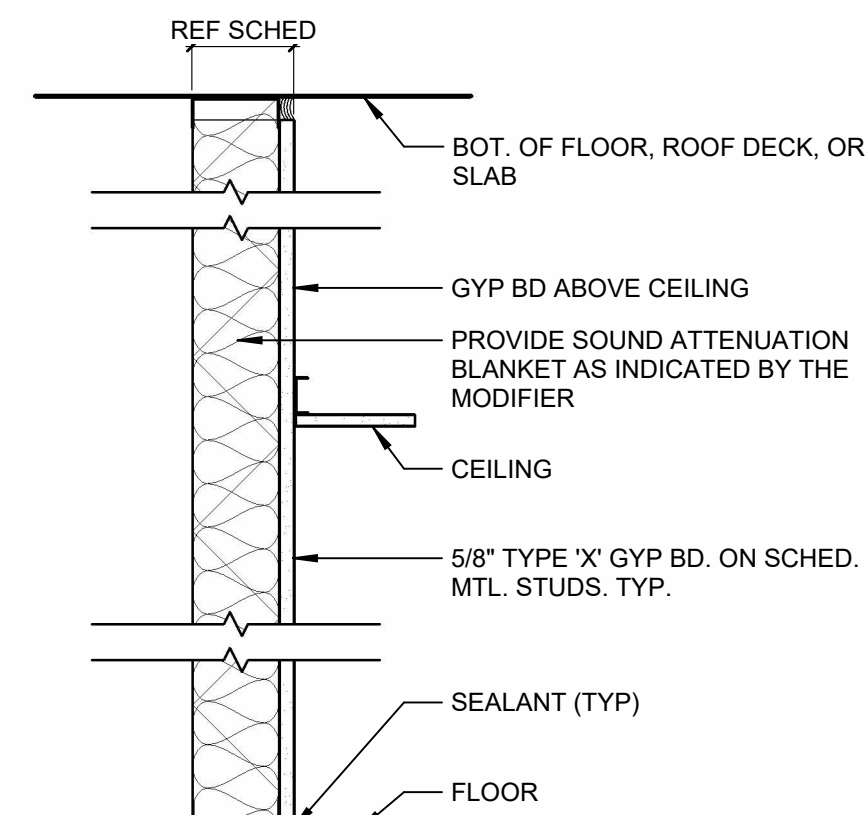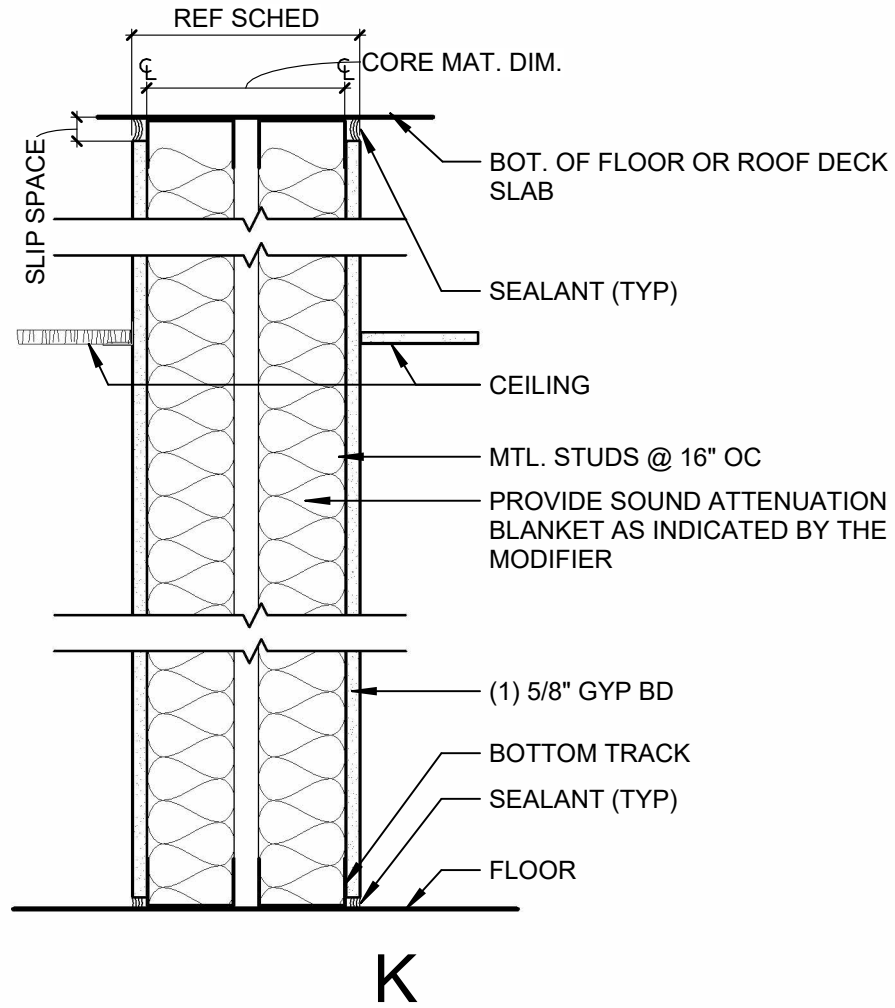

BACKING PLATE DETAIL:

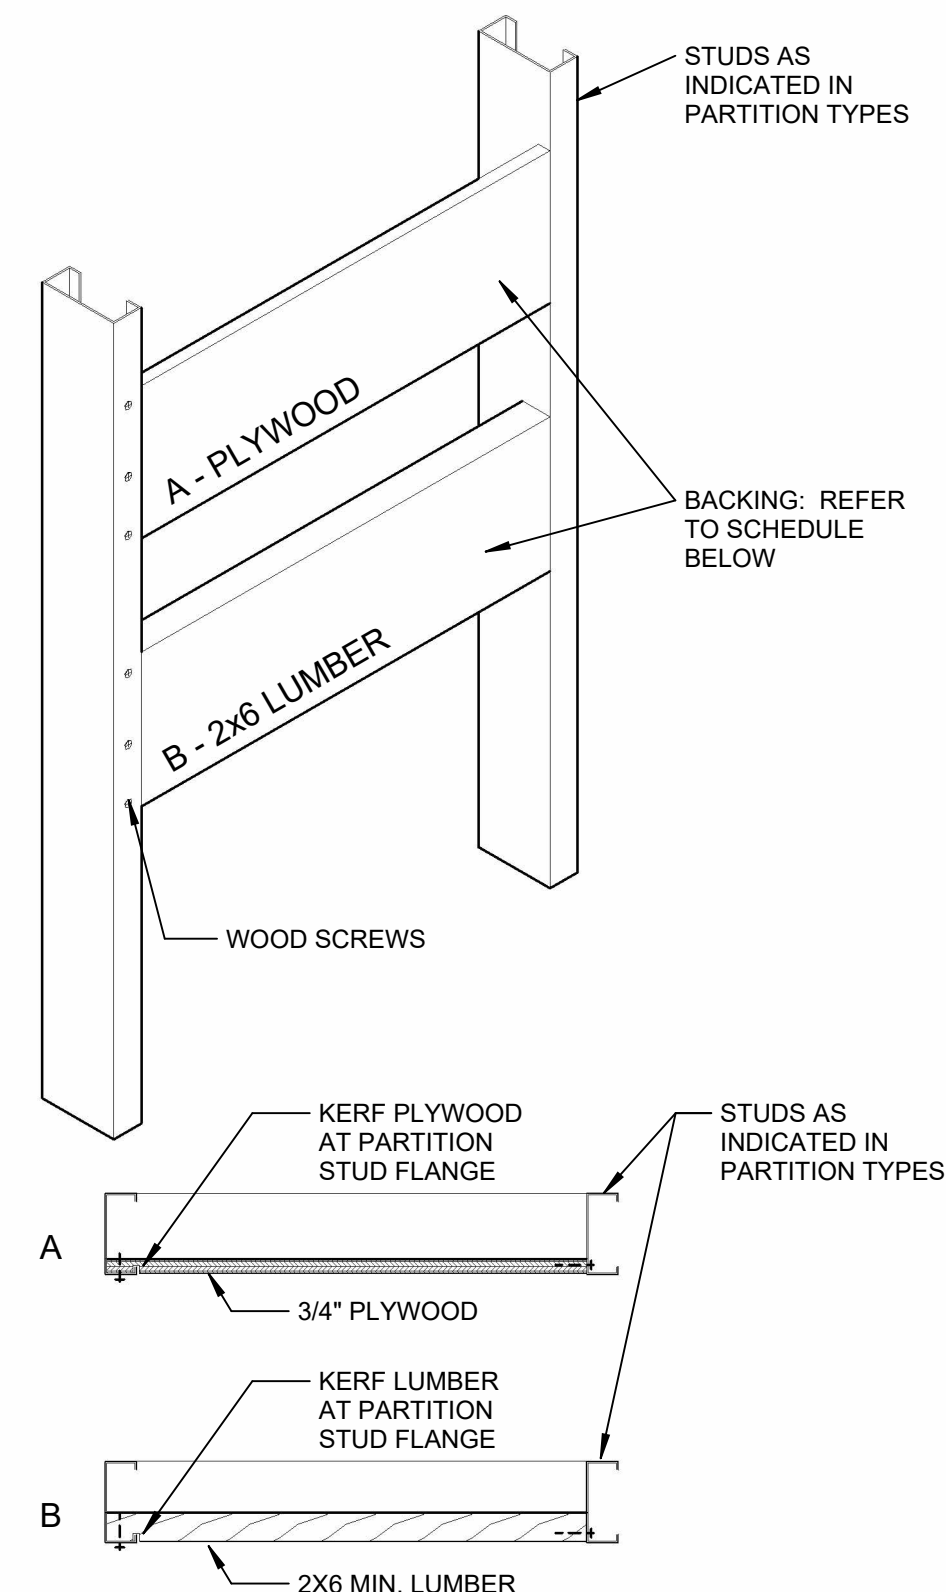


BACKING PLATE SCHEDULE

TYPE	A	B
DESCRIPTION	3/4" PLYWOOD	2X8 NOMINAL LUMBER

- PROVIDE CONCEALED PLYWOOD OR LUMBER BACKING (FIRE-RETARDANT-TREATED WHERE REQUIRED) FOR SUPPORT OF WALL-MOUNTED GRAB BARS, HANDRAILS, FIXTURES, ACCESSORIES, SPECIALTIES, EQUIPMENT, TRIM AND CABINETS.
- EXTEND BACKING TO NEXT STUD BEYOND ATTACHMENT LOCATION, BOTH DIRECTIONS.
- ANCHOR BACKING SECURELY TO STUDS. KERF BACKING AT STUD FLANGES SO BACKING IS TIGHT TO BACK OF GYPSUM BOARD.


OPTIONAL HEAD DETAIL

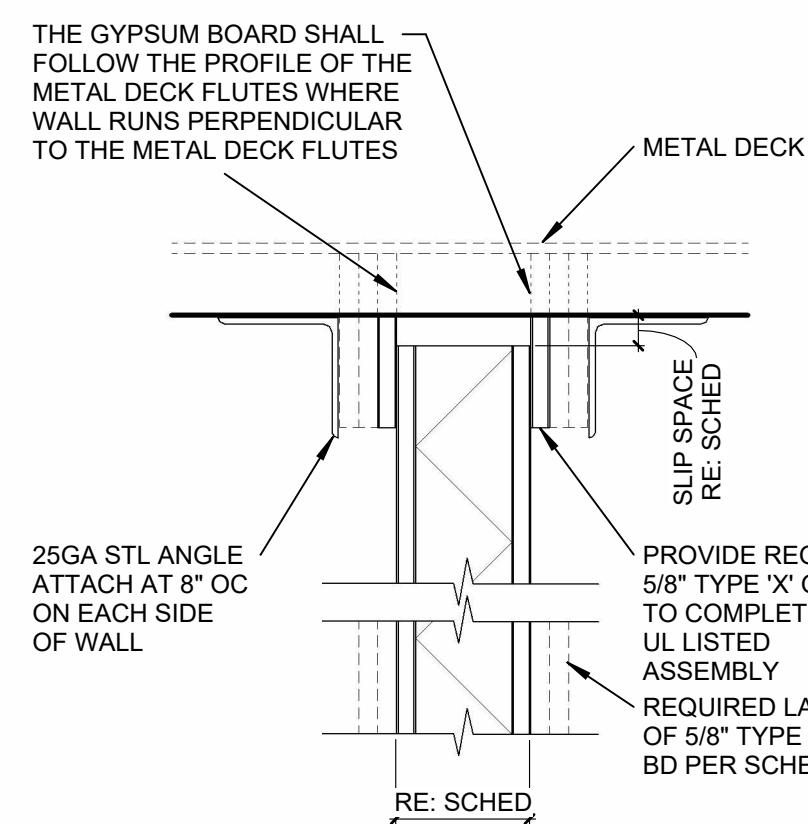

PARTITION NOTES:


- STUD SPACING IS 16 INCHES ON CENTER MAX.
- REFER TO THE ARCHITECTURAL FLOOR PLANS (A100 SHEETS)
- REFER TO THE DASHED LINES ON THE CODE PLANS (G005) FOR THE FIRE RATING LOCATIONS. PARTITIONS MUST CONFORM TO TESTED, RATED ASSEMBLIES WHEN THEY ARE INDICATED TO BE RATED ON THE ARCHITECTURAL CODE PLANS. WHEN NO RATING IS INDICATED, CONSTRUCT THE PARTITION PER THE INDICATED TYPE AS A NON-RATED ASSEMBLY.
- LABEL FIRE AND SMOKE WALLS AS FOLLOWS: LABEL BOTH SIDES; LABEL ALL SECTIONS; USE 4" HIGH STENCILS; USE FLUORESCENT ORANGE PAINT; LOCATE ABOUT 12" ABOVE THE FINISHED CEILING; SPACE STENCILS 10 FEET OC MAX; SPECIFIC LABELS TO READ "1HR", "2HR", "1HR SMOKE", "2HR SMOKE", "SMOKE", ETC AS IDENTIFIED IN THE LIFE SAFETY PLANS.
- PROVIDE STENCIL WITH THE LABEL "SOUND" AS DESCRIBED IN NOTE 3 ON ALL SOUND RATED WALLS IDENTIFIED BY A "S" SUFFIX AND THAT GO TO STRUCTURE.
- PROVIDE FIRE STOP & SMOKE STOP SYSTEMS PER SPECIFICATION AT ALL PENETRATIONS & OPENINGS (INCLUDING THE PERIMETER) THROUGH FIRE RATED WALLS.
- SEAL ALL PENETRATIONS & OPENINGS (INCLUDING THE PERIMETER) PER SPECIFICATIONS IN ALL SOUND RATED WALLS INDICATED BY A "S" SUFFIX.
- THE PARTITION TYPES INDICATE THE BASIC WALL CONSTRUCTION ONLY. REFER TO ALL OF THE CONSTRUCTION DOCUMENTS FOR OTHER REQUIREMENTS INCLUDING: MECHANICAL, ELECTRICAL, PLUMBING, BLOCKING & BACKING, WALL BASE, WALL FINISH, AND RECESSED & SURFACE MOUNTED EQUIPMENT.
- PROVIDE TESTED, RATED ASSEMBLIES AT THE TOP OF ALL PARTITIONS INDICATED TO BE FIRE OR SMOKE RATED THAT EXTEND TO THE BOTTOM OF STRUCTURE OR DECK ABOVE. ALL ASSEMBLIES SHALL BE TESTED BY UNDERWRITERS LABORATORY OR OTHER TESTING FACILITY ACCEPTABLE TO THE AUTHORITY HAVING JURISDICTION. PROVIDE A FIRE AND SMOKE RATING CONSISTENT WITH THE PARTITION. THE ASSEMBLY SHALL ALLOW VERTICAL MOVEMENT PER THE SLIP SPACE SCHEDULE.
- WHEN WALLS CONTINUE PAST INTERMEDIATE STRUCTURE, FOR EXAMPLE IN MULTI-STORY STAIR ENCLOSURES, ATTACHMENT TO INTERMEDIATE STRUCTURE SHALL BE WITH A SLOTTED CONNECTION OR OTHER MEANS SO THAT STRUCTURAL DEFLECTION WILL NOT TRANSFER LOADS TO WALL FRAMING.
- WHERE METAL DECK ASSEMBLIES AND FIRE RATED WALLS MEET, THE CONTRACTOR MAY INSTALL FIRE RATED MINERAL BATT INSULATION WITH FIRE CAULKING OR USE THE HEAD OF DETAIL SHOWN BELOW THE SLIP SPACE SCHEDULE ON THIS SHEET TO COMPLETE THE UL LISTED ASSEMBLY.

PARTITION PRIORITY:

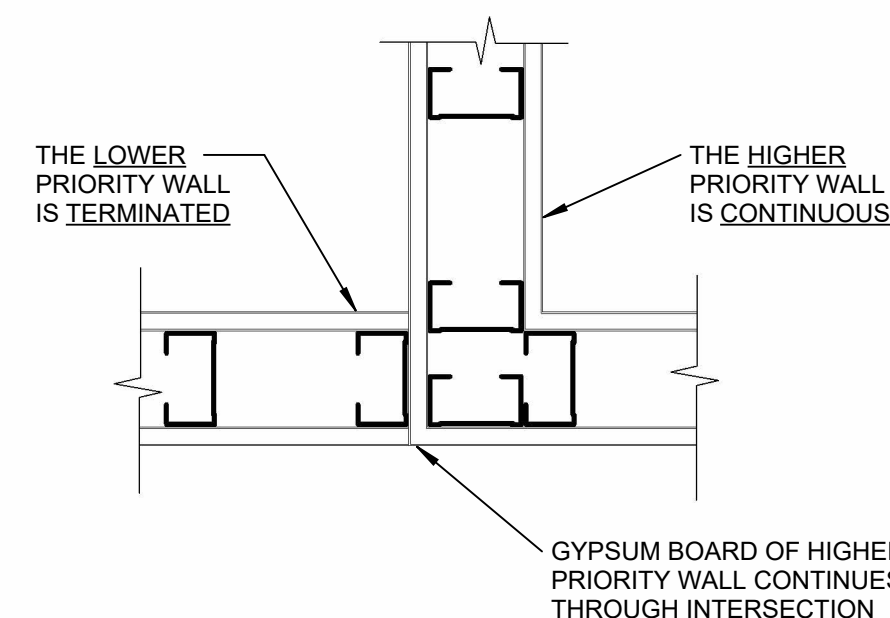


PARTITION TYPE	PRIORITY
3 HOUR FIRE	1 - HIGHEST
2 HOUR SHAFT	2
2 HOUR FIRE	3
1 HOUR SHAFT	4
1 HOUR	5
SMOKE	6
ACOUSTIC	7
NO FIRE OR ACOUSTIC RATING	8 - LOWEST

PARTITION TERMINATIONS AT EXTERIOR WALL:

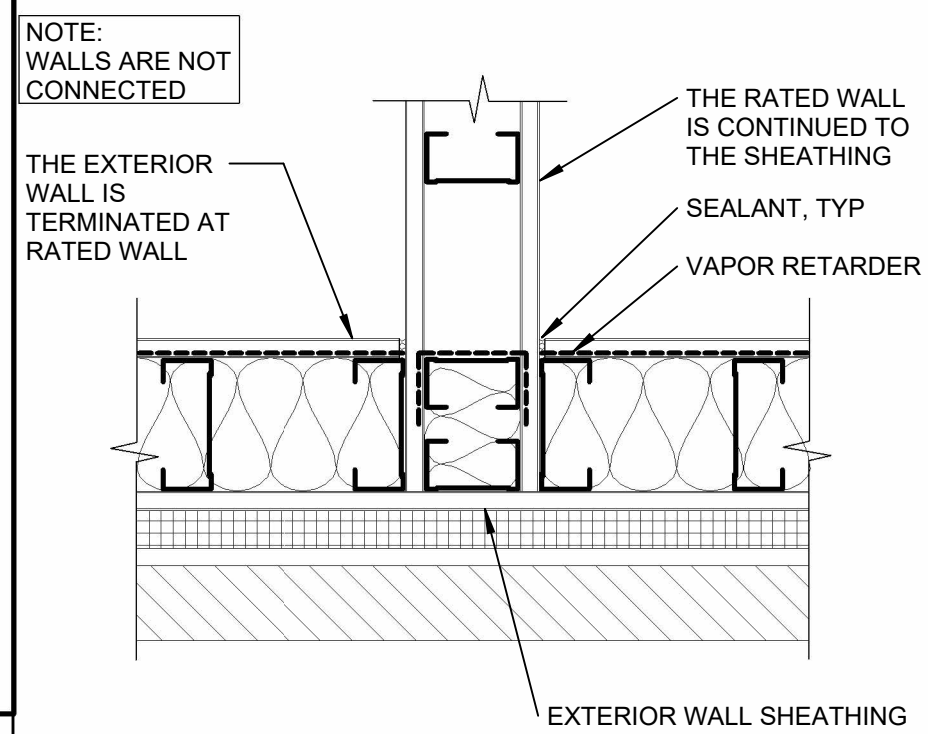

RATED INTERIOR PARTITION


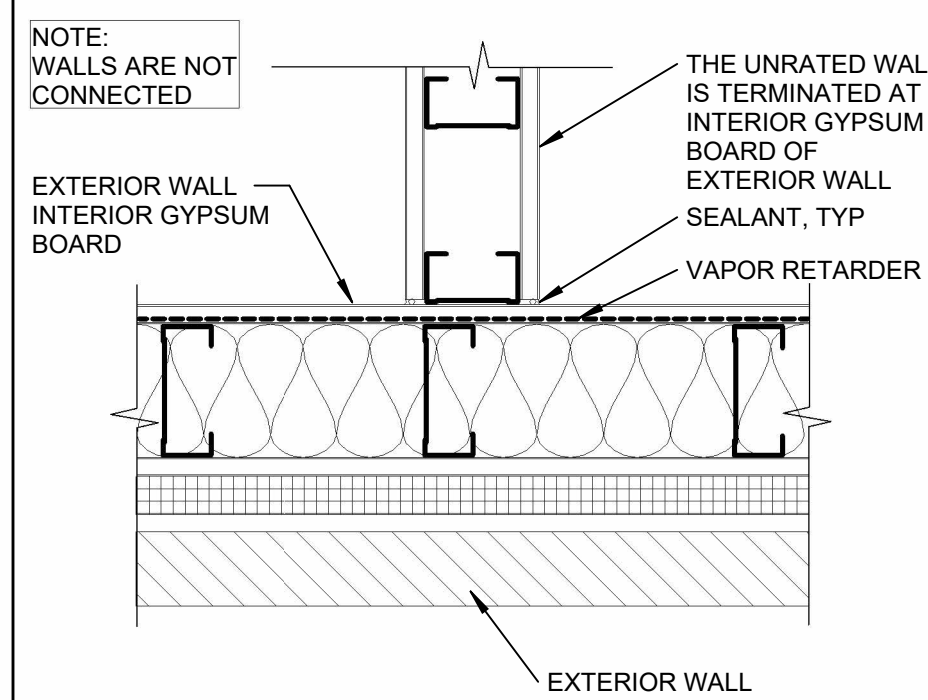


UNRATED INTERIOR PARTITION


REVISIONS		
NO	DESCRIPTION	DATE
1	ADDENDUM 1	02/27/2025

Autodesk Docs\\HE0569\\2401.00 UNT Chilton Hall Level 1 Renovation\\Chilton Hall Level 1 Renovation_1024_Arch.rvt


2/27/2025 7:02:35 AM

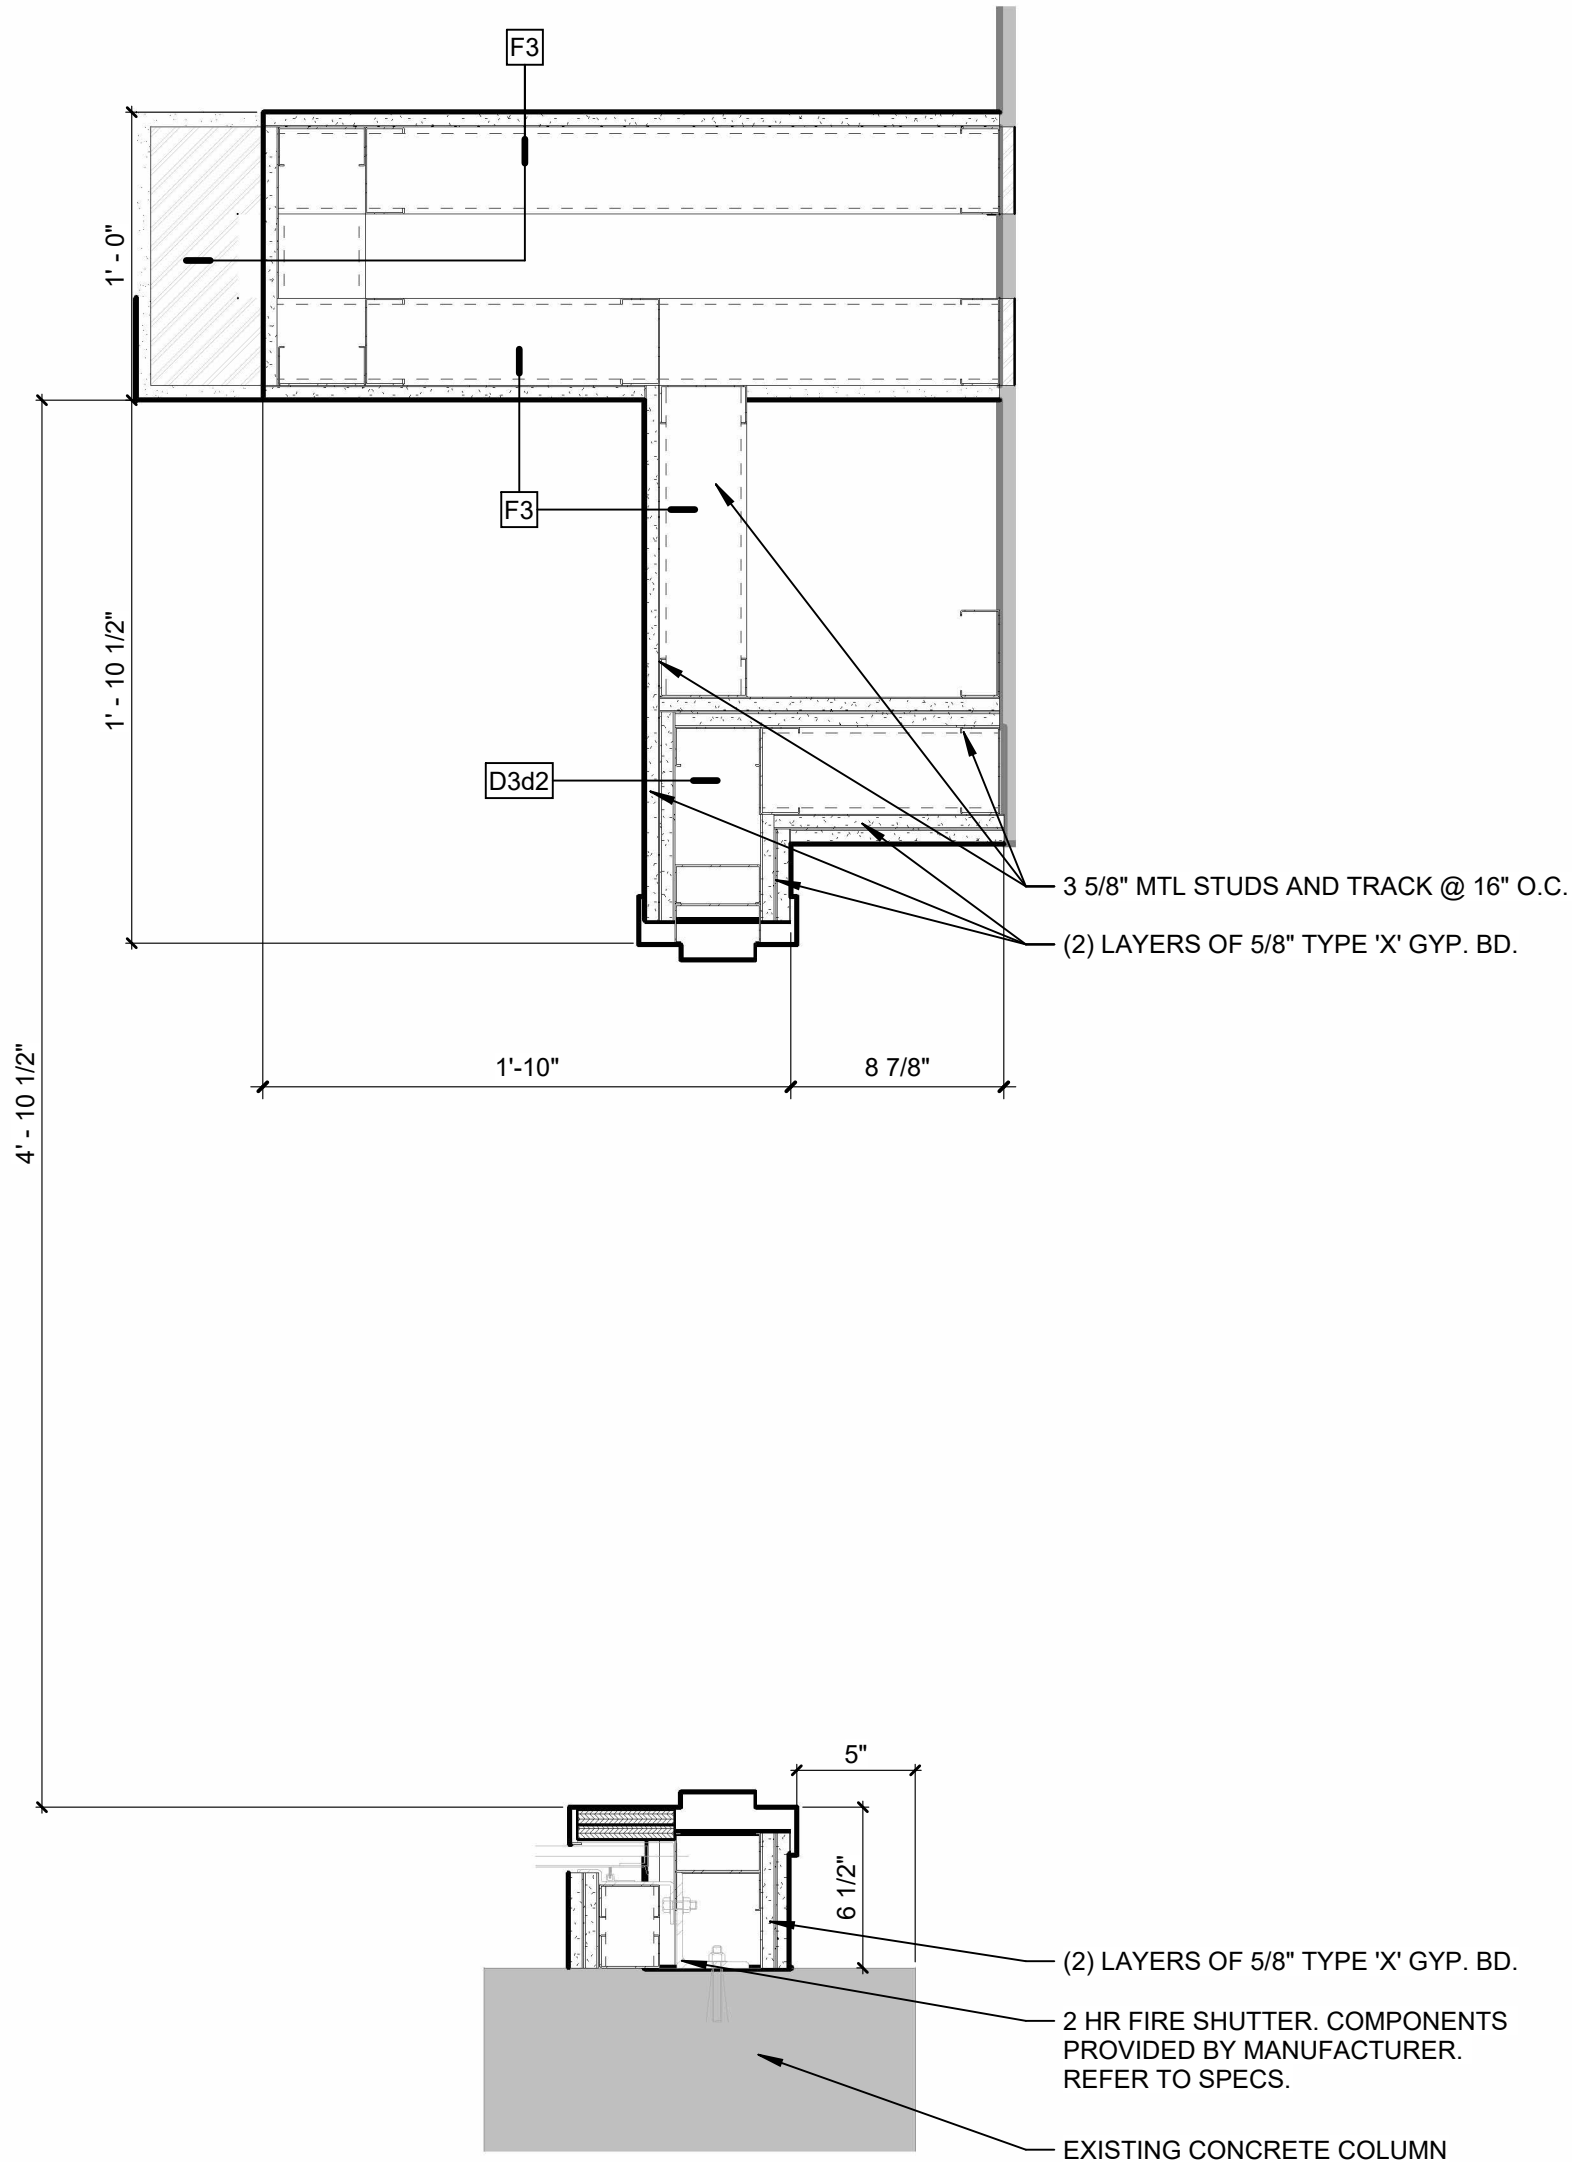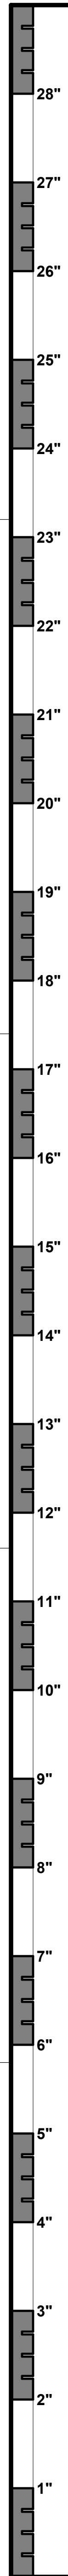


DETAIL AT FIRE SHUTTER - EGRESS DOOR A5
1 1/2" = 1'-0"

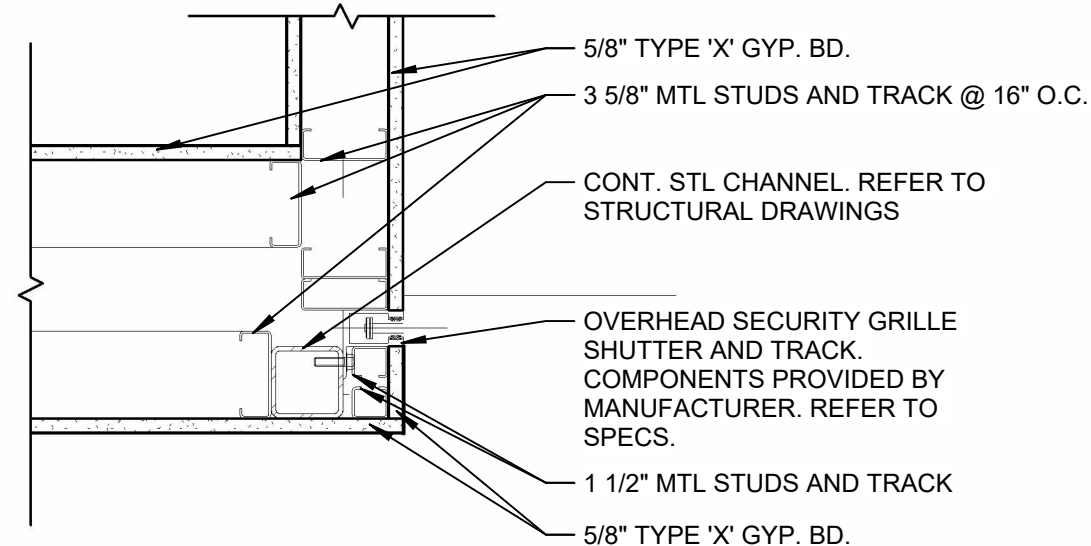

DETAIL AT SECURITY GRILLE D3
1 1/2" = 1'-0"

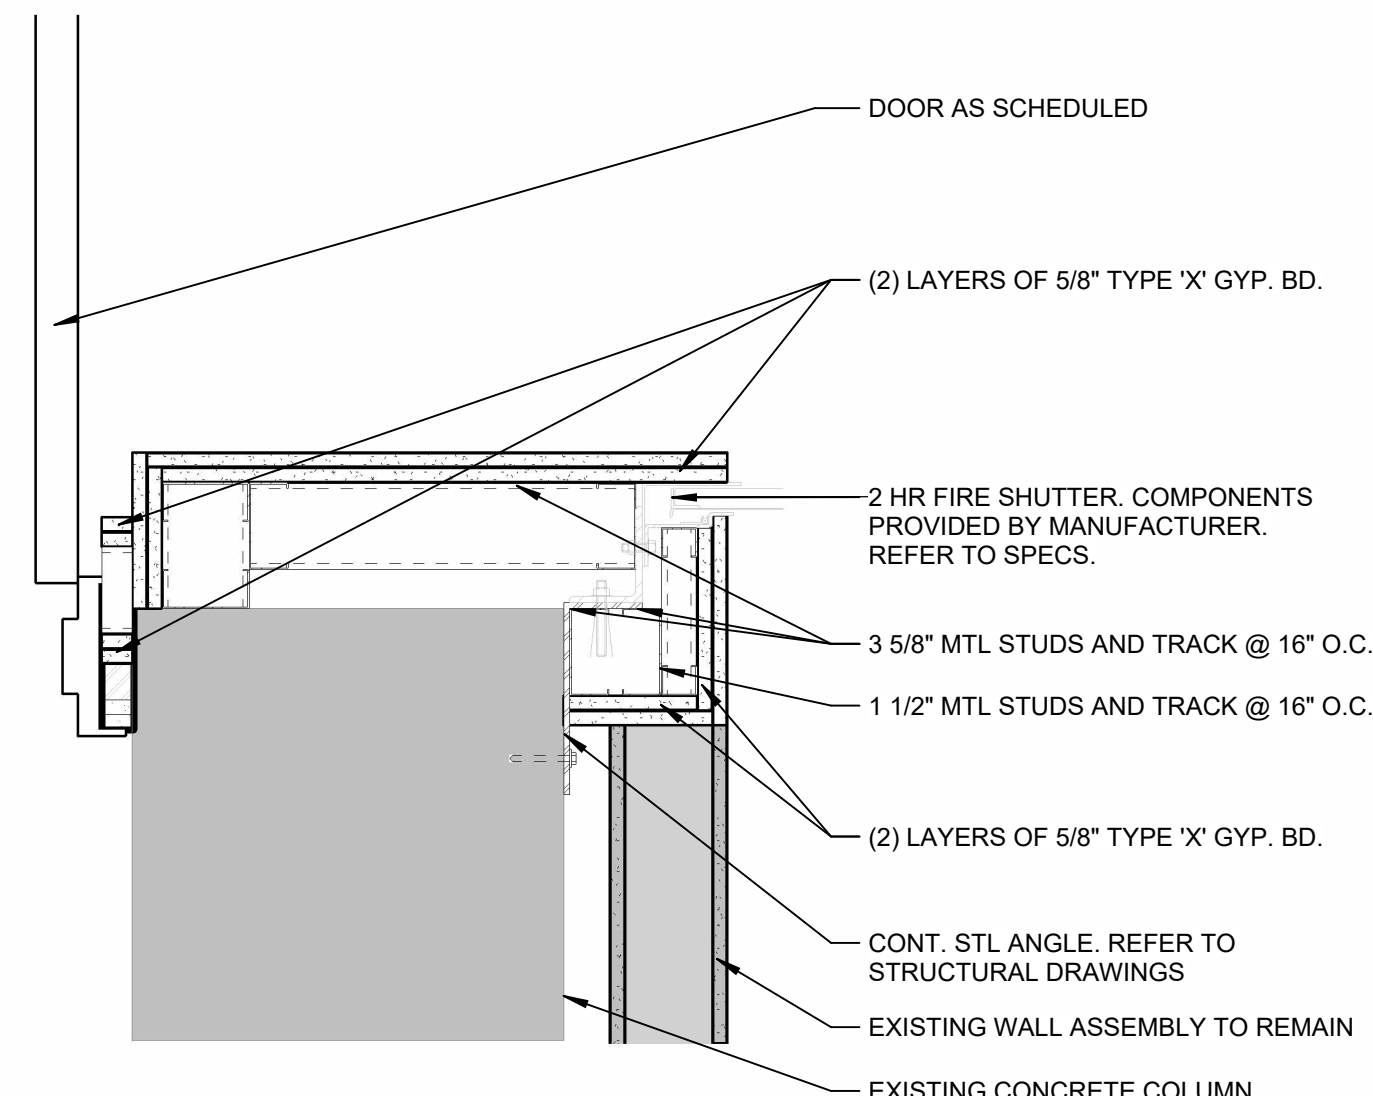

DETAIL AT FIRE DOOR D1
1 1/2" = 1'-0"

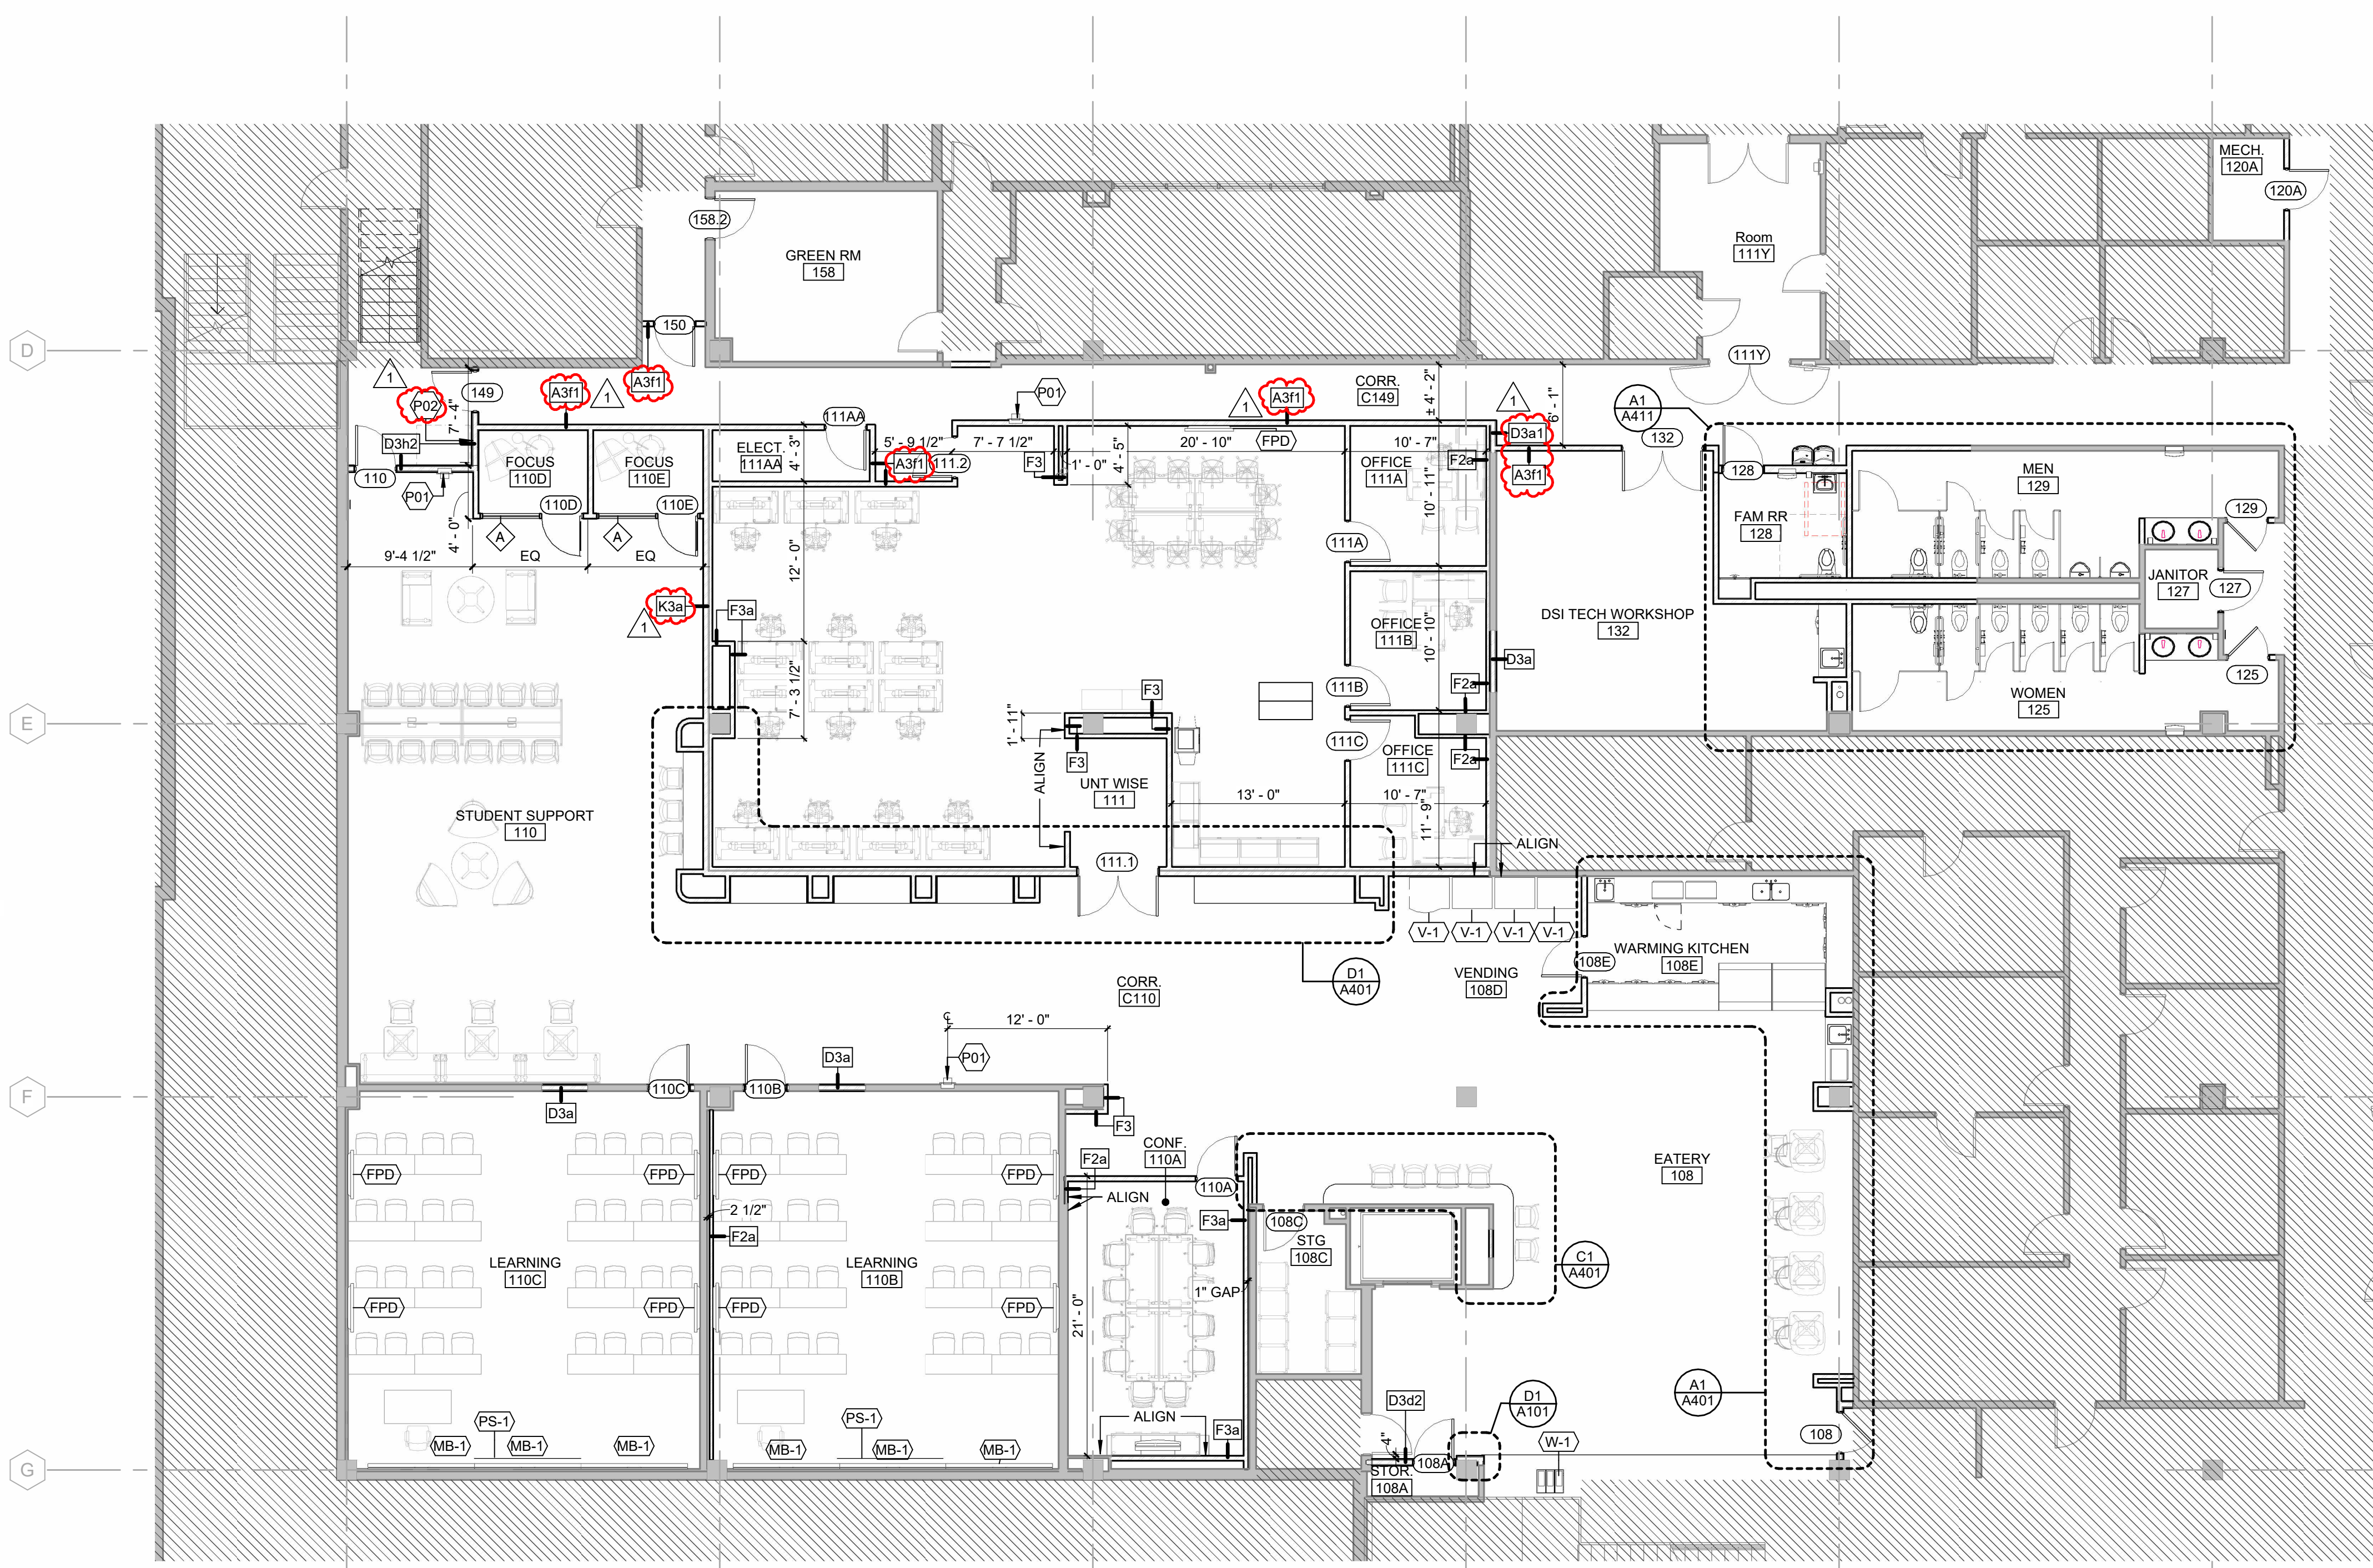

FLOOR PLAN NOTES

- P01 NEW FIRE EXTINGUISHER CABINET
P02 2-WAY COMMUNICATION, REF. TECH. & MEP

UNIVERSITY OF NORTH TEXAS

CHILTON HALL LEVEL 1 RENOVATION

410 Avenue C
Denton, Texas 76201



This drawing is an instrument of service and shall remain the property of Treanor. This drawing and the concepts and ideas contained herein shall not be used, reproduced, revised, or related without the express written approval of Treanor, unless the Architect-Client agreement requires otherwise. Submission or distribution of this drawing to meet official or regulatory requirements or for other purposes in connection with this project is not to be construed as a violation or derogation of any of the rights of Treanor.

Issued For: CONSTRUCTION

Date: 01/16/2025

REVISIONS		
NO	DESCRIPTION	DATE
1	ADDENDUM 1	02/27/2025

A101



FLOOR PLAN - LEVEL 1

Treanor NO. HE0569.2401.00




Autodesk Docs\\HE0569\\2401.00 UNT Chilton Hall Level 1 Renovation\\Chilton Hall Level 1 Renovation_1504_Arch.rvt


2/27/2025 7:02:41 AM

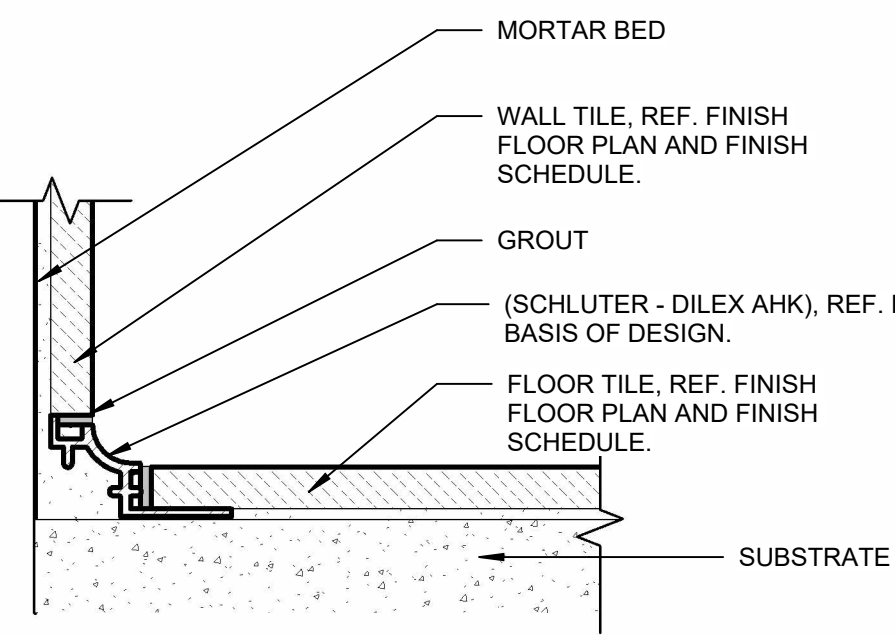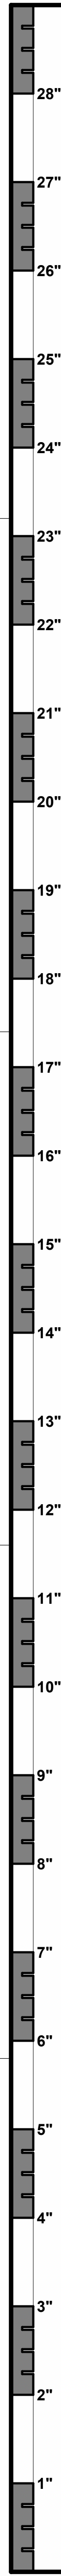


WALL/FLOOR TILE TRANSITION A5
12" = 1'-0"

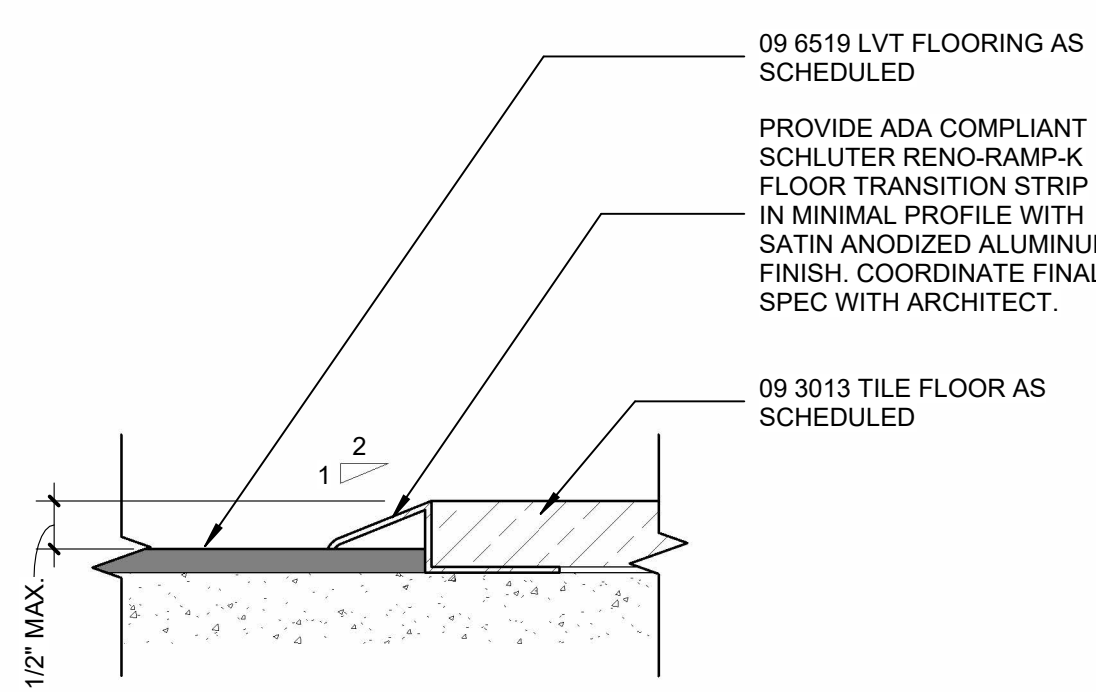


LVT TO TILE A4
12" = 1'-0"

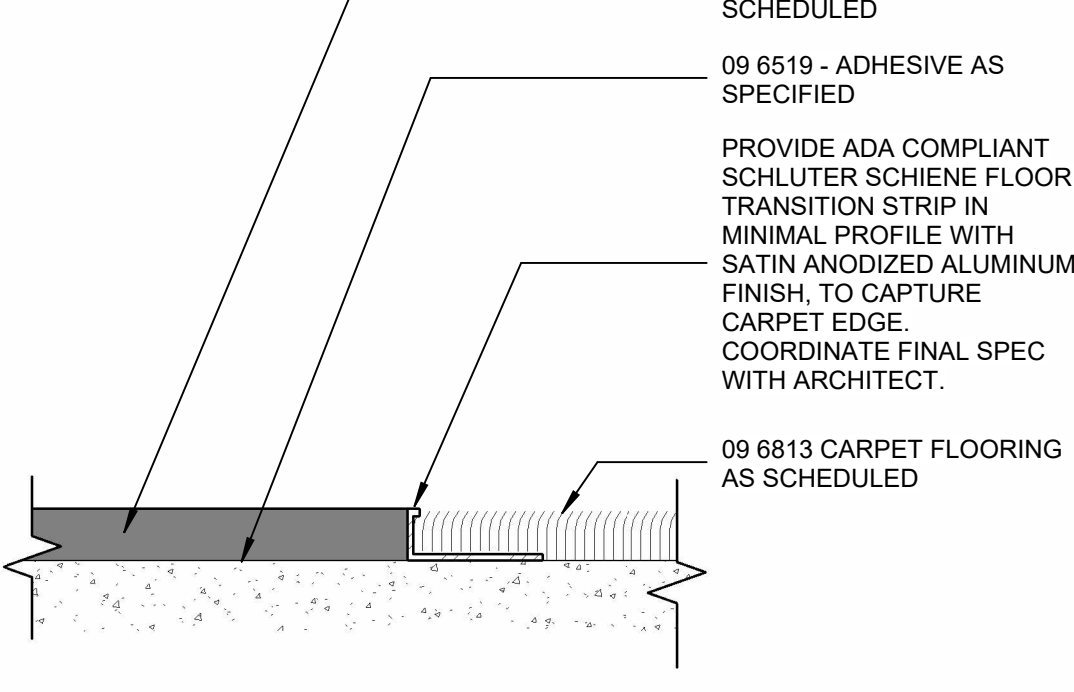


CARPET TO LVT A3
12" = 1'-0"

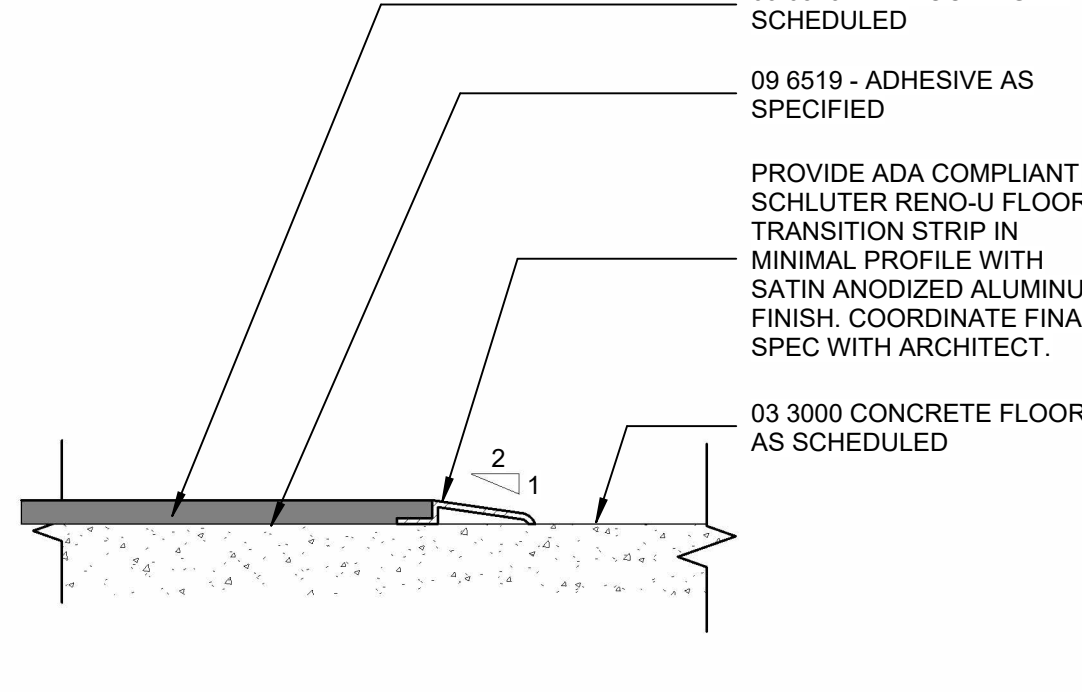


CONCRETE TO LVT A2
12" = 1'-0"

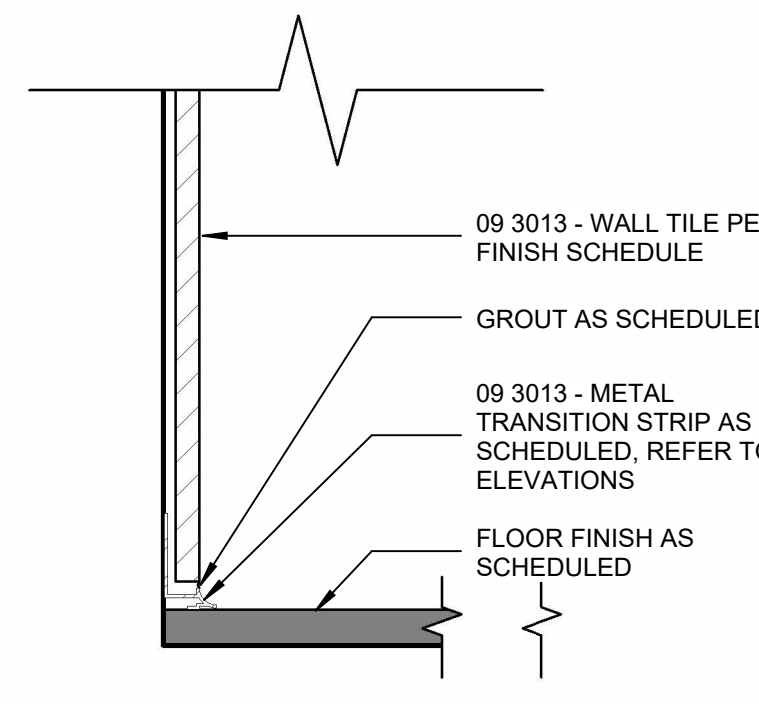

BASE AT TILE WALL A1
6" = 1'-0"

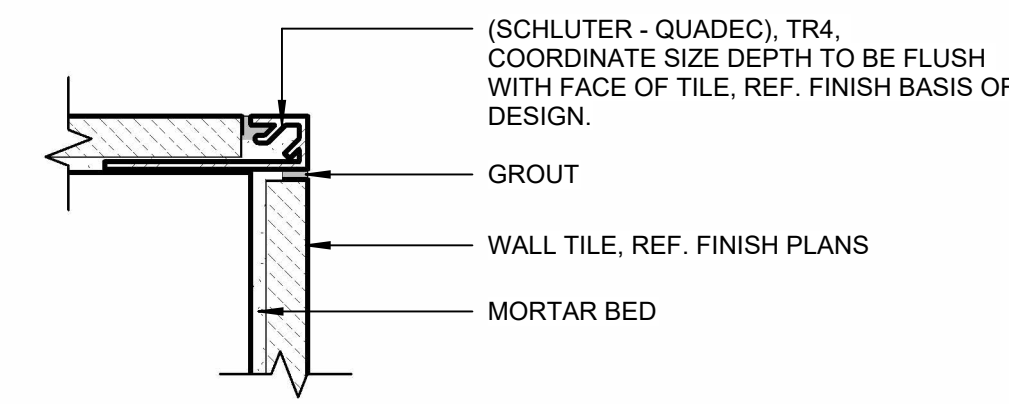

WALL TILE OUTSIDE CORNER TRIM B3
12" = 1'-0"

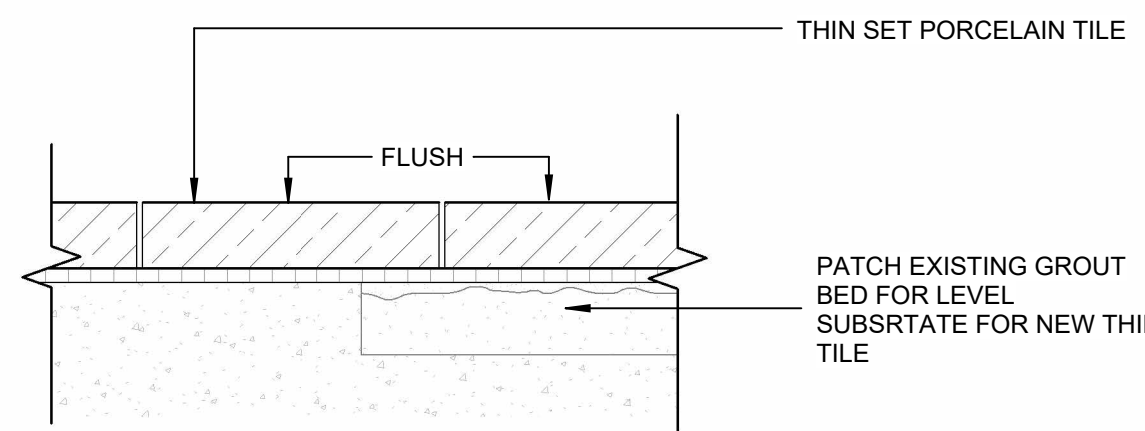

DETAIL AT RESTROOM FLOOR TILE B1
12" = 1'-0"

A700 - BASIS-OF-DESIGN INTERIOR FINISHES				
KEY NAME	MATERIAL	MANUFACTURER	STYLE / COLOR / SIZE	REMARKS
FLOOR FINISH				
CPT-1	CARPET TILE	EF CONTRACT	SPECTRAL DRIFT SDF38 VIRIDIAN	
CPT-2	CARPET TILE	INTERFACE	COLLECTION: WOOVEN GRADIENCE - COLOR: WG100 - 108058 PINE	
LVT-1	LUXURY VINYL PLANK	EF CONTRACT	PLATEAU 2.5mm - EARTH	
LVT-2	LUXURY VINYL PLANK	EF CONTRACT	PLATEAU 2.5mm - UMBRA	
PFT-1	PORCELAIN FLOOR TILE	DALTILE	COLLECTION: FABRIQUE - COLOR: GRIS LINEN P880 - RECTANGLE 12X24	
QFT-1	QUARRY FLOOR TILE	DALTILE	ARID GRAY 6"X6"	
SC	SEALED CONCRETE	BASF KURE-N-SEAL OR AQUA-CURE BY EUCLID		REFER TO PROJECT MANUAL FOR SPECS
BASE FINISH				
RB-1	RUBBER BASE	ROPPE	PINNACLE RUBBER BASE - Somber	
WALL FINISHES				
CG-1	CORNER GUARD			REFER TO PROJECT MANUAL FOR SPECS
CT-1	CERAMIC TILE	DALTILE	COLLECTION: MYTHOLOGY - COLOR: CYCLADE RECTANGLE WAVE CREST MY94 - SIZE: 4X12	
CT-2	CERAMIC TILE	DALTILE	COLLECTION: MYTHOLOGY - COLOR: CYCLADE RECTANGLE WAVE CREST MY94 - SIZE: 4X12	
CT-3	CERAMIC TILE	NASCO STONE+TILE	URANO VERDE/ GLOSSY CR-LC-LV-G	
PT-1	INTERIOR PAINT	SHERWIN WILLIAMS	HARMONY - SEMIGLOSS COLOR: SW7636 WHITE ORIGAMI	
PT-2	INTERIOR PAINT	SHERWIN WILLIAMS	HARMONY - EGGSHELL COLOR SW7502 DRY DOCK	
PT-3	INTERIOR PAINT	SHERWIN WILLIAMS	HARMONY - EGGSHELL COLOR SW7502 DRY DOCK	
PT-4	INTERIOR PAINT	SHERWIN WILLIAMS	TBD	AT RM DOOR FRAMES
TR-1	TILE TRIM	SCHLUTER	RONDEC ALUMINUM PROFILE - COLOR: MATTE WHITE - HEIGHT: 10mm [3/8"]	AT RESTROOM WALL CORNERS
TR-2	TILE TRIM	SCHLUTER	DILEX-AHK ALUMINUM PROFILE - FINISH: SATIN ANODIZED - HEIGHT: 10mm	AT RESTROOM INSIDE WALL CORNERS AND WALL/FLOOR TRANSITIONS
VWC-1	VINYL WALL COVERING	MAHARAM	CASCADE -399852-008 AVOCADO	
VWC-2	VINYL WALL COVERING	MAHARAM	TEK-WALL LUCENT - 009 ALOOCASIA	
VWC-3	VINYL WALL COVERING	MAHARAM	TEK-WALL LUCENT - 007 RIVERWAY	
WP-1	WOOD SLAT PANELING	SURFACING SOLUTION	332 - WIRE BRUSHED WHITE OAK FLEXIBLE WOOD TAMBOUR - CLEAR POLYURETHANE FINISH	
CEILING FINISHES				
APC-1	2X2 ACOUSTICAL PANEL CEILING	ARMSTRONG COMMERCIAL	OPTIMA / WHITE / 24" x 24"	NRC .95
GPC-1	GYPSUM BOARD CEILING			
SAB-1	SUSPENDED ACOUSTICAL BAFFLES	MPS ACOUSTICS	EDGE CEILING BAFFLES - 7" H - PROFILE: CLASSIC - COLOR: MAIN STREET ELM	INSTALLATION HEIGHT: 9' 6" AFF. CONSULT WITH OWNER/ARCHITECT FOR FINAL LAYOUT
SAB-2	SUSPENDED ACOUSTICAL BAFFLES	MPS ACOUSTICS	LONDE CEILING BAFFLES - 7 3/4" H - COLOR: OCEAN	INSTALLATION HEIGHT: 9' 6" AFF. CONSULT WITH OWNER/ARCHITECT FOR FINAL LAYOUT
WSC-1	WOOD SLAT CEILING SYSTEM	ARMSTRONG COMMERCIAL	WOODWORKS GRILLE - FORTE SOLID WAL PANELS GRILLE	
MILLWORK FINISHES				
PLAM-1	PLASTIC LAMINATE	FORMICA	HPL COLLECTION - COLOR: NATURAL ASH - WOODBRUSH	
PLAM-2	PLASTIC LAMINATE	FORMICA	FENIX - COLOR: BIANCO MALE	
PLAM-3	PLASTIC LAMINATE	FORMICA	LAMINATE ANTIMICROBIAL COLLECTION - COLOR: 961A FOG ANTIMICROBIAL	
SS-1	SOLID SURFACE	ZODIAQ	MARBLE MIST	
SS-2	SOLID SURFACE	ZODIAQ	HI-MACS, COLOR:MOON DUST	
WINDOW TREATMENTS				
PF1	PRIVACY FILM	SOLYX	PATTERN: SX-6100 CHICAGO	

TREANOR

2554 Elm Street, Suite 200
Dallas, TX 75226
Phone: 214.752.0118
www.treanor.design

UNIVERSITY OF NORTH TEXAS
CHILTON HALL LEVEL 1 RENOVATION
410 Avenue C
Denton, Texas 76201



This drawing is an instrument of service and shall remain the property of Treanor. This drawing and the concepts and ideas contained herein shall not be used, reproduced, revised, or related without the express written approval of Treanor, unless the Architect-Client agreement requires otherwise.
Submission or distribution of this drawing to meet official or regulatory requirements or for other purposes in connection with this project is not to be construed as publication in derogation of any of the rights of Treanor.

Issued For: ISSUE FOR CONSTRUCTION
Date: 01/16/2025

REVISIONS		
NO	DESCRIPTION	DATE
1	ADDENDUM 1	02/27/2025

A701


FINISH SCHEDULE

Treanor NO. HE0569.2401.00


2/27/2025 7:02:47 AM Autodesk Docs\\HE0569 2401.00 UNT Chilton Hall Level 1 Renovation\\Chilton Hall Level 1 Renovation_1024_Arch.rvt

E 28" 27" 26" 25" 24" 23" 22" 21" 20" 19" 18" 17" 16" 15" 14" 13" 12" 11" 10" 9" 8" 7" 6" 5" 4" 3" 2" 1"

A602 - DOOR AND FRAME SCHEDULE																	
DOOR NO.	S/PR	DIMENSIONS		TYPE	DOOR		FINISH	FRAME		FINISH	GLASS TYPE	DETAIL			FIRE RATING	HDWR GROUP	REMARKS
		WIDTH	HEIGHT		MAT			MAT				JAMB	HEAD	SILL			
108	S	3'-0"	7'-0"	F	WD	STAIN	S2	HM	PT			B1/A601	B1/A601	B2/A601	90 Min	701R	
108A	S	3'-0"	7'-0"	F	WD	STAIN	S2	HM	PT			B1/A601	B1/A601	B2/A601	90 Min	201C	
108C	S	3'-0"	7'-0"	F	WD	STAIN	S2	HM	PT			B1/A601	B1/A601	B2/A601	90 Min	C201	EXISTING TO REMAIN - ADD ACCESS CONTROL
108E	S	3'-0"	7'-0"	N	WD	STAIN	S2	HM	PT			B1/A601	B1/A601	B2/A601		501C	
110	S	3'-0"	7'-0"	F	WD	STAIN	S2	HM	PT			B1/A601	B1/A601	B2/A601	90 Min	721 RALK	DOORS ONLY (ARMED)
110A	S	3'-0"	7'-0"	N	WD	STAIN	S2	HM	PT			B1/A601	B1/A601	B2/A601		C201AC	ACCESS CONTROL
110B	S	3'-0"	7'-0"	F	WD	STAIN	S2	HM	PT			B1/A601	B1/A601	B2/A601		C201C	ACCESS CONTROL
110C	S	3'-0"	7'-0"	F	WD	STAIN	S2	HM	PT			B1/A601	B1/A601	B2/A601		C201C	ACCESS CONTROL
110D		3'-0"	7'-10"	FG	ALUM/GL	BLACK ANODIZED	-	ALUM/GL	BLACK ANODIZED	-	G-1	B3/A601	B3/A601	-		407A	
110E		3'-0"	7'-10"	FG	ALUM/GL	BLACK ANODIZED	-	ALUM/GL	BLACK ANODIZED	-	G-1	B3/A601	B3/A601	-		401A	
111.1	PR	6'-0"	7'-0"	F	WD	STAIN	S2	HM	PT			B1/A601	B1/A601	B2/A601		AC770	DOOR OPERATOR
111.2	S	3'-0"	7'-0"	F	WD	STAIN	S2	HM	PT			B1/A601	B1/A601	B2/A601	20 Min	501	
111A	S	3'-0"	7'-0"	F	WD	STAIN	S2	HM	PT			B1/A601	B1/A601	B2/A601		103	
111AA	S	3'-0"	7'-0"	F	WD	STAIN	S2	HM	PT			B1/A601	B1/A601	B2/A601	20 Min	201	
111B	S	3'-0"	7'-0"	F	WD	STAIN	S2	HM	PT			B1/A601	B1/A601	B2/A601		103	
111C	S	3'-0"	7'-0"	F	WD	STAIN	S2	HM	PT			B1/A601	B1/A601	B2/A601		103	
111Y	PR	6'-0"	7'-0"	N	WD	STAIN	S2	HM	PT		G-1	B1/A601	B1/A601	B2/A601		004	EXISTING DOOR. ADD NARROW LITE KIT
120A	S	3'-0"	7'-0"	F	WD	STAIN	S2	HM	PT			B1/A601	B1/A601	B2/A601		201C	
125	S	3'-0"	7'-0"	F	WD	STAIN	S2	HM	PT			B1/A601	B1/A601	B2/A601		801	
127	S	3'-0"	7'-0"	F	WD	STAIN	S2	HM	PT			B1/A601	B1/A601	B2/A601		201C	
128	S	3'-0"	7'-0"	F	WD	STAIN	S2	HM	PT			B1/A601	B1/A601	B2/A601	20 Min	301C	
129	S	3'-0"	7'-0"	F	WD	STAIN	S2	HM	PT			B1/A601	B1/A601	B2/A601		801	
132	PR	6'-0"	7'-0"	F	WD	STAIN	S2	HM	PT			B1/A601	B1/A601	B2/A601	20 Min	C200S	ACCESS CONTROL
149	S	3'-0"	7'-0"	F	WD	STAIN	S2	HM	PT			B1/A601	B1/A601	B2/A601	90 Min	721R	
150	S	3'-0"	7'-0"	F	WD	STAIN	S2	HM	PT			B1/A601	B1/A601	B2/A601	20 Min	701	
158.2	S	3'-0"	7'-0"	F	WD	STAIN	S2	HM	PT			B1/A601	B1/A601	B2/A601		101	

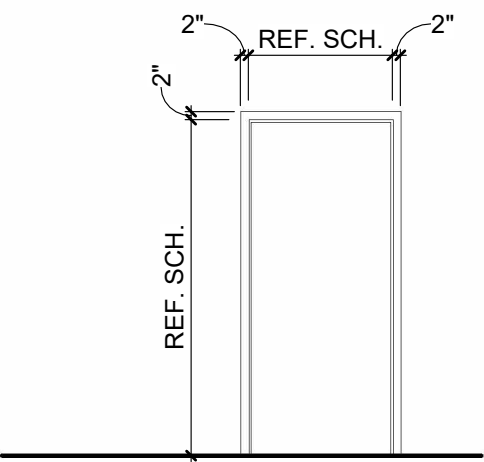

FRAME TYPES
1/4" = 1'-0"

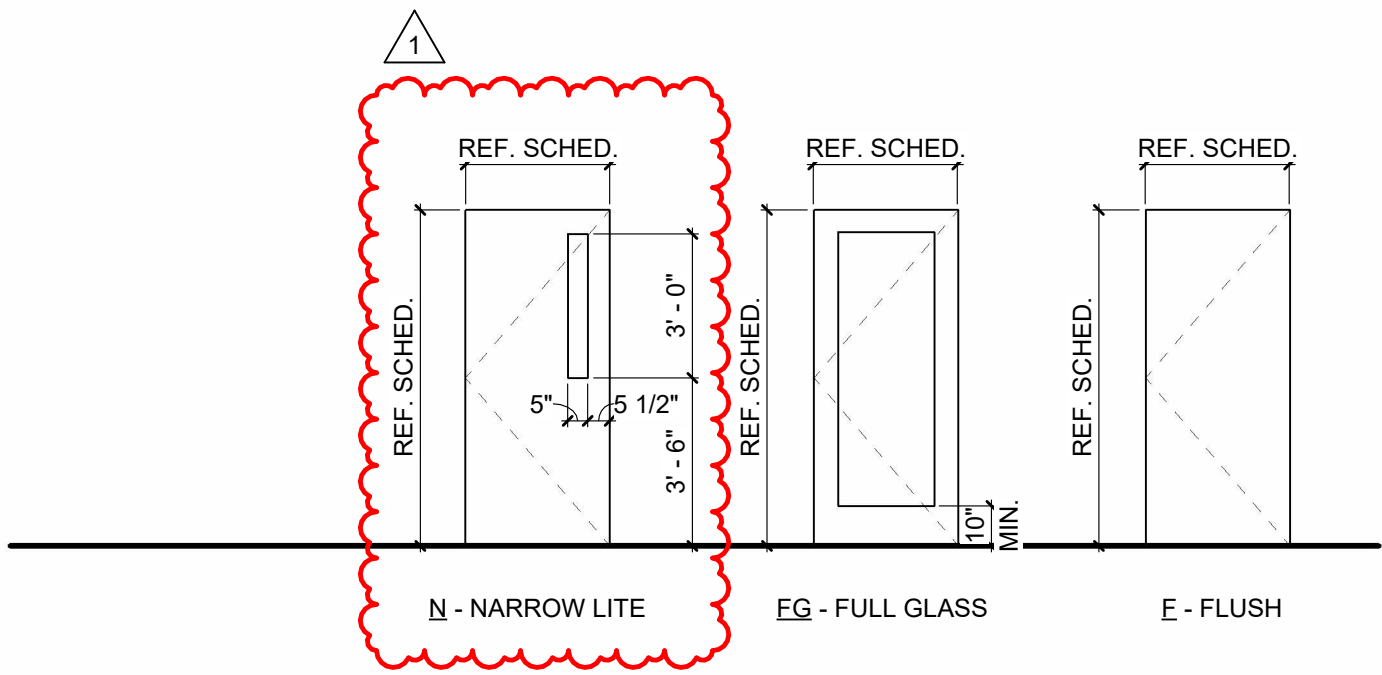

DOOR TYPES
1/4" = 1'-0"

DOOR SCHEDULE NOTES:

- REFER TO AXXX SERIES FOR DOOR HEAD JAMB AND SILL DETAILS.
- ALL DOORS IN SMOKE RESISTANT PARTITIONS TO HAVE POSITIVE LATCHING.
- FIRE-RATING GLAZING IN DOORS SHALL MEET THE FIRE RATING REQUIREMENT OF THE DOORS TO WHICH THEY ARE INSTALLED.
- ALL DOORS TO HAVE BOXED HEADERS UNLESS STEEL CHANNELS ARE INDICATED IN THE REMARKS COLUMN OF THE DOOR SCHEDULE OR UNLESS OTHERWISE INDICATED BY HEAD DETAIL.

DOOR SCHEDULE REMARKS:

- PROVIDE WITH MAGNETIC HOLD OPEN
- VIEW WINDOWS IN LARGER LEAF ONLY
- REFER TO A601 (VIEW WINDOW SCHEDULE) FOR ELEVATION OF INTERIOR DOOR WITH A SIDELIGHT
- AUTOMATIC CARD SWIPE DOOR
- INTEGRAL BLINDS (CONTROLS ON INTERIOR ROOM SIDE ONLY)
- DOOR SWINGS 180°
- DOOR SWINGS BOTH WAYS
- ISOLATION PATIENT ROOM DOOR REQUIRES A CLOSER
- INTEGRATED FIRE DOOR ASSEMBLY
- ALUMINUM FRAMED STOREFRONT, REFER TO A33 SERIES (EXTERIOR GLAZED OPENING SCHEDULE) FOR ELEVATION
- GLAZED ALUMINUM CURTAIN WALL SYSTEM DOORS, REFER TO A33 SERIES (EXTERIOR GLAZED OPENING SCHEDULE) FOR ELEVATION
- PROVIDE STEEL CHANNEL FRAME AT HEAD AND JAMB OF DOOR PER DETAILS X/XXX-XX AND X/XXX-XX
- SECTIONAL OVERHEAD DOOR
- REVOLVING DARK ROOM DOOR
- RADIATION PROTECTION DOOR AND FRAME
- SOUND CONTROL DOOR ASSEMBLY

GLAZING TYPES:

REFER TO SPECIFICATION FOR MORE DETAILS

G-1 1/4" Clear Glass


FG-1 Fire-Protective Glass, 90MIN Fire Rated

NOTE: ALL GLAZING TO BE TEMPERED GLAZING


GLAZING SYSTEM TYPES:

A INTERIOR STOREFRONT SYSTEM


NOTE: ALL OVERALL GLAZING SYSTEM DIMENSIONS ARE TO ROUGH OPENING

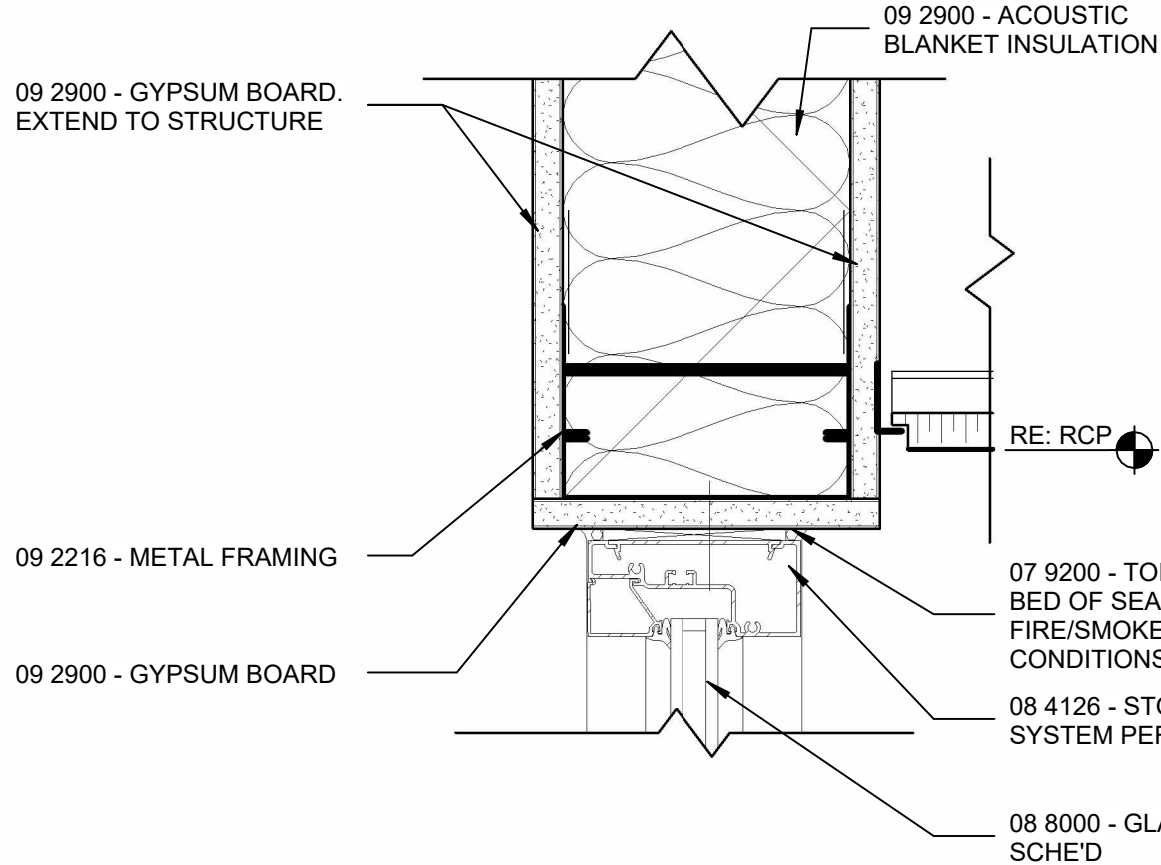

HEAD @ STOREFRONT B3
3" = 1'-0"

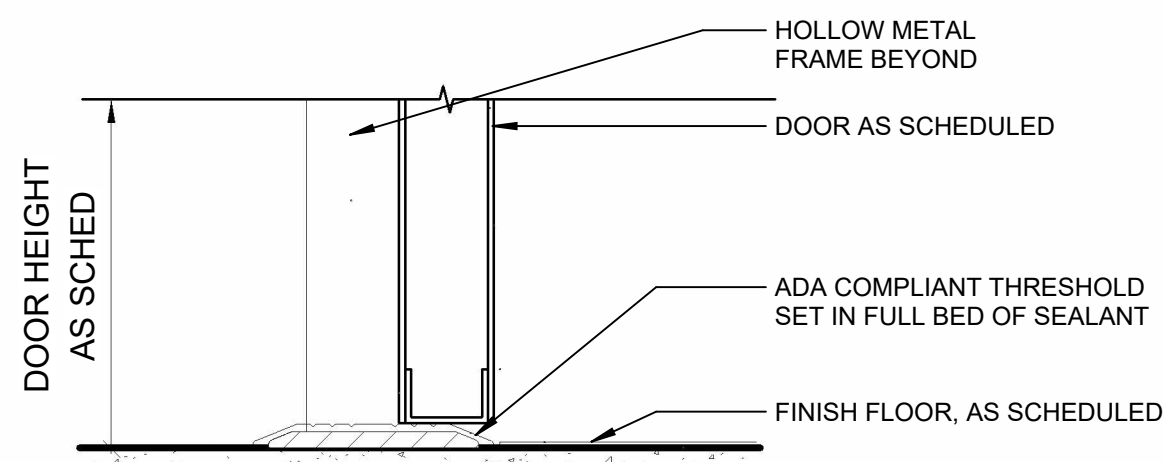

TYP. INTERIOR HM DOOR SILL B2
3" = 1'-0"

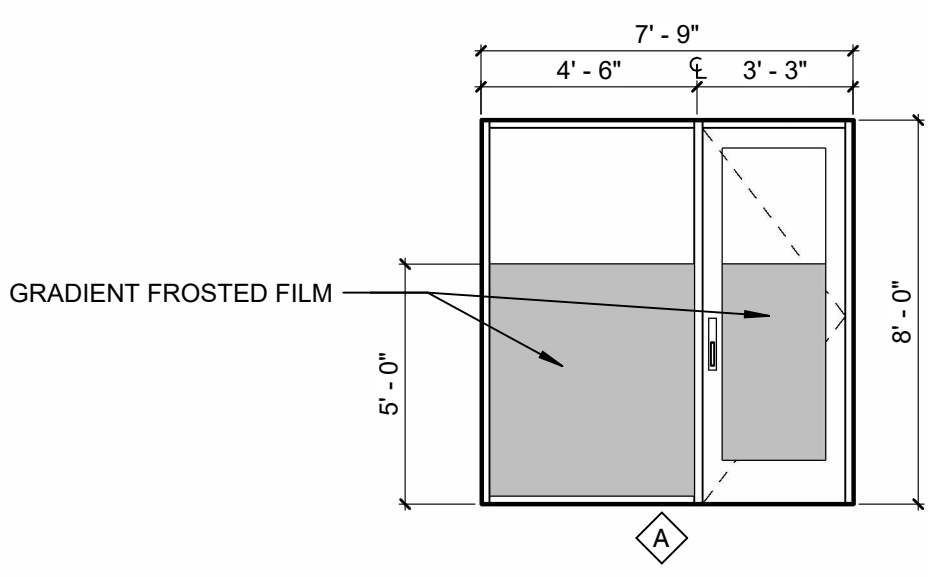

TYP. INTERIOR HM DOOR JAMB/HEAD B1
3" = 1'-0"

EQUIPMENT SCHEDULE							
TAG	EQUIPMENT TYPE	MANUFACTURER	MODEL	DIMENSIONS	COLOR	PROVIDED BY	TYPE COMMENTS
OP-1	COPIER/PRINTER	TRUE MANUFACTURING CO. INC.	TGM-DZ-48-SC-SC-B-W	48"Wx36"Dx49"H		RED	2 UNITS, BOTH ON 4" CASTERS
FDC-1	FOOD DISPLAY CASE					CFCI	
FPD	FLAT PANEL DISPLAY					OPFI	
ICE-1	UNDERCOUNTER ICEMAKER	SCOTSMAN	CU0920	20"Wx24"Dx31.9"H	STANDARD FINISH	CFCI	
MB-1	MARKER BOARD	Steelcase				OFOI	
MI-1	MICROWAVE	GE	PCWK22U1WDD	24"Wx20"Dx14"H	GRAY	CFCI	
PS-1	PROJECTION SCREEN					OFOI	
REF	UNDERCOUNTER REFRIGERATOR	MARVEL	MARE224-SS41A	24"Wx24"Dx31"H	DOOR: STAINLESS STEEL/ SIDES AND TOES: BLACK	CFCI	
V-1	VENDING MACHINE	-				OFOI	
W-1	TRASH/RECYCLE BIN	-				OFOI	

TREANOR

2554 Elm Street, Suite 200
Dallas, TX 75226
Phone: 214.762.0118
www.treanor.com

UNIVERSITY OF NORTH TEXAS
CHILTON HALL LEVEL 1 RENOVATION
410 Avenue C
Denton, Texas 76201



This drawing is an instrument of service and shall remain the property of Treanor. This drawing and the concepts and ideas contained herein shall not be used, reproduced, revised, or related without the express written approval of Treanor, unless the Architect-Client agreement requires otherwise.
Submission or distribution of this drawing to meet official or regulatory requirements or for other purposes in connection with the project is not to be construed as publication in derogation of any of the rights of Treanor.

Issued For: CONSTRUCTION
Date: 01/16/2025


REVISIONS		
NO	DESCRIPTION	DATE
1	ADDENDUM 1	02/27/2025

A601

DOOR, INTERIOR
GLAZING, AND
EQUIPMENT SCHEDULE

Treanor NO. HE0569 2401.00

2/27/2025 7:02:54 AM
Autodesk Docs\\HE0569.2401.00 UNT Chilton Hall Level 1 Renovation\\Chilton Hall Level 1 Renovation_1204_Arch.rvt

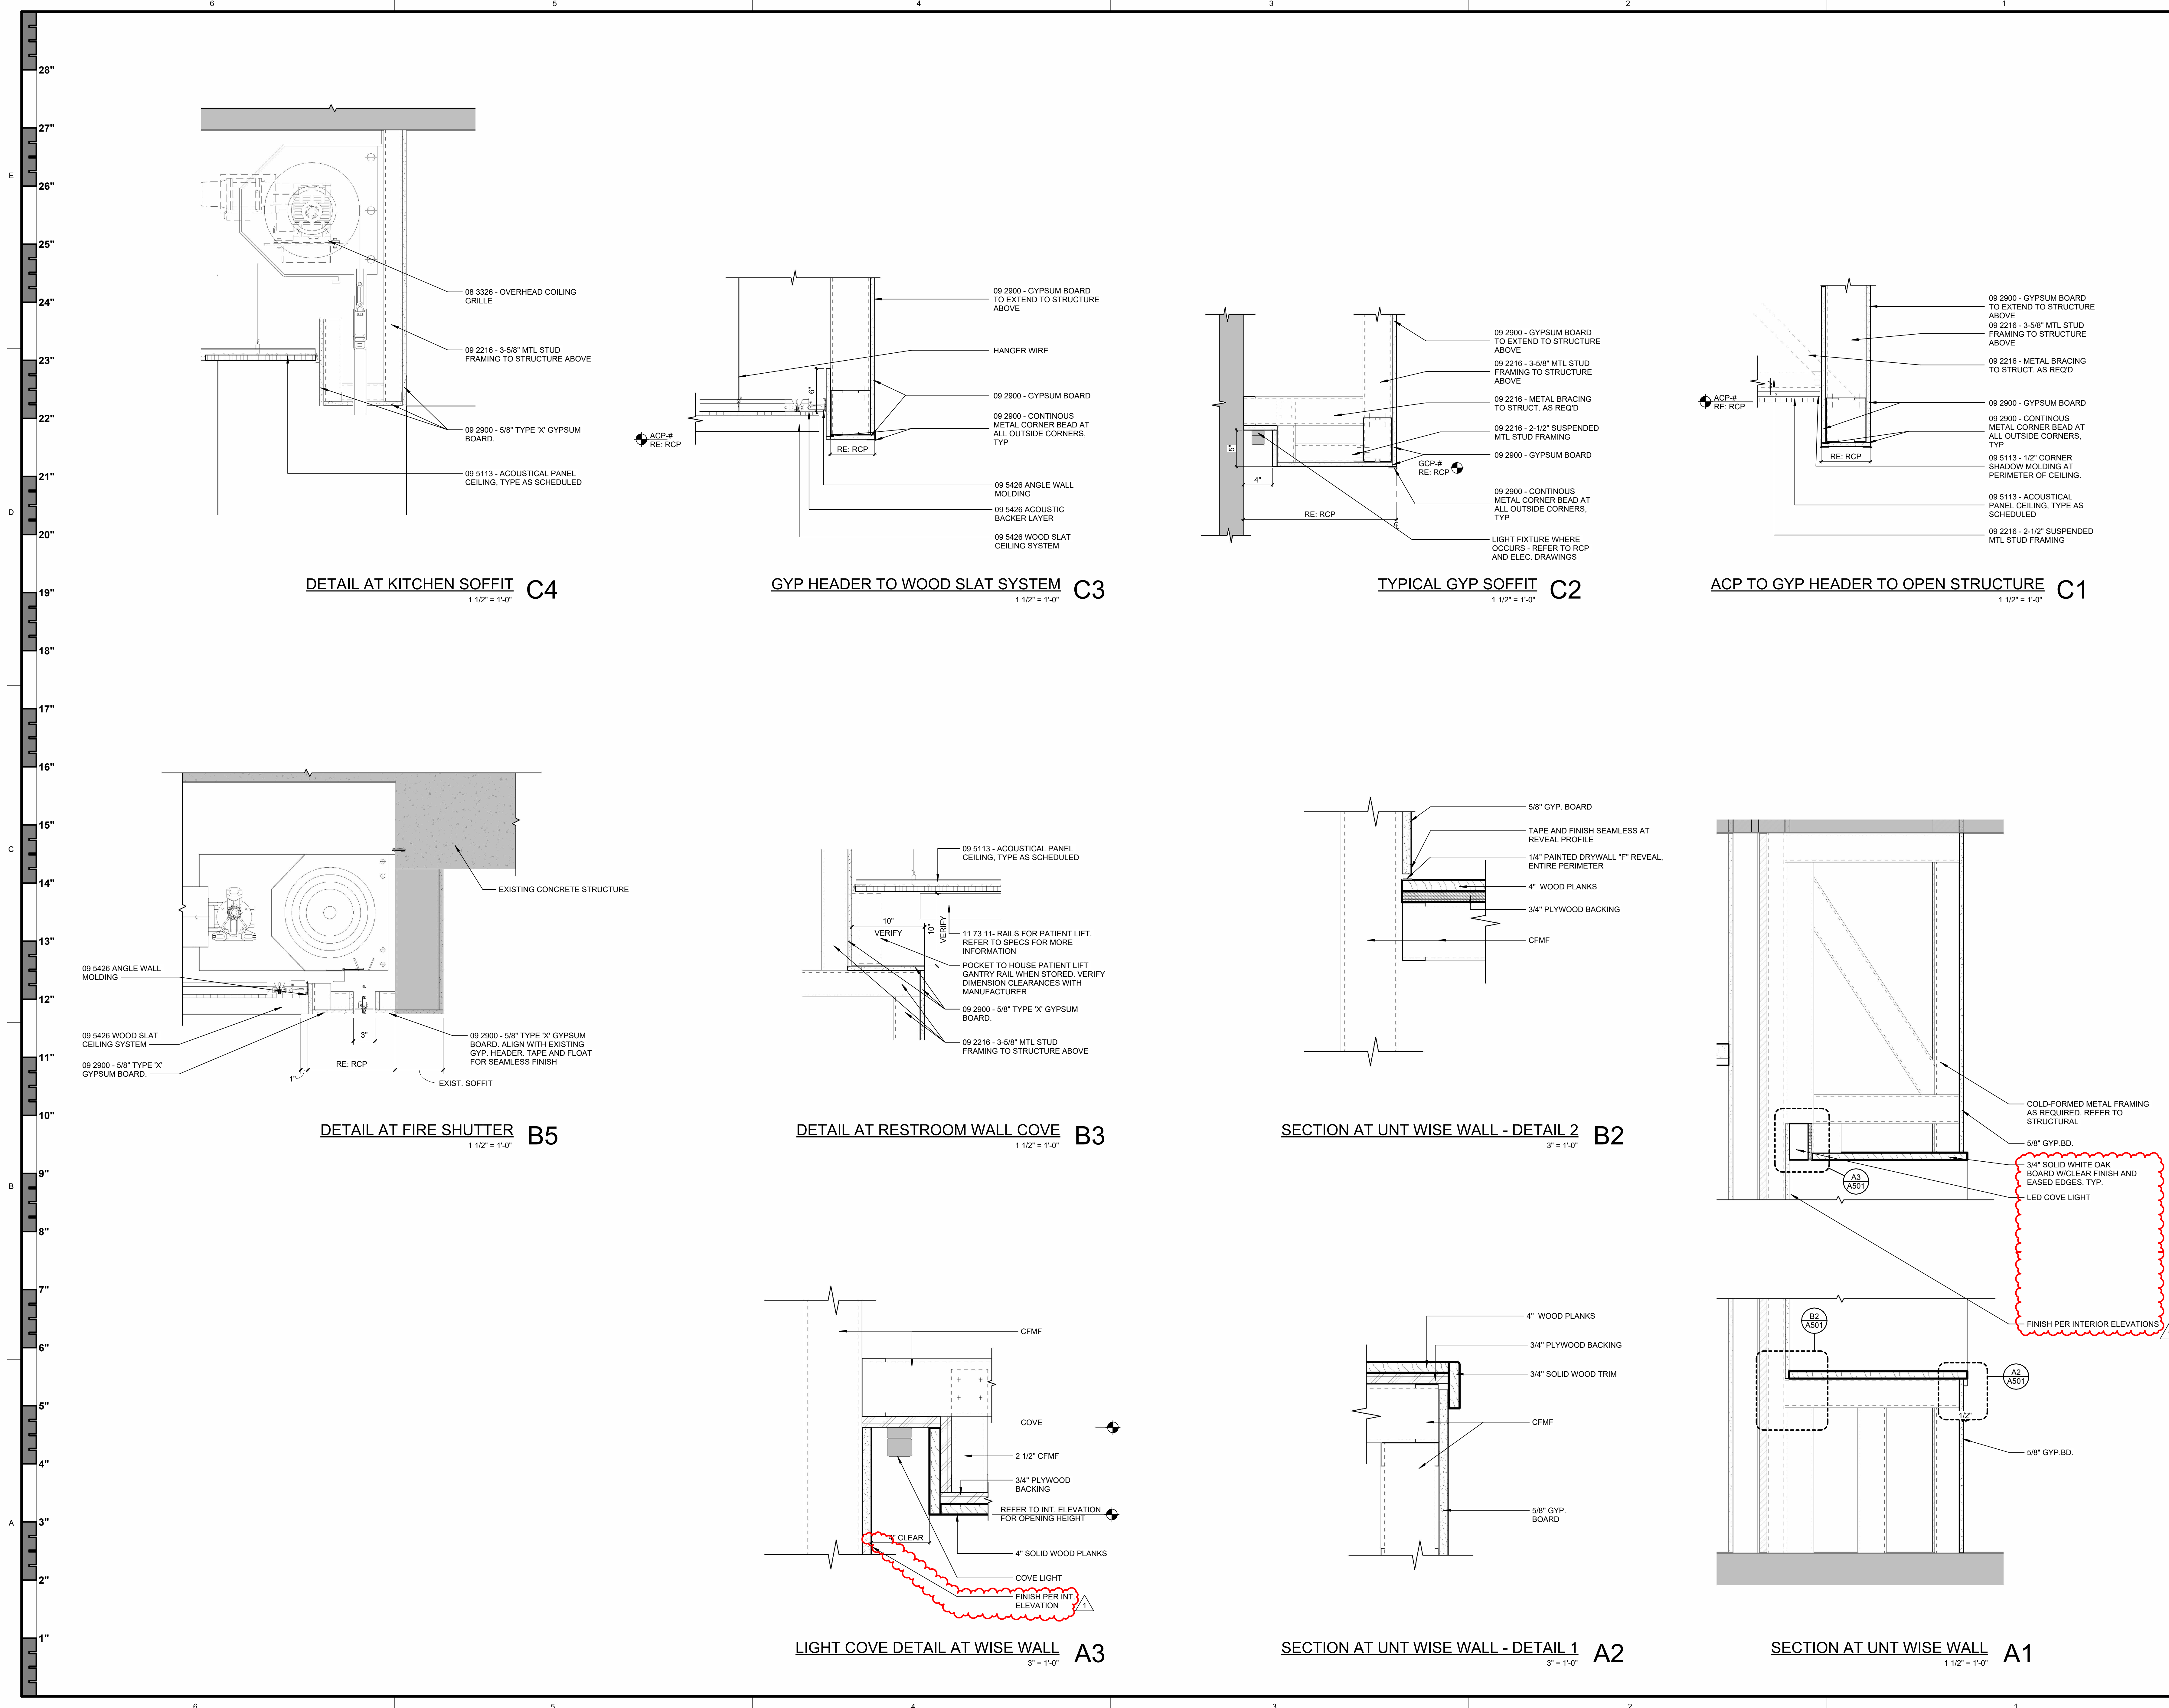

TREANOR

2554 Elm Street, Suite 200
Dallas, TX 75226
P: 214.762.0118
www.treanor.com

UNIVERSITY OF NORTH TEXAS
CHILTON HALL LEVEL 1 RENOVATION
410 Avenue C
Denton, Texas 76201



This drawing is an instrument of service and shall remain the property of Treanor. This drawing and the concepts and ideas contained herein shall not be used, reproduced, revised, or retained without the express written approval of Treanor, unless the Architect-Client agreement requires otherwise. Submission or distribution of this drawing to meet official or regulatory requirements or for other purposes in connection with this project is not to be construed as publication in derogation of any of the rights of Treanor.


Issued For: **ISSUE FOR CONSTRUCTION**
Date: 01/16/2025

REVISIONS		
NO	DESCRIPTION	DATE
1	ADDENDUM 1	02/27/2025


A501
INTERIOR DETAILS
Treanor NO. HE0569.2401.00

Autodesk Docs\\HE0569 2401.00 UNT Chilton Hall Level 1 Renovation\\E04_Arch.rvt


2/27/2025 7:03:02 AM

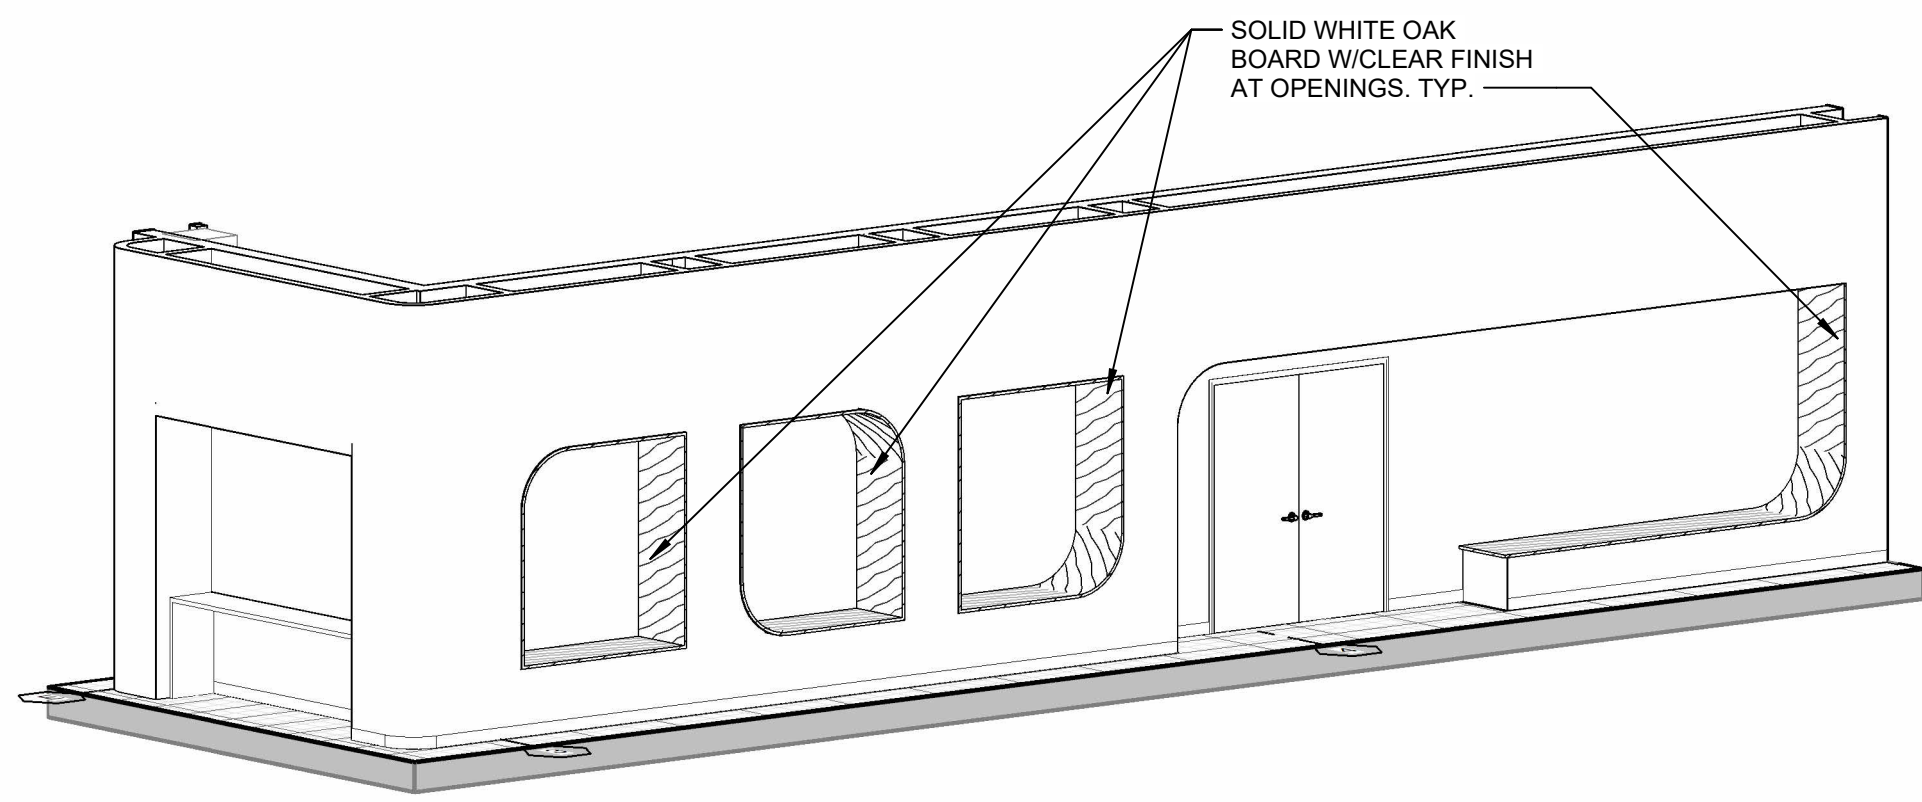


AXON AT SEATING WALL 1

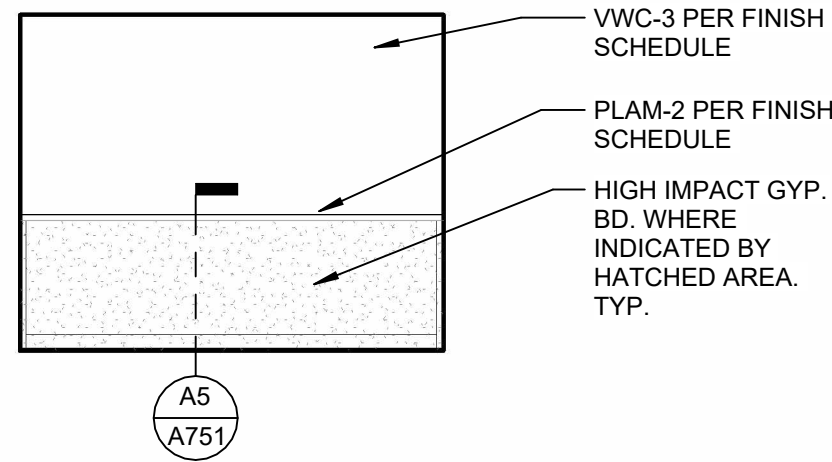


ELEVATION AT SEATING WALL - NORTH D4
1/4" = 1'-0"

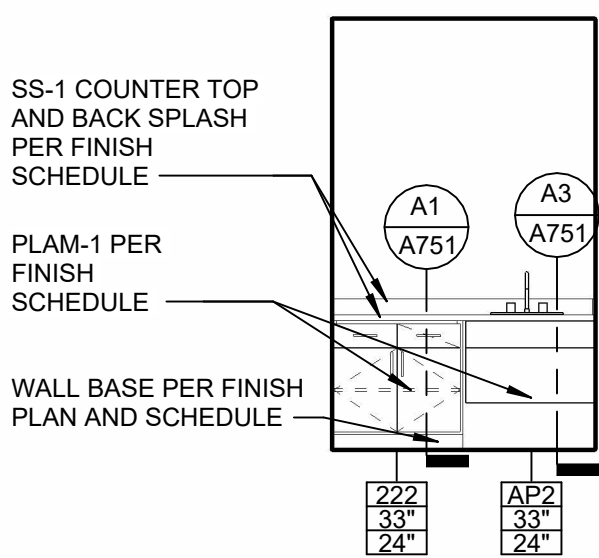


ELEVATION AT DSI MILLWORK C5
1/4" = 1'-0"

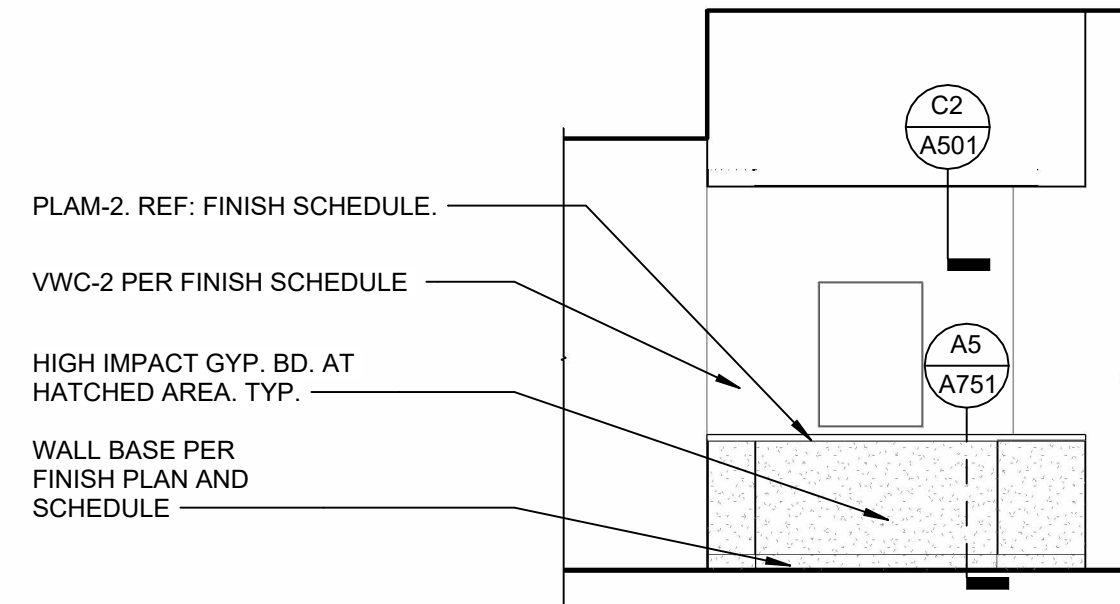


SOUTH INT. ELEVATION - FROM B1 C4
1/4" = 1'-0"

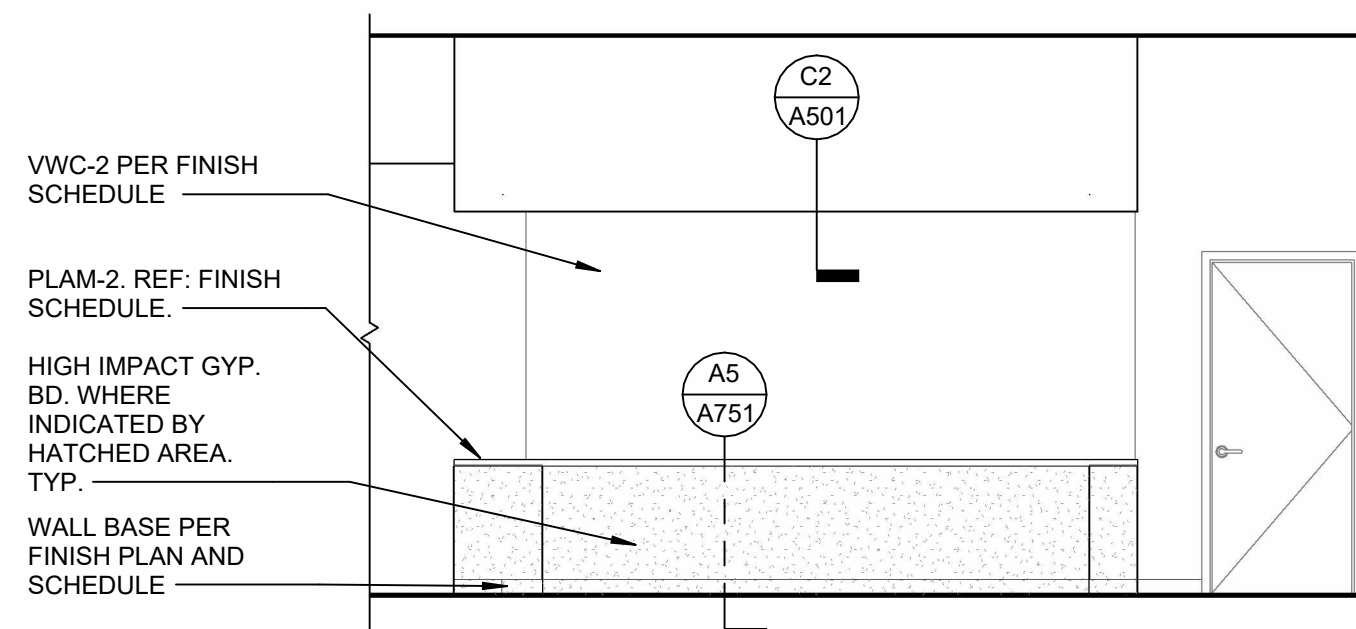


EAST INT. ELEVATION - FROM B1 C2
1/4" = 1'-0"

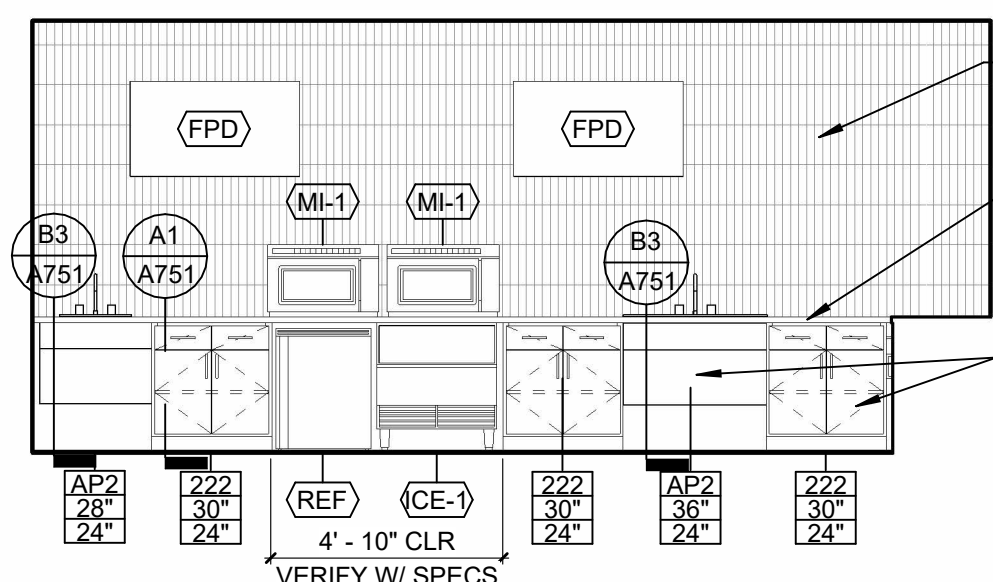


KITCHEN - WEST INT ELEVATION B5
1/4" = 1'-0"

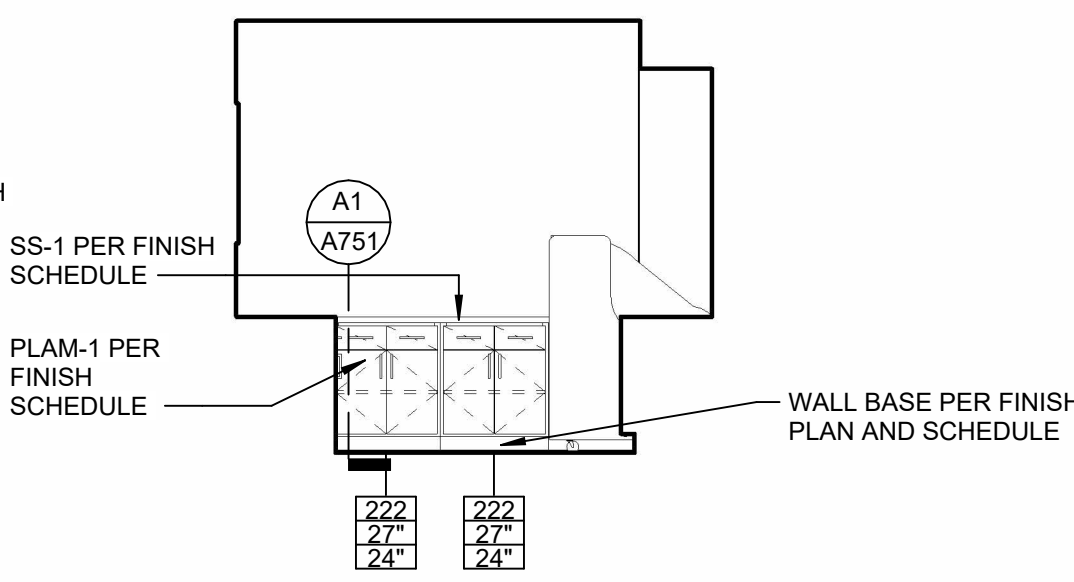


KITCHEN - NORTH INT. ELEVATION B4
1/4" = 1'-0"

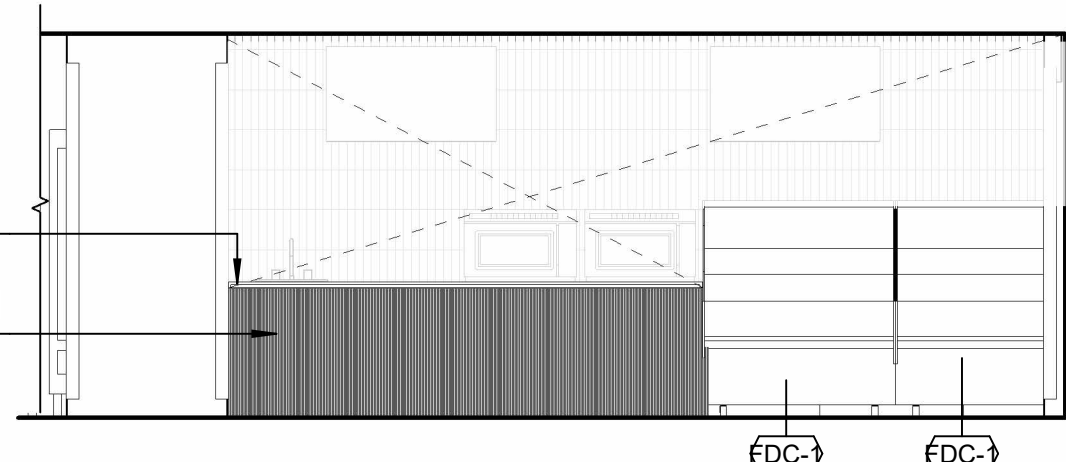


EATERY - WEST INT. ELEVATION B2
1/4" = 1'-0"

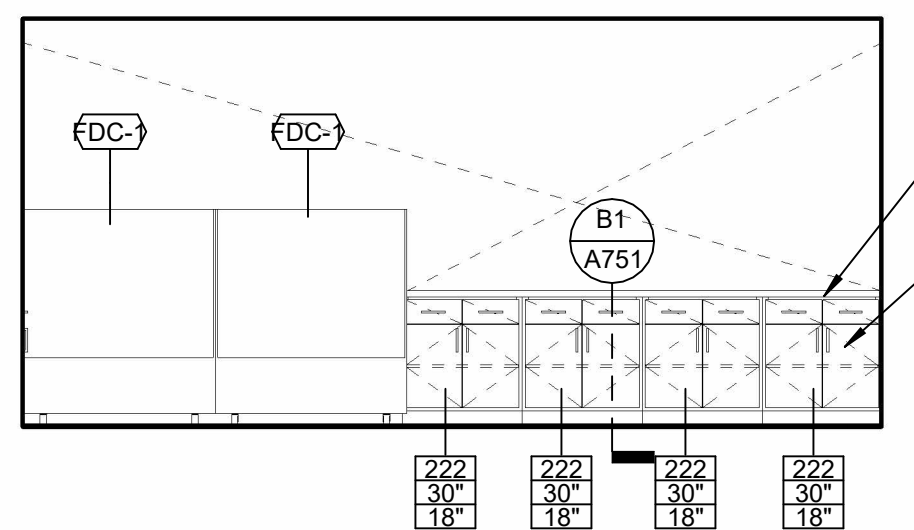


KITCHEN - EAST INT. ELEVATION A5
1/4" = 1'-0"

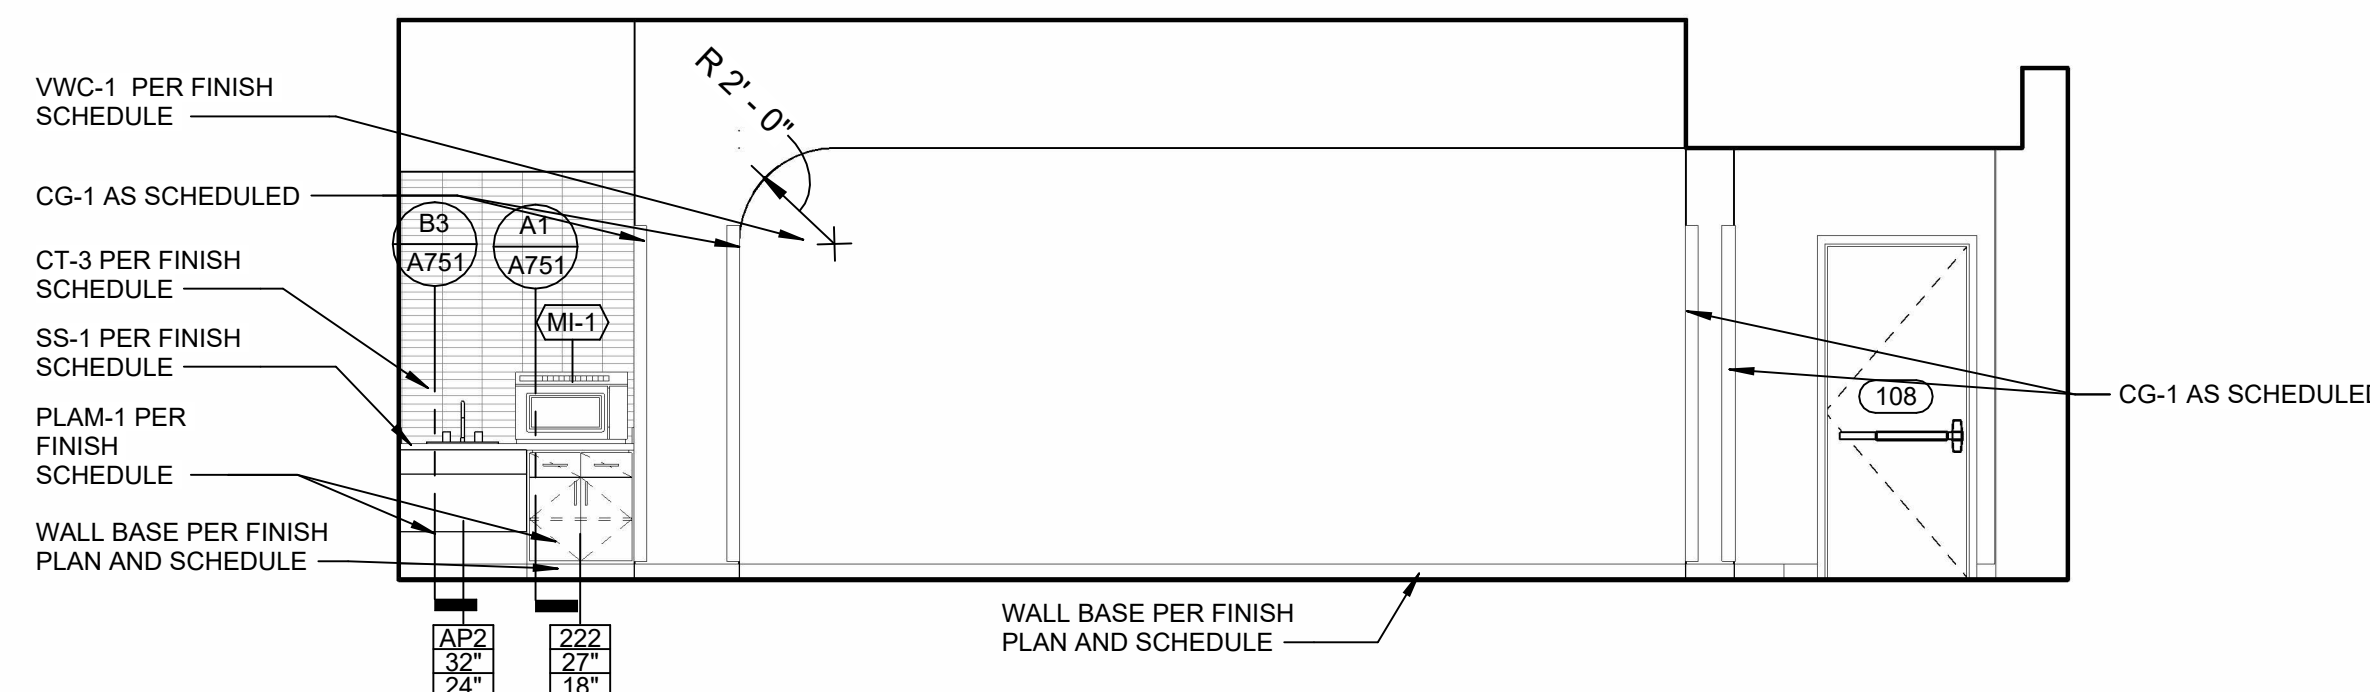


EATERY NORTH INT. ELEVATION A2
1/4" = 1'-0"

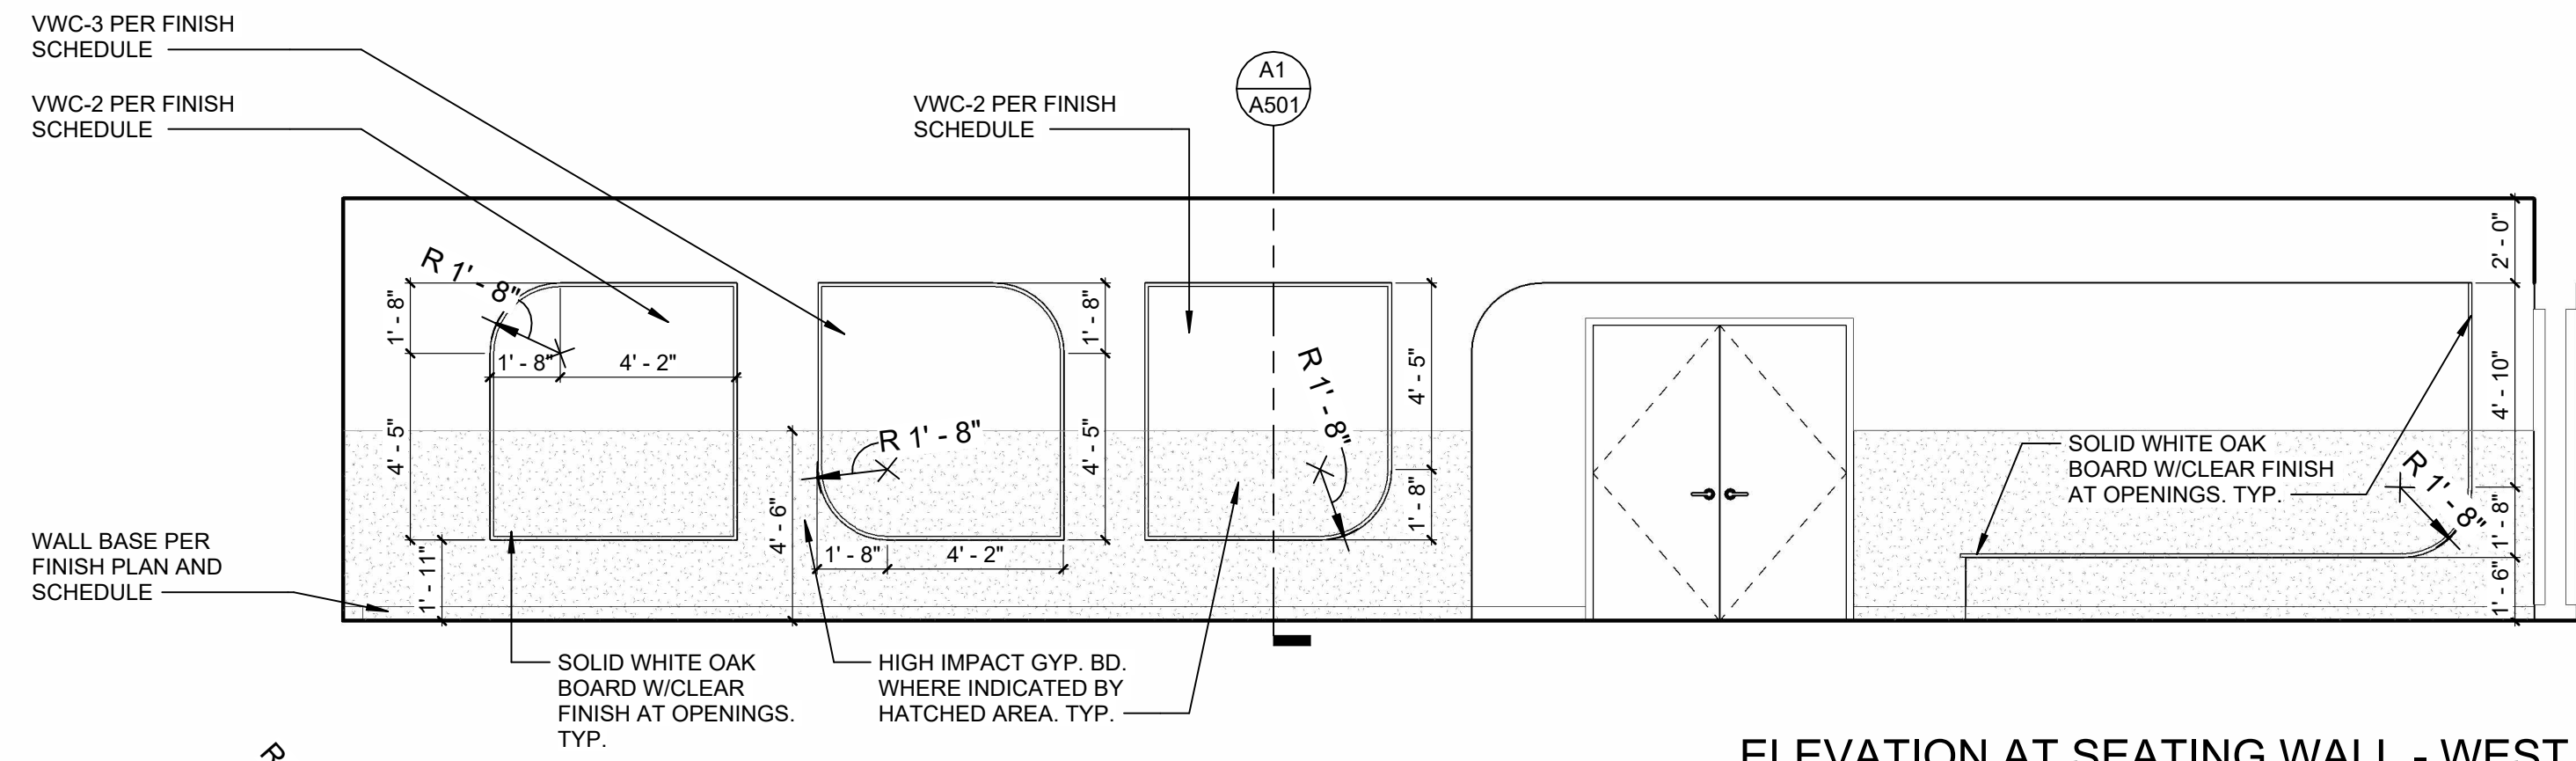


ELEVATION AT SEATING WALL - WEST E1
1/4" = 1'-0"

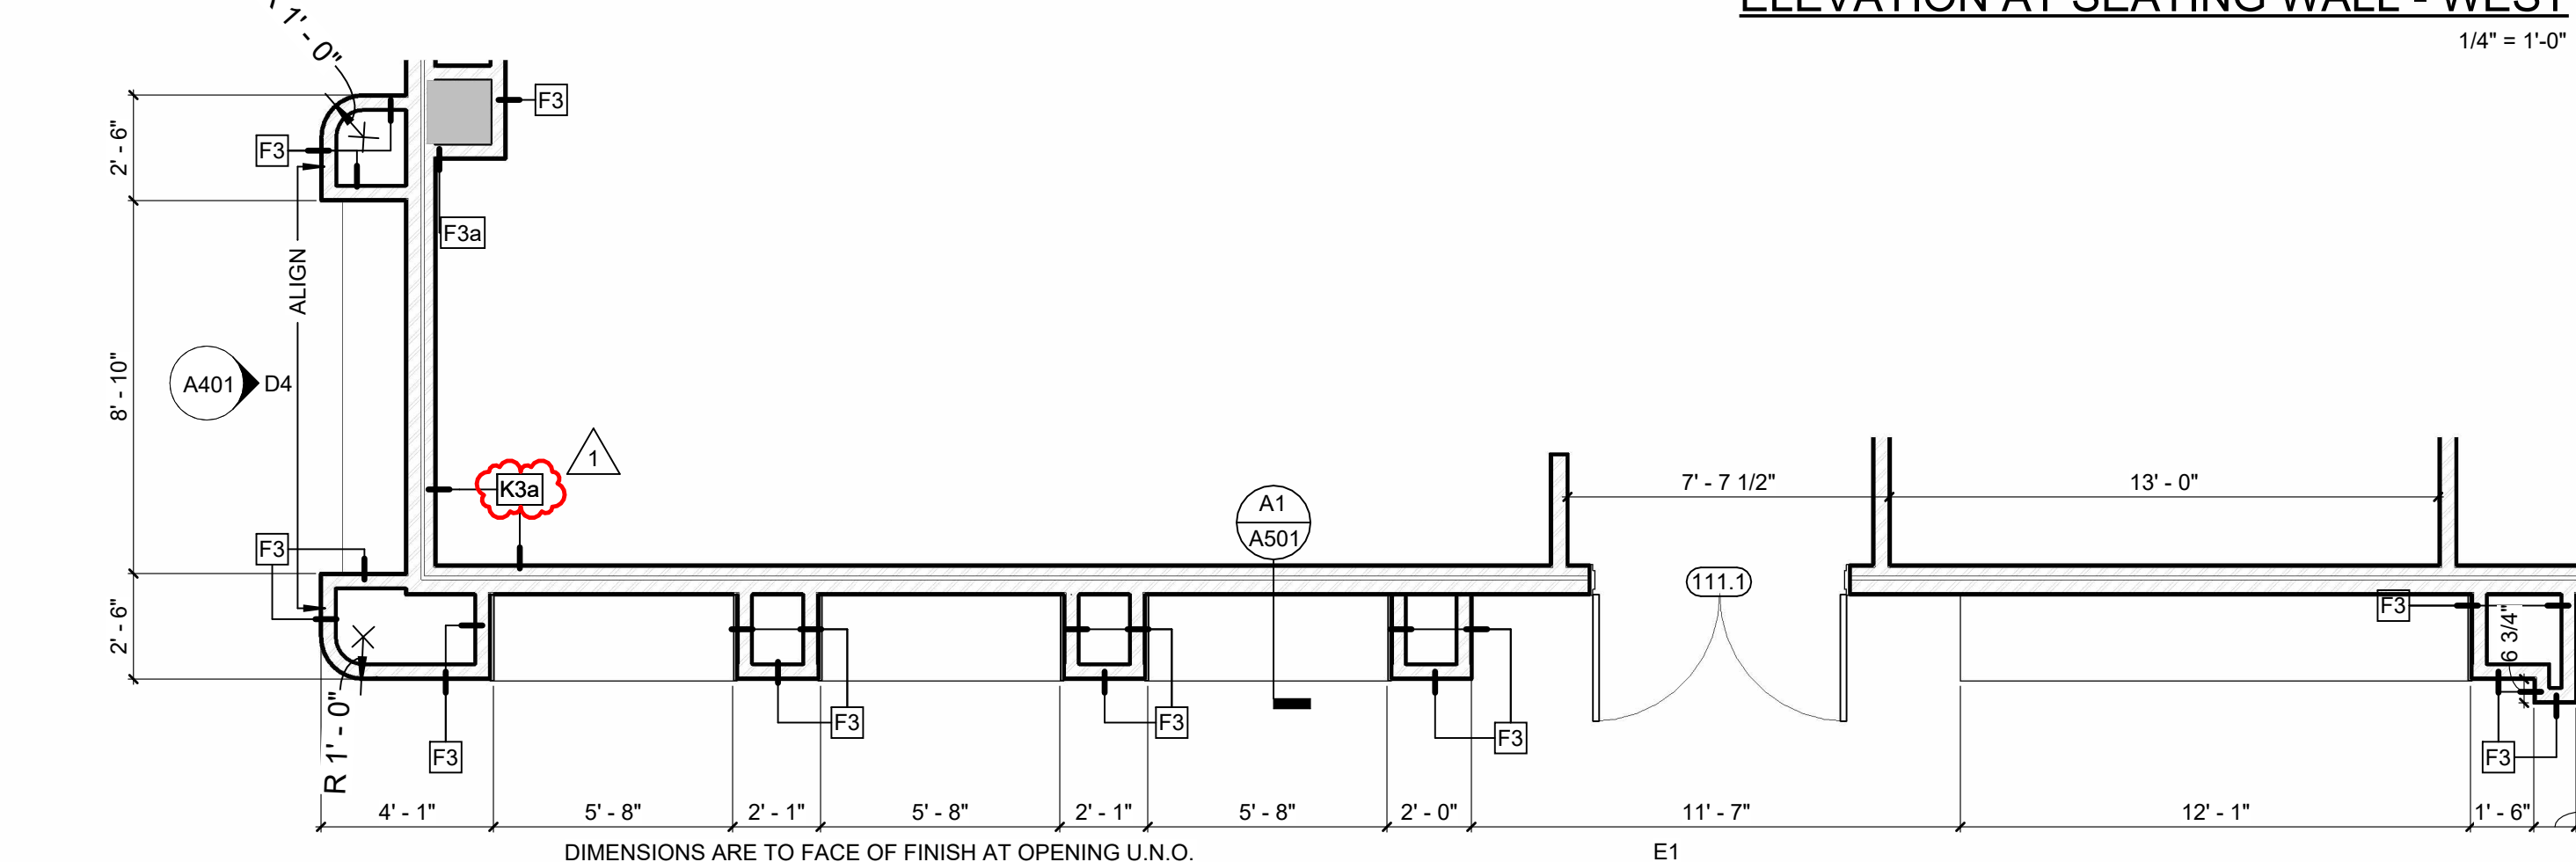


ENLARGED PLAN - SEATING WALL D1
1/4" = 1'-0"

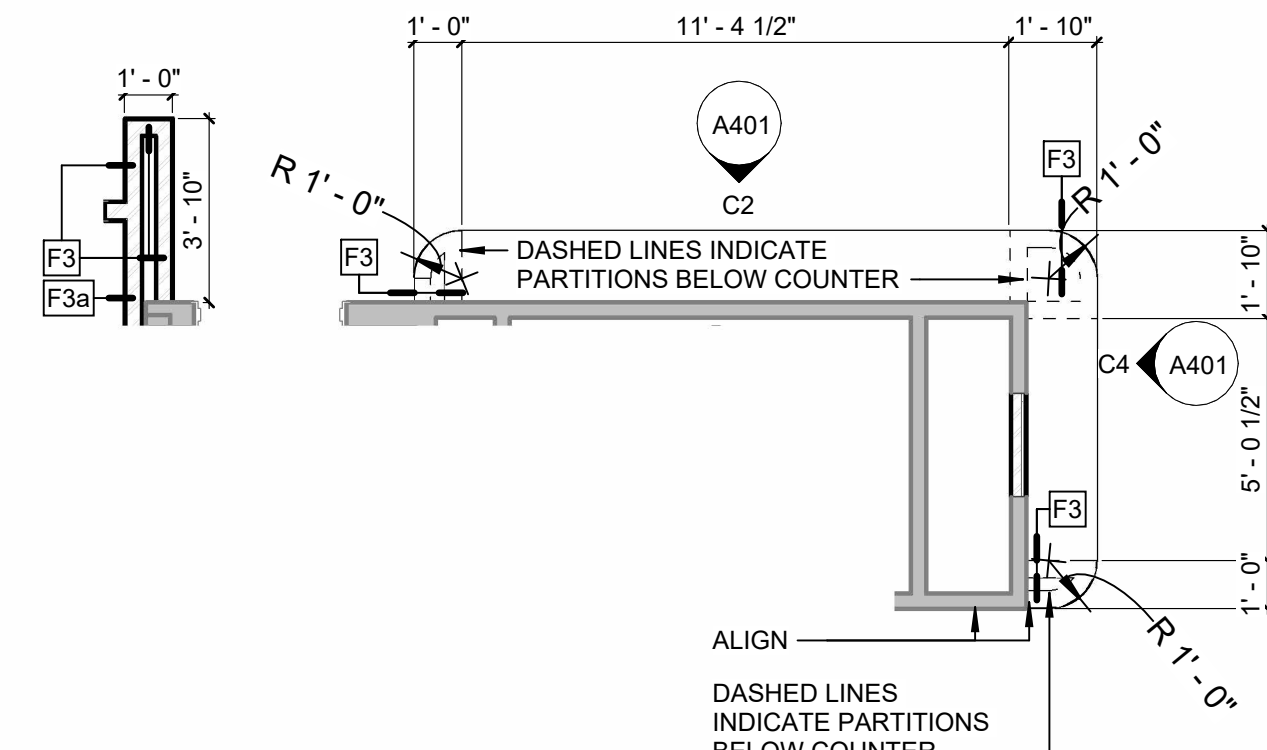


ENLARGED PLAN - CASEWORK AT ENTRY C1
1/4" = 1'-0"

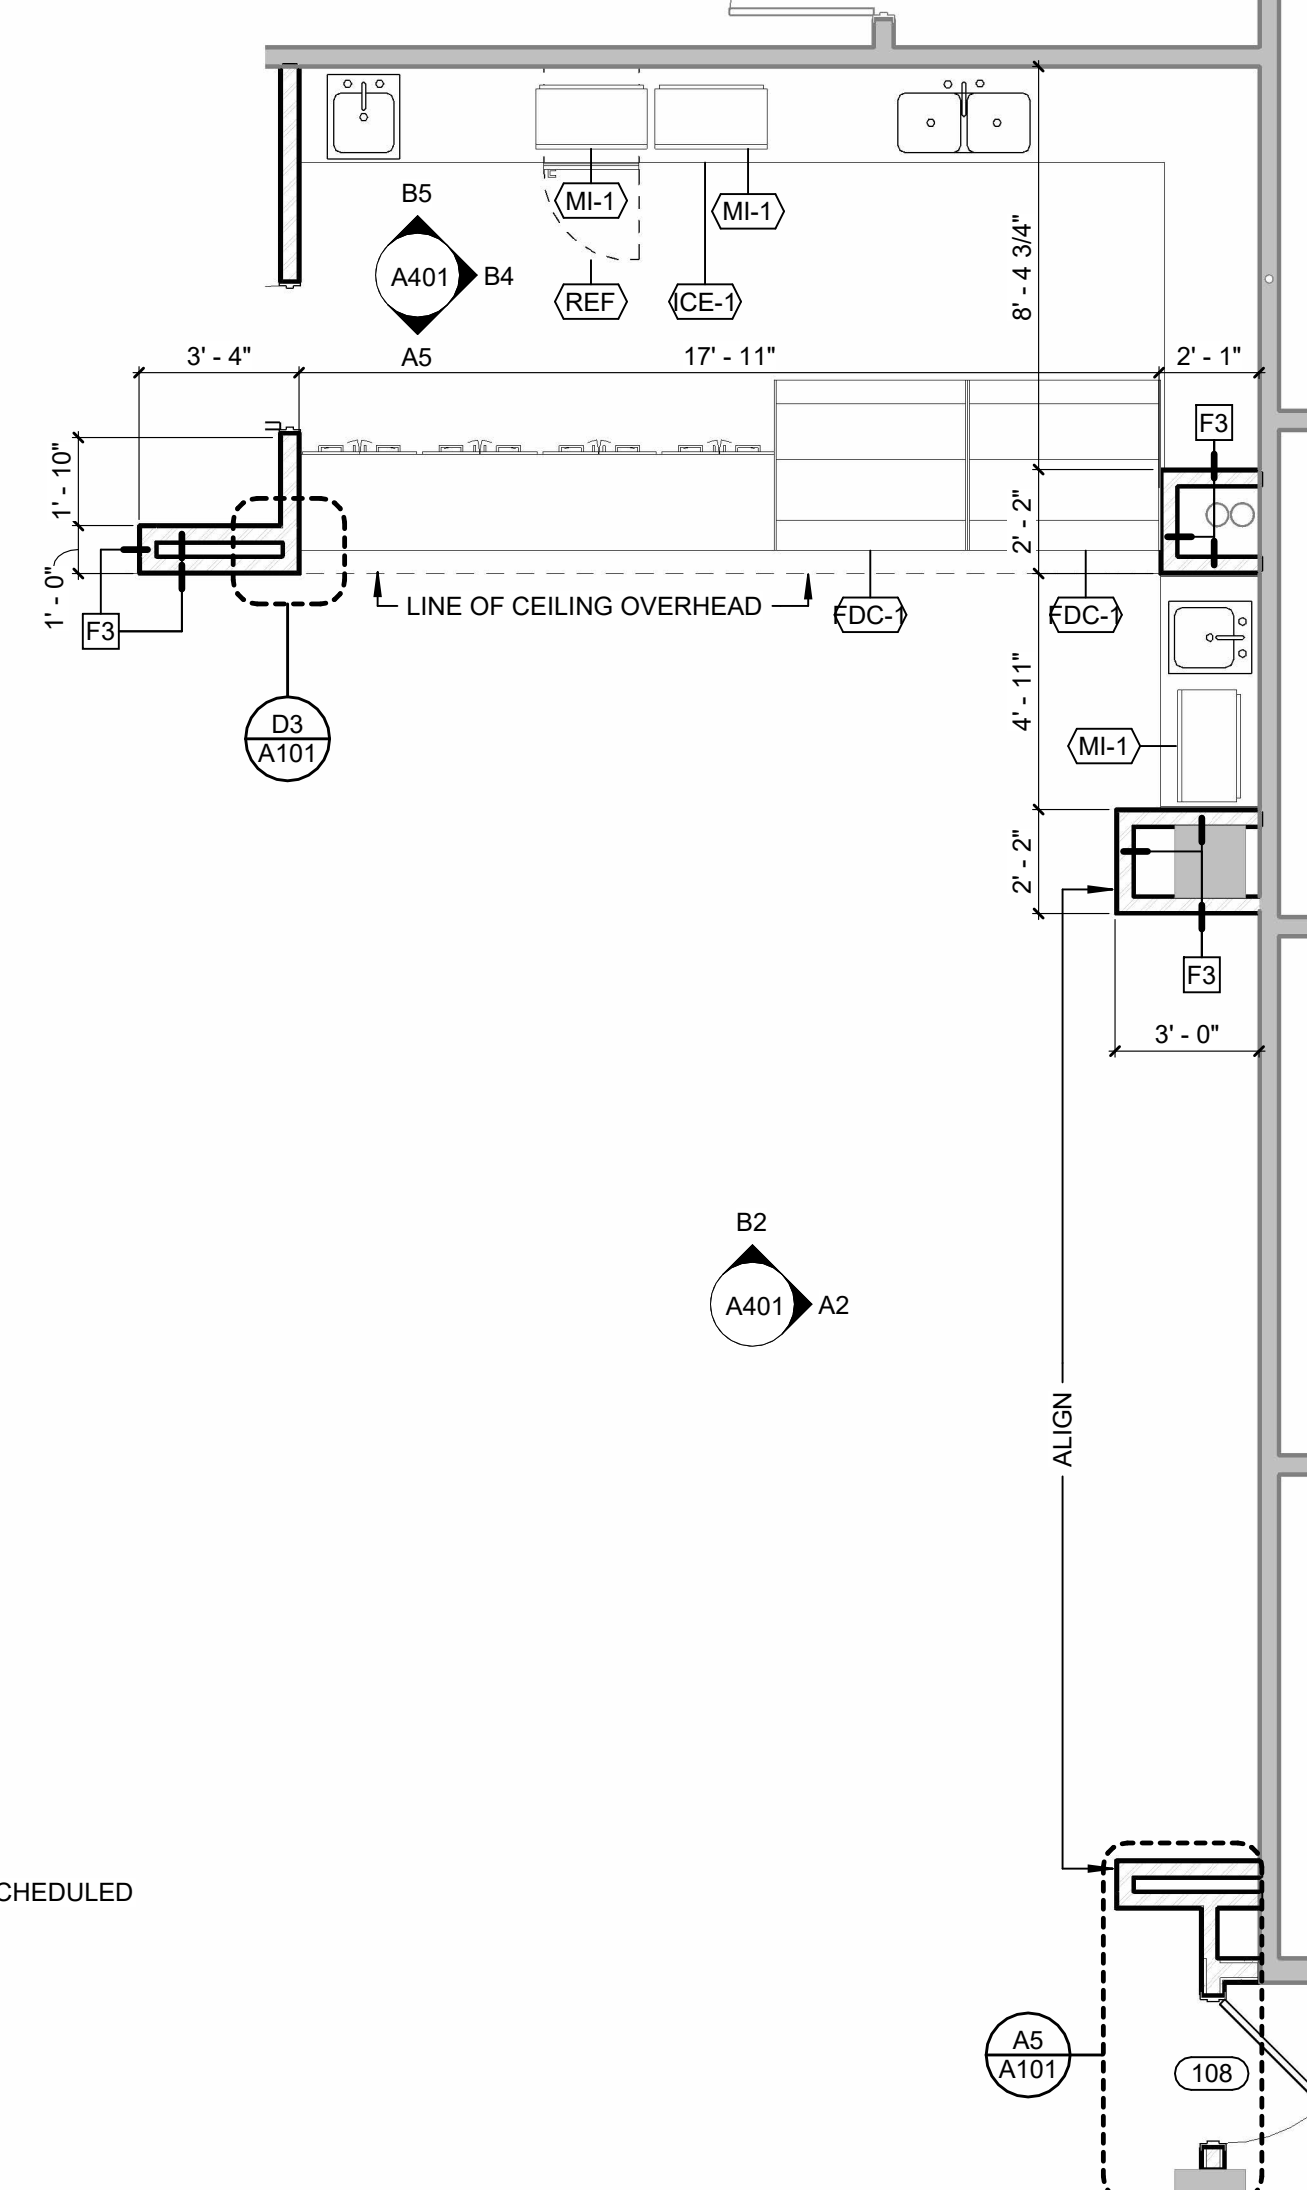


2/27/2025 7:03:08 AM Autodesk Docs\\HE0569 2401.00 UNT Chilton Hall Level 1 Renovation\\Chilton Hall Level 1 Renovation_1524_Arch.rvt

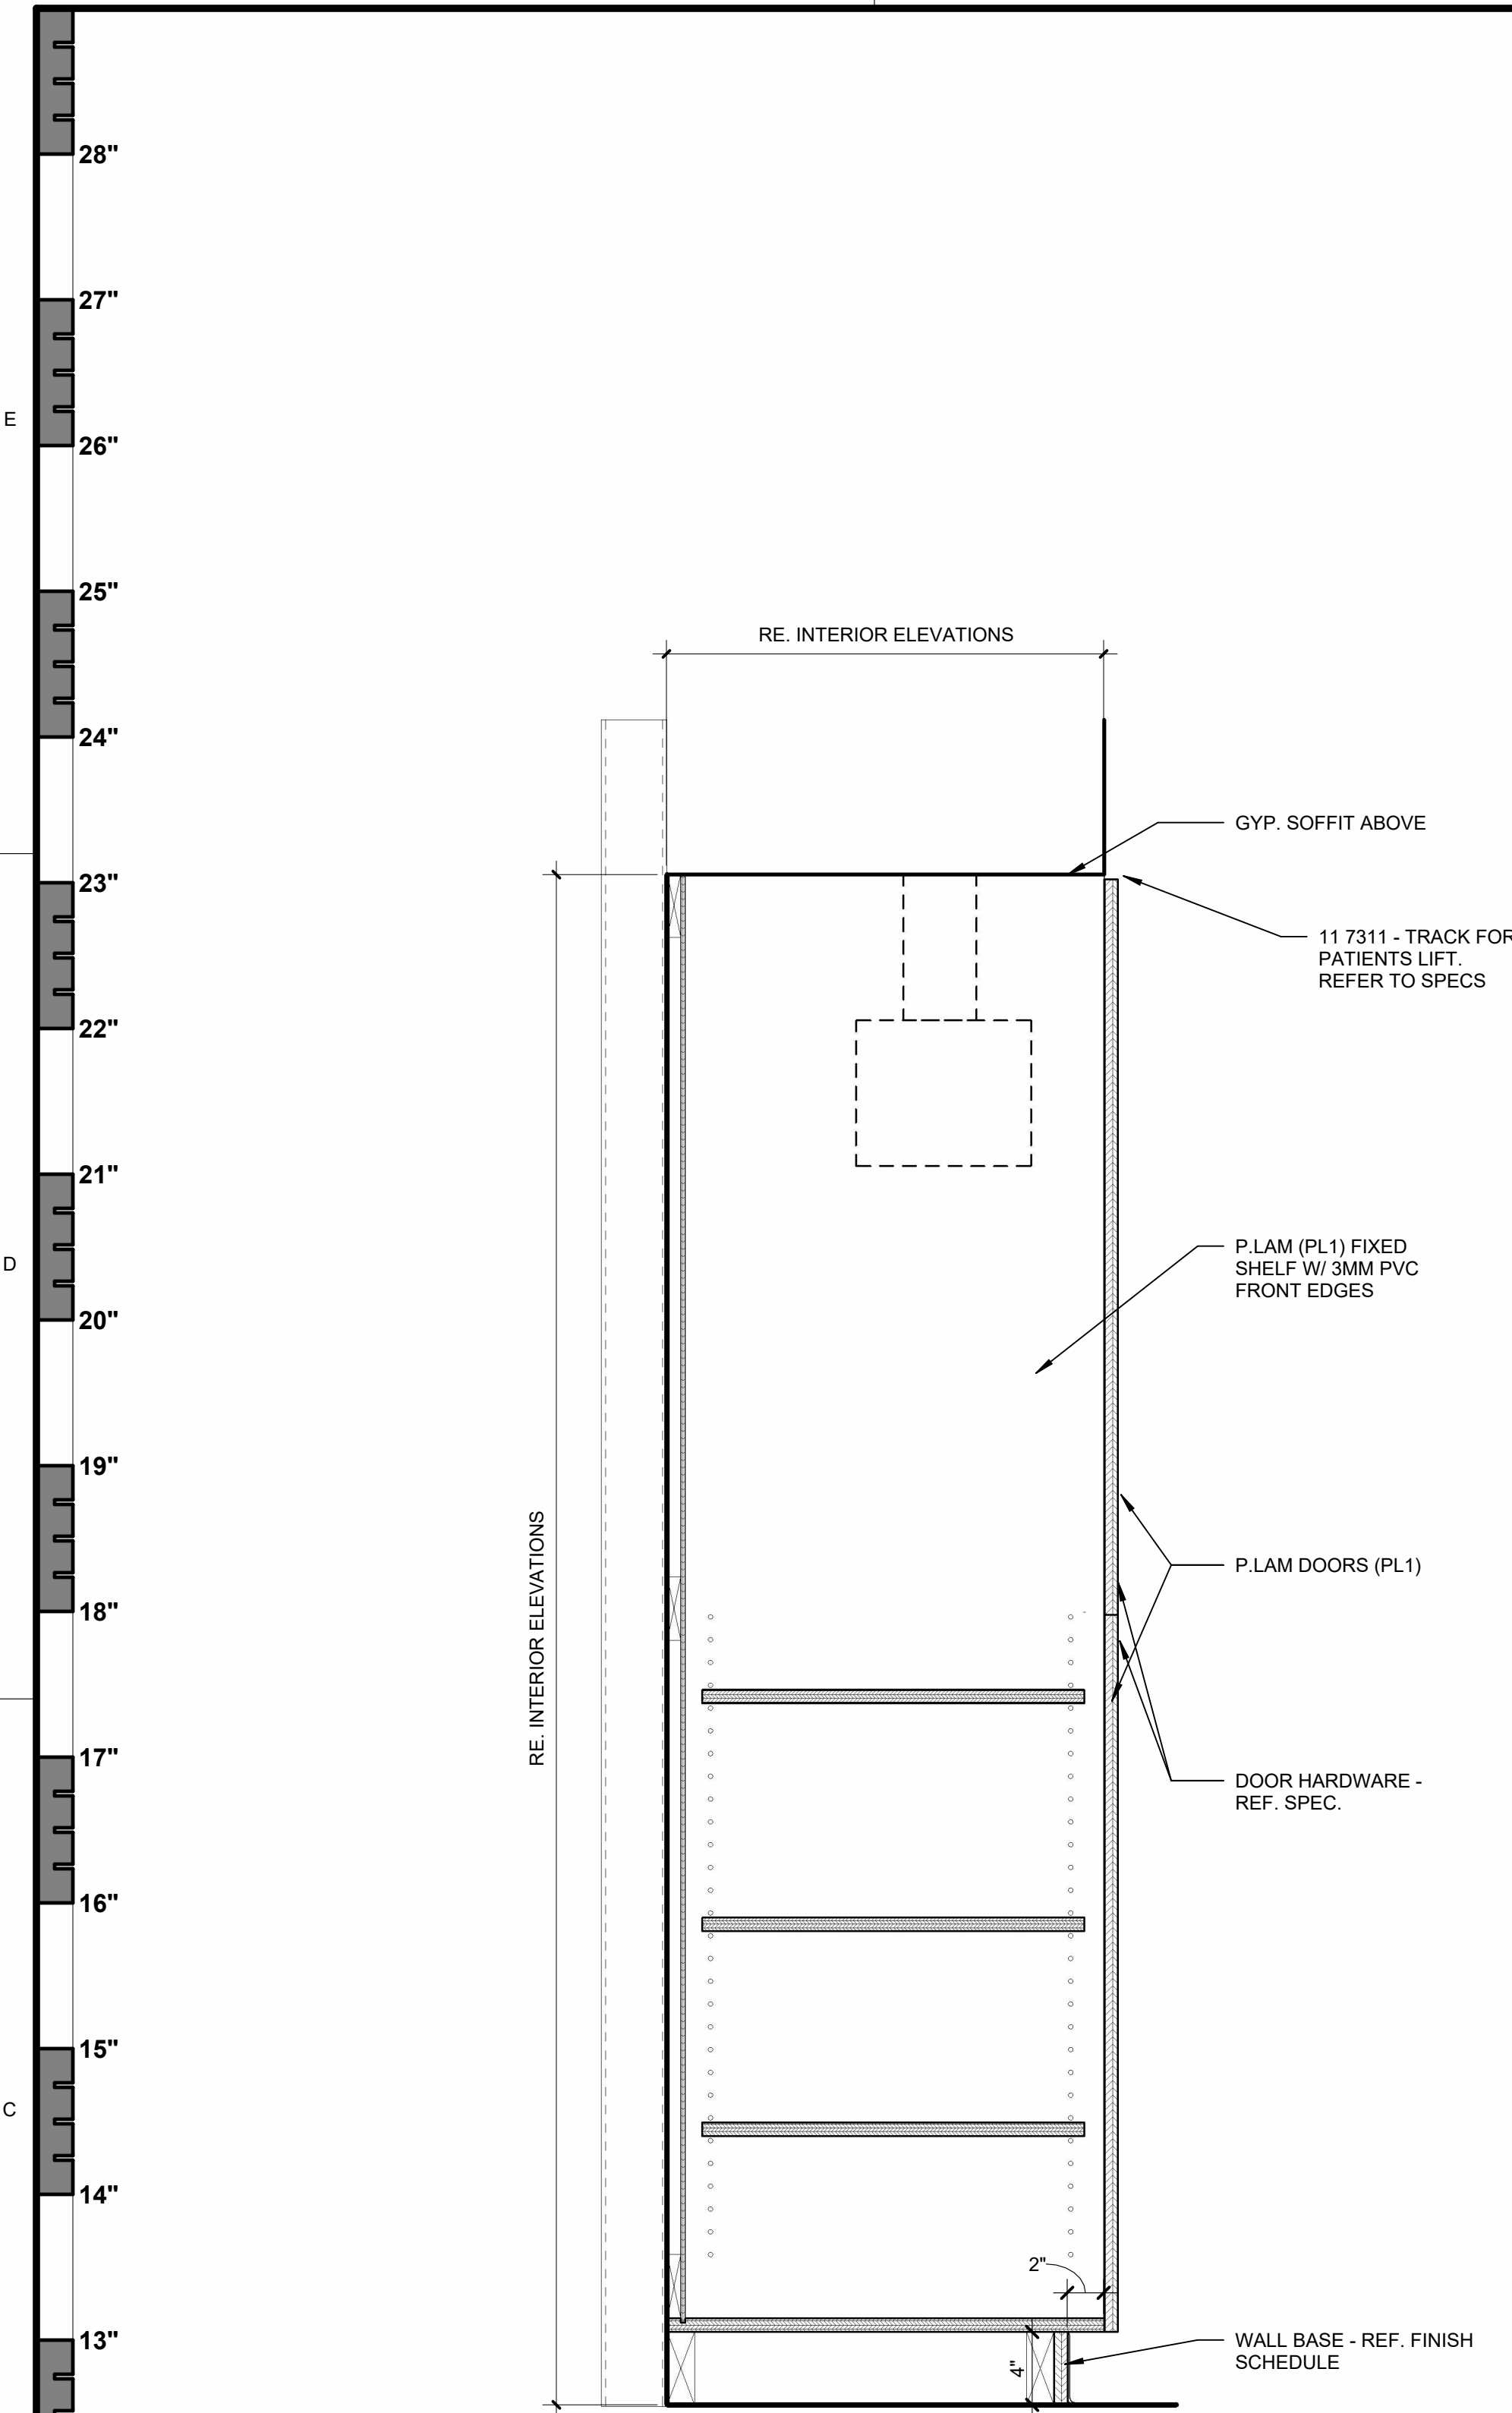


SECTION AT FAMILY RESTROOM CABINET B5
1 1/2" = 1'-0"

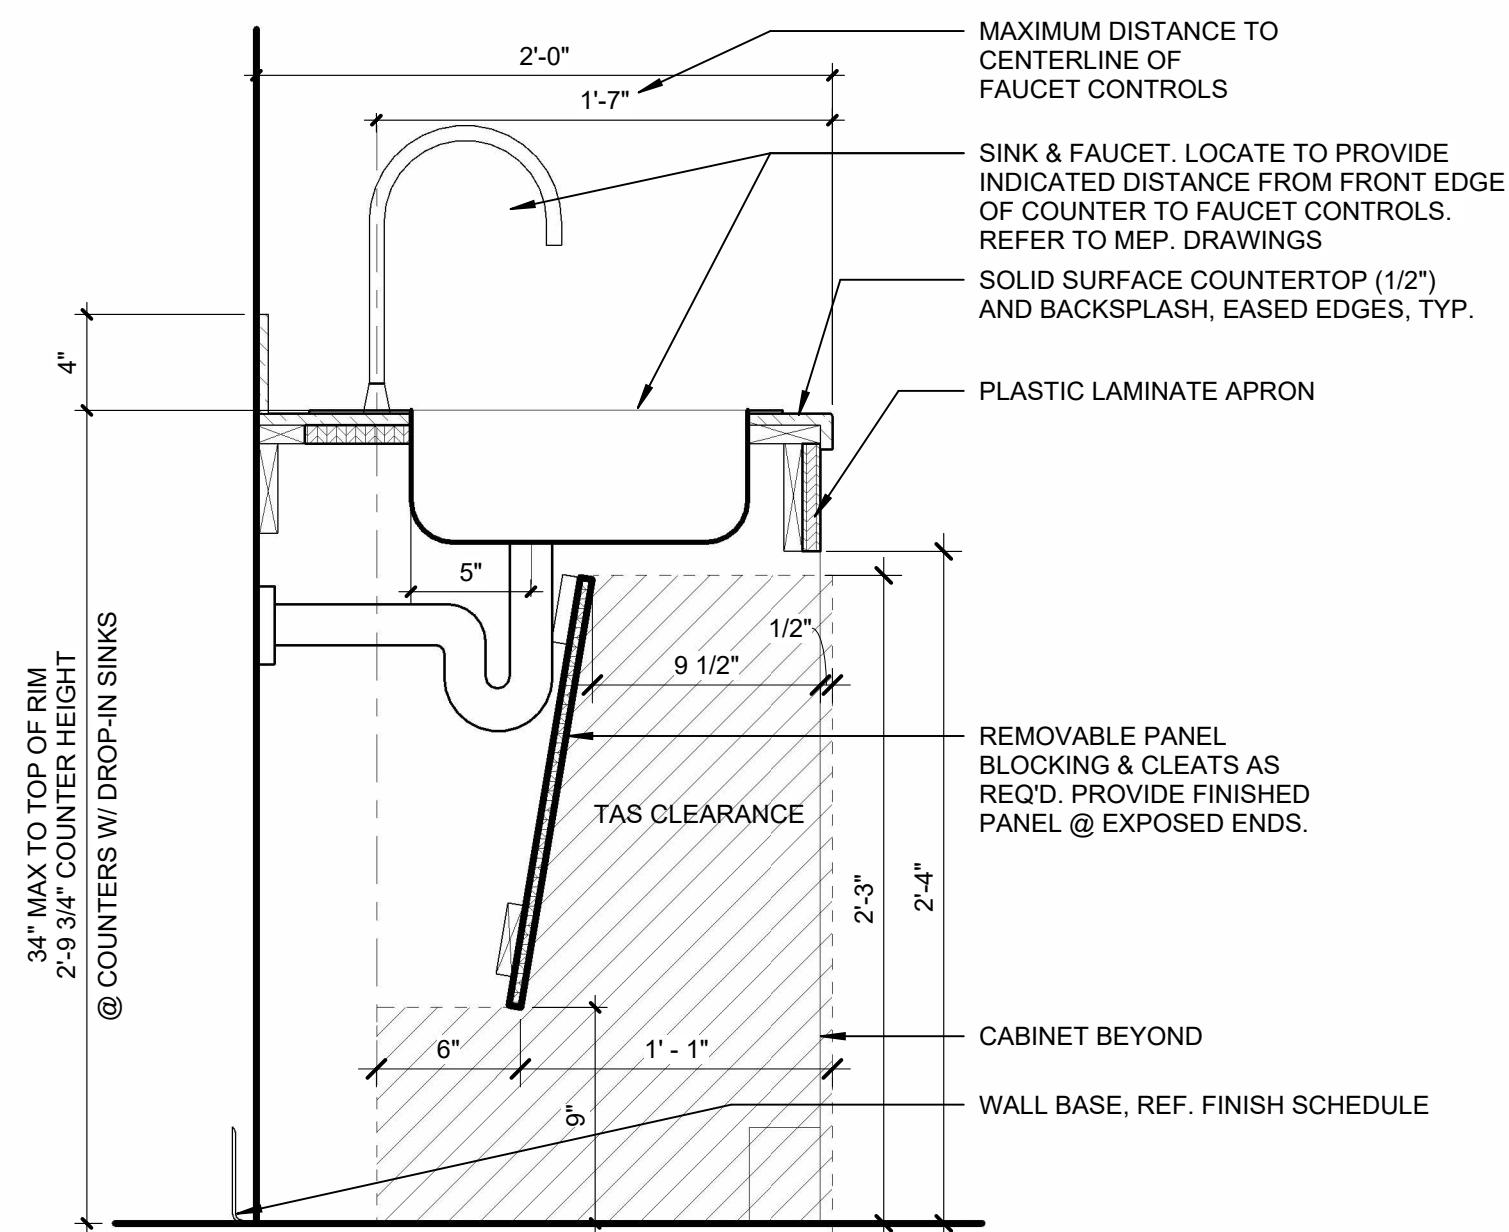


TYP. SINK BASE CABINET B3
1 1/2" = 1'-0"

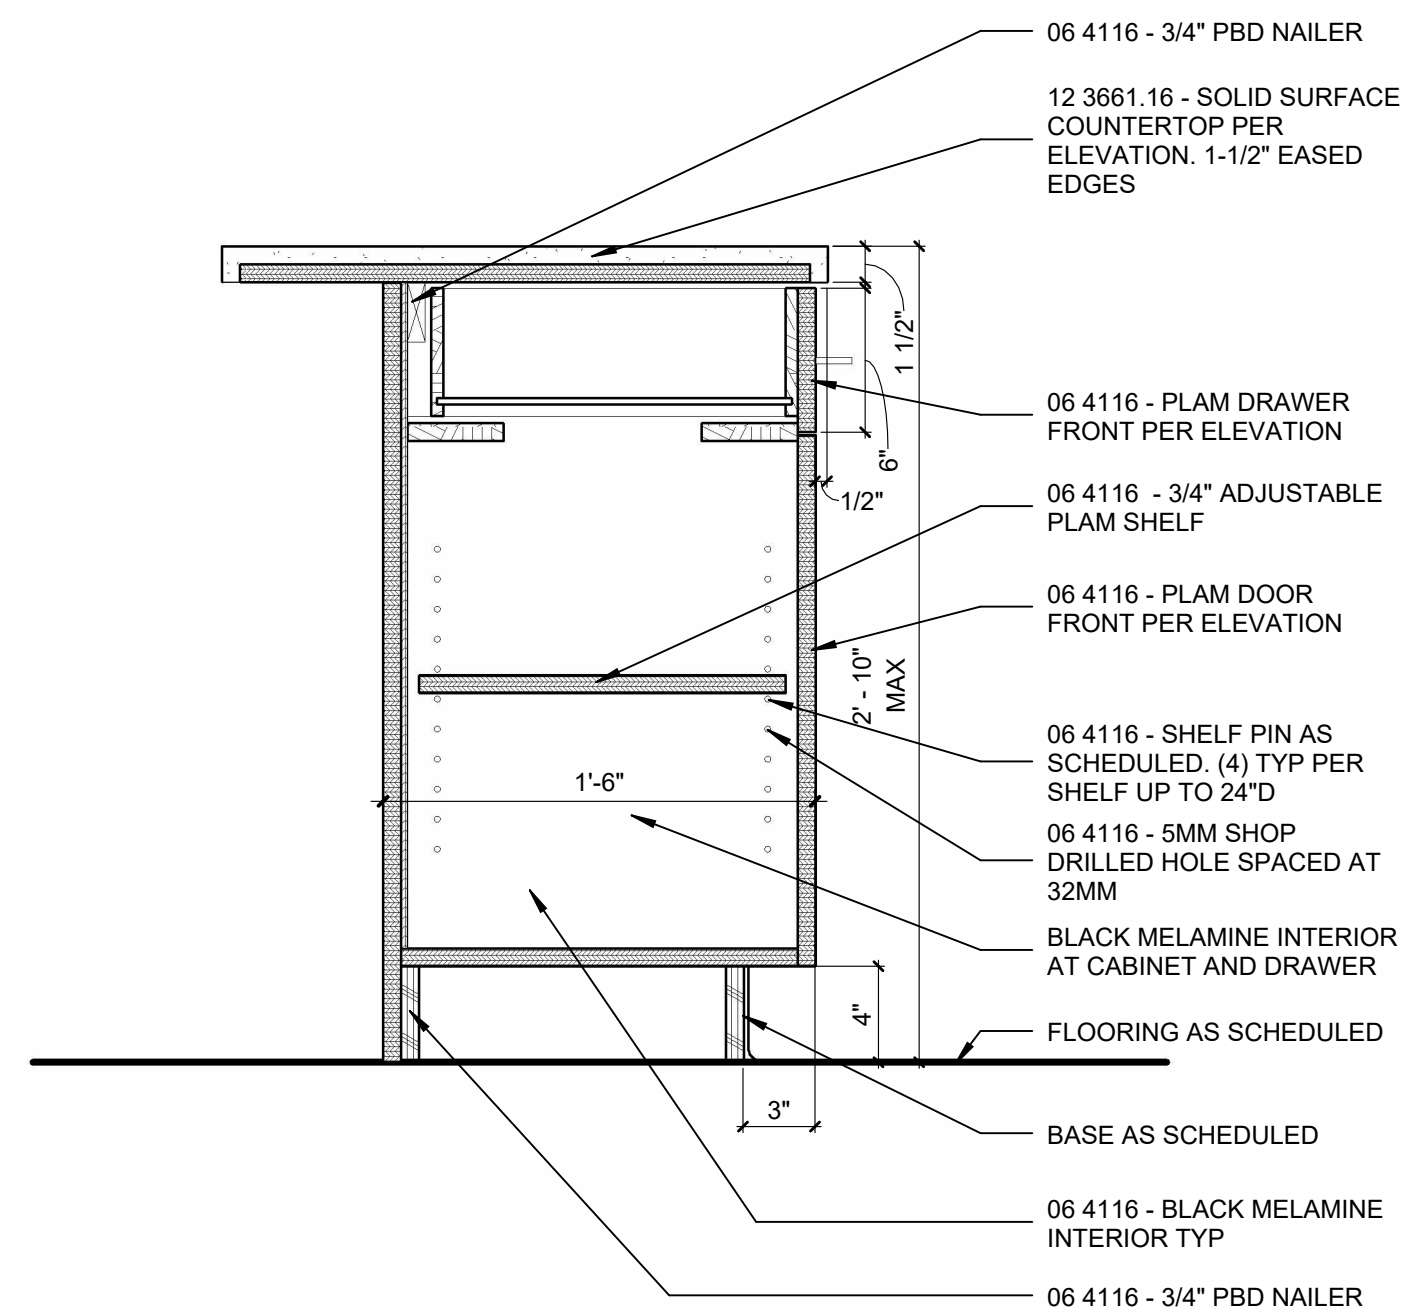


BASE CABINET AT TRANSACTION COUNTER B1
1 1/2" = 1'-0"

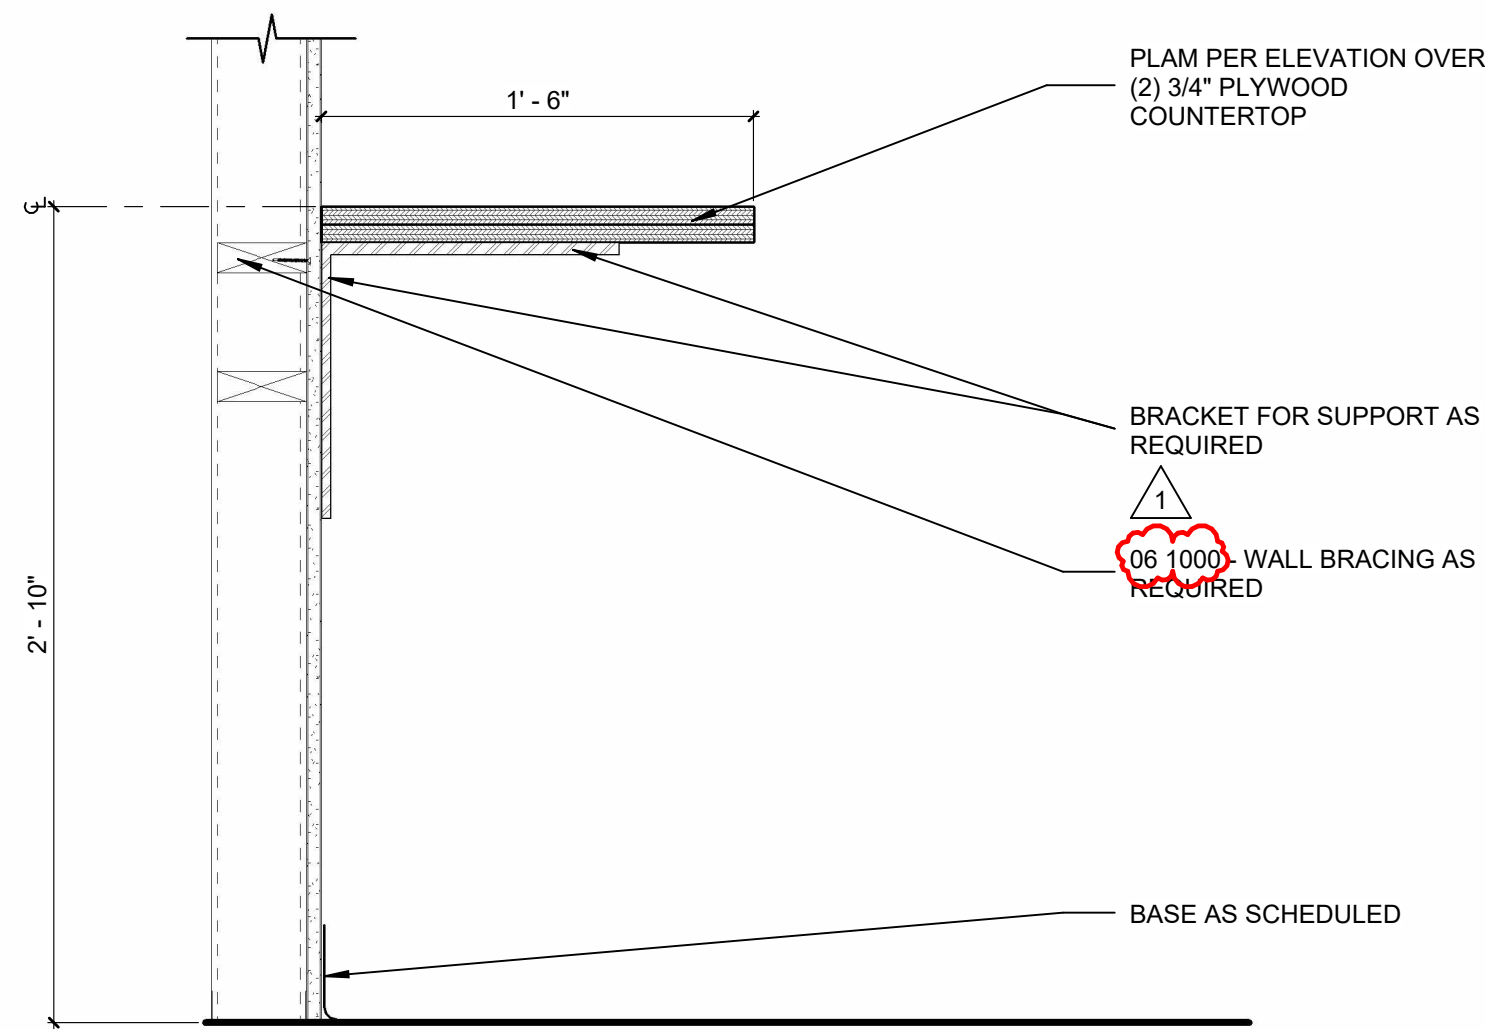


WALL MOUNTED COUNTERTOP A5
1 1/2" = 1'-0"

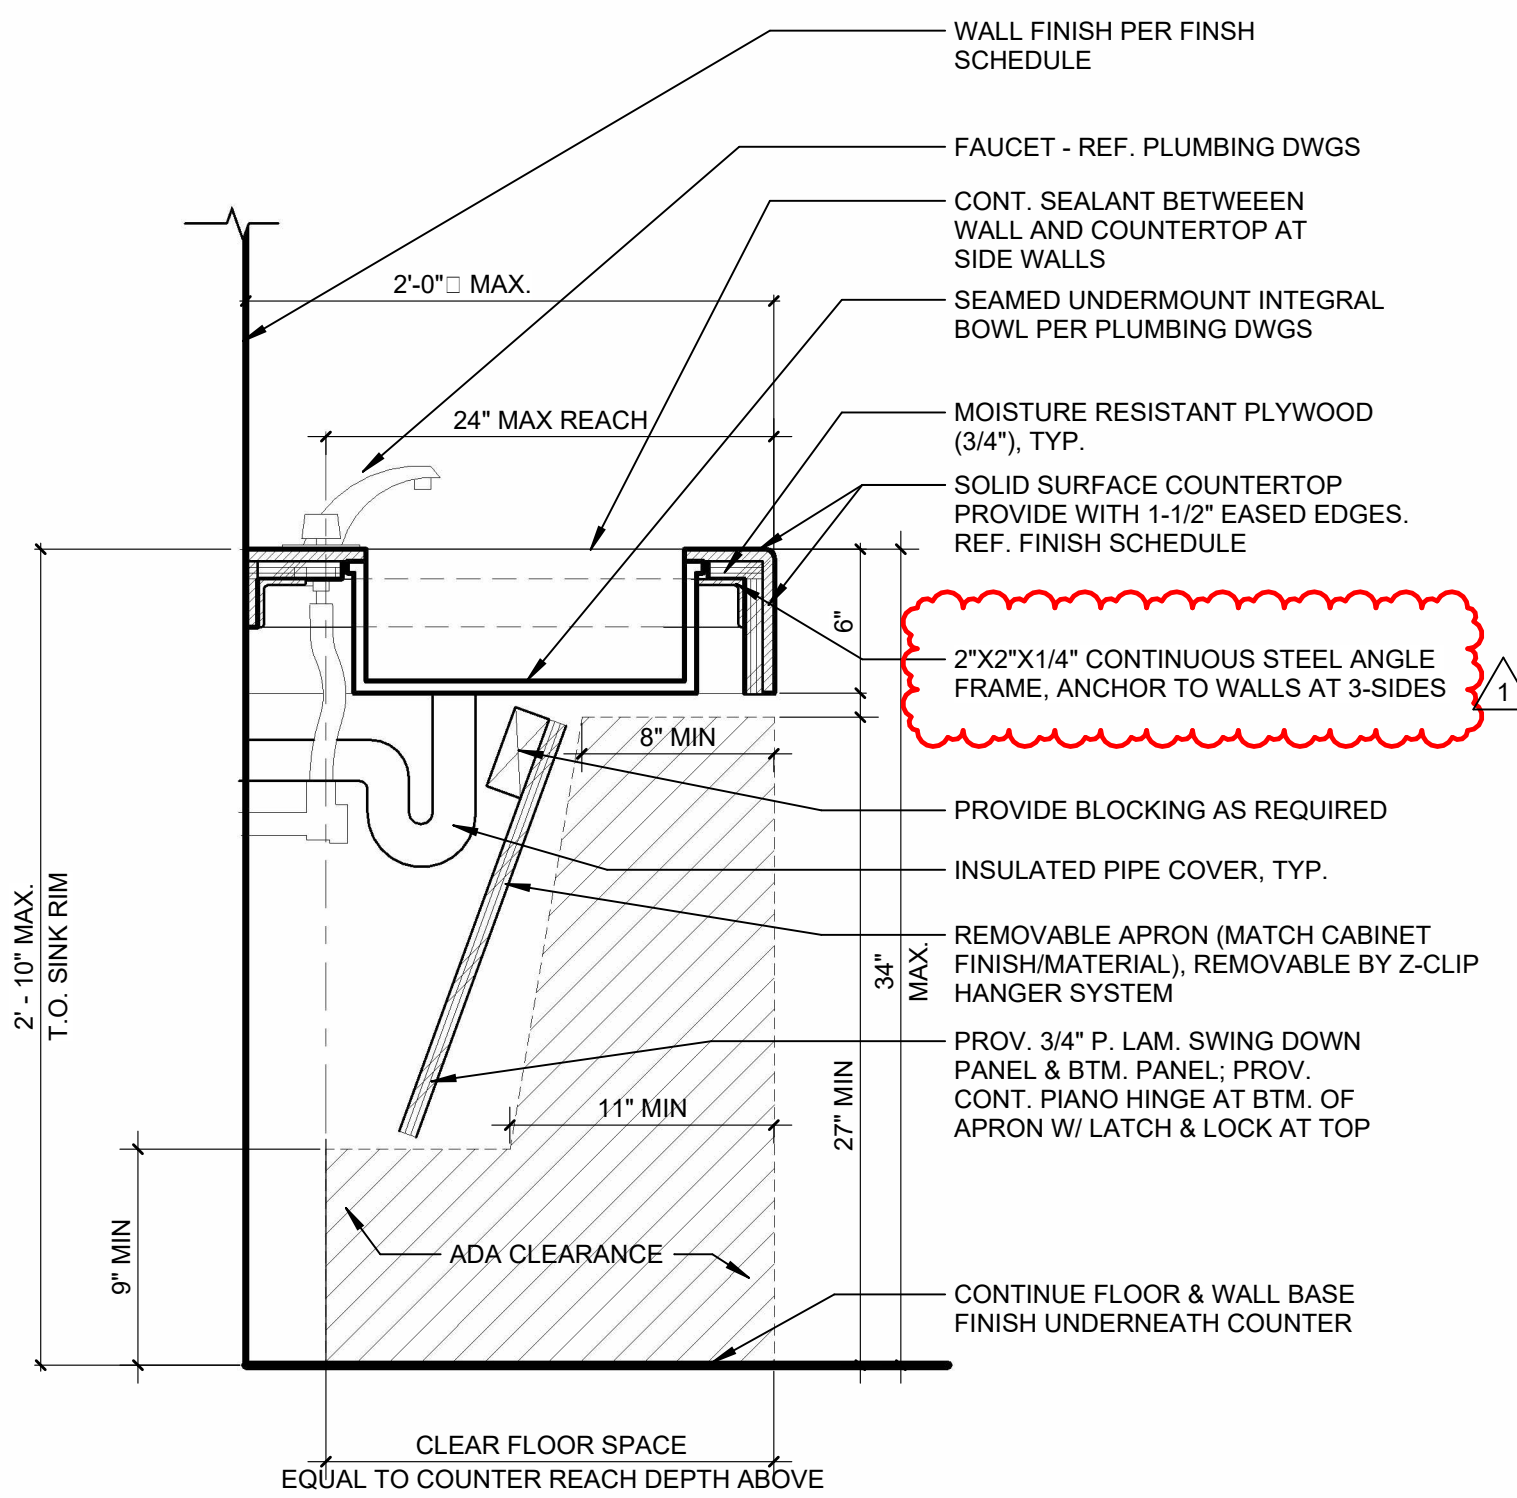



SECTION @ LAVATORIES SINK BASE CABINET A3
1 1/2" = 1'-0"

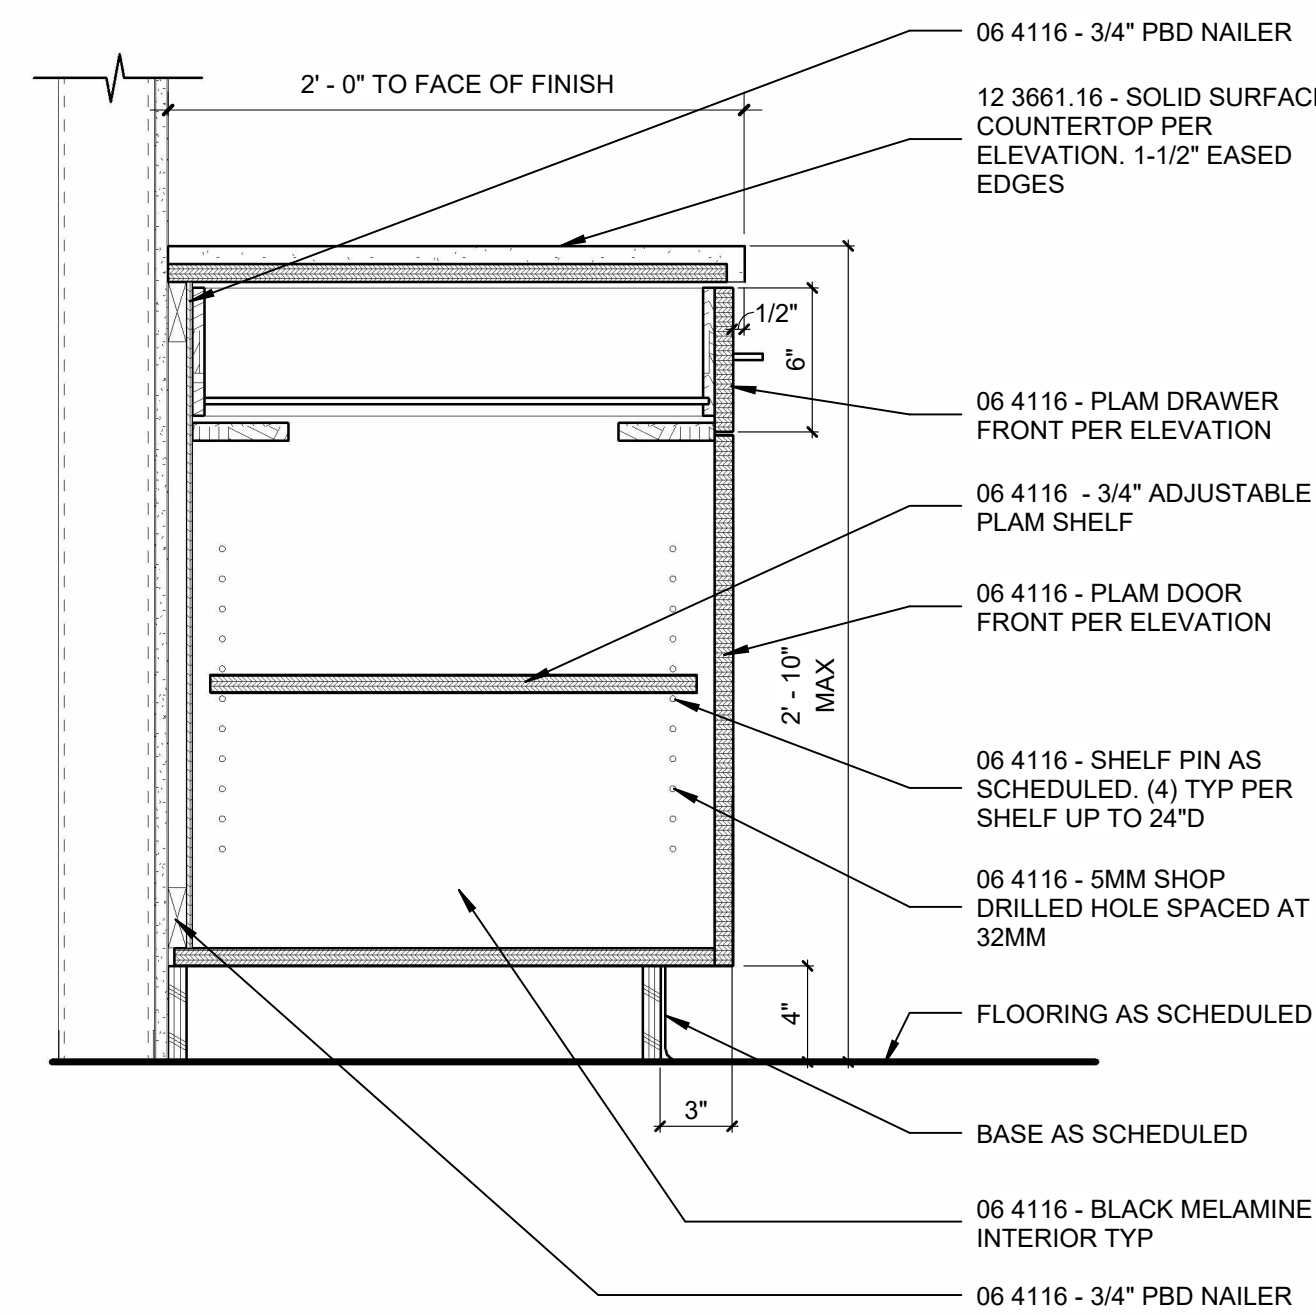


DRAWER & DOOR BASE CABINET A1
1 1/2" = 1'-0"

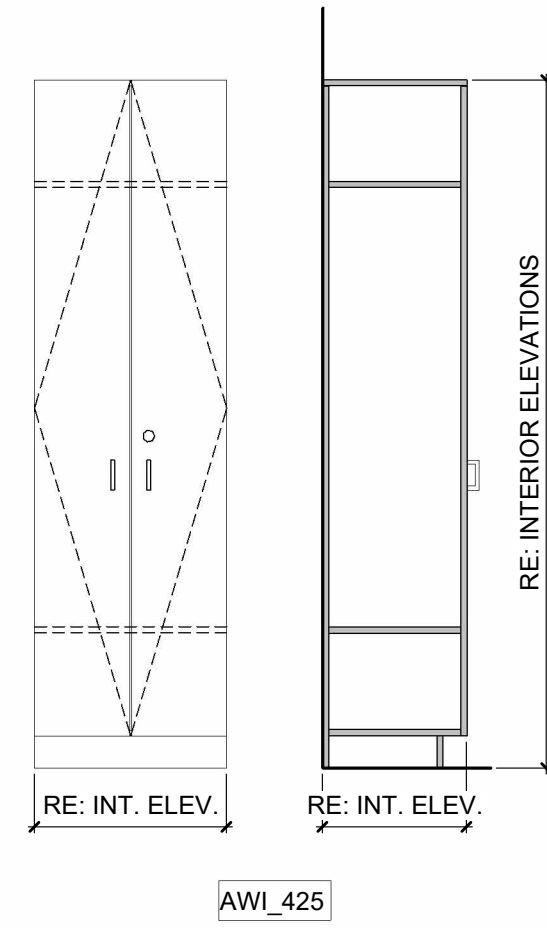

AWI 4##
1/2" = 1'-0"


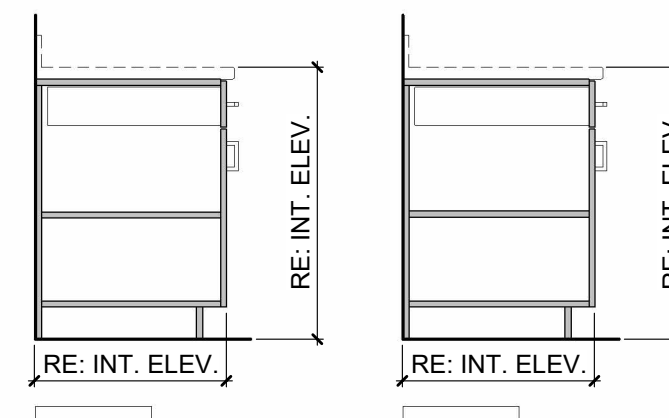
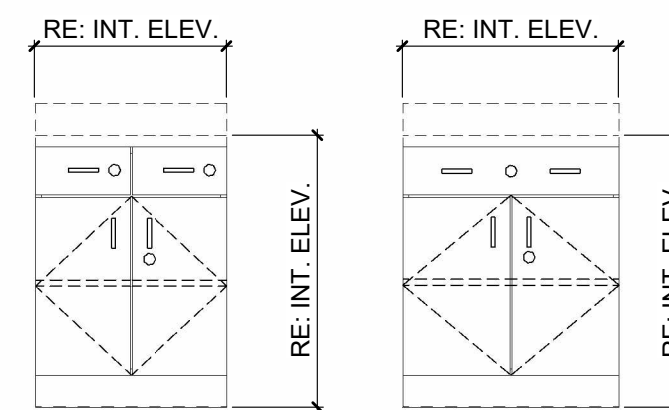


AWI 2##
1/2" = 1'-0"

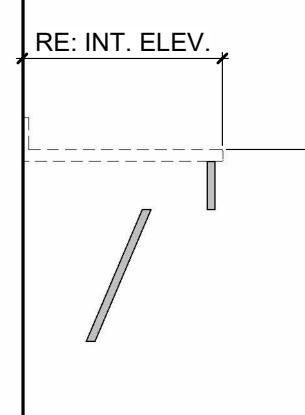

AWI AP#
1/2" = 1'-0"

AWI CASEWORK LEGEND

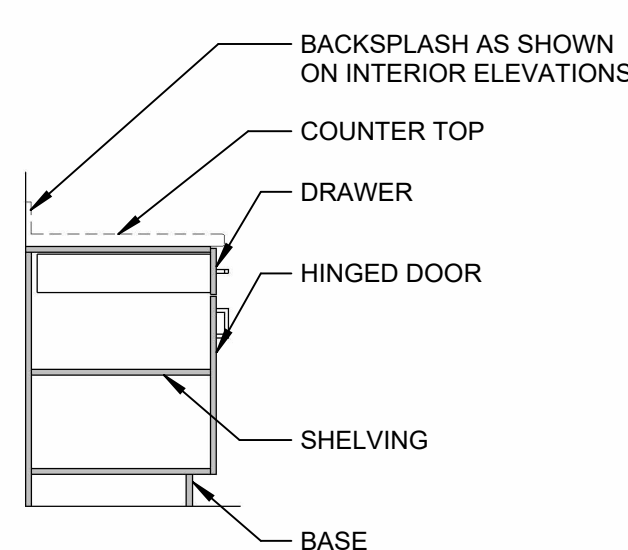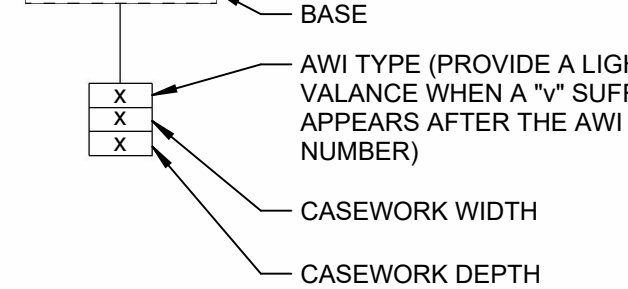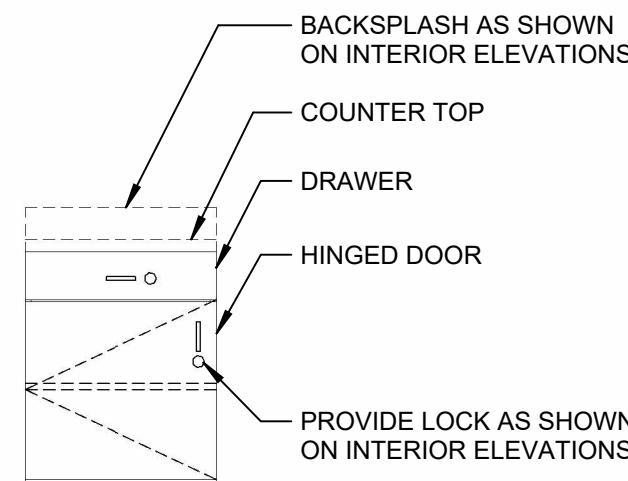

REVISIONS		
NO	DESCRIPTION	DATE
1	ADDENDUM 1	02/27/2025



FINISH PLAN NOTES

- 11 FLOAT EXISTING THICKSET MUD BED FLUSH WITH FINISHED FLOOR. SET FLOOR TILE FLUSH ACROSS NON-RECESSED AND THICKSET BED.
- 12 FILL TILE WALL BASE AT PORTIONS OF WALL WHERE DOOR WAS REMOVED. MATCH EXISTING TILE BASE.
- 13 SCRAPE AND CLEAN ANY FOREIGN MATERIAL FROM EXPOSED CONCRETE SURFACE AT EXPOSED COLUMNS

FINISH PLAN NOTES-GENERAL

- REFER TO SHEET A700 FOR INTERIORS FINISH SCHEDULE AND TRANSITION DETAILS.
- PROVIDE FLOOR TRANSITIONS AT CENTER OF DOOR.
- PROVIDE THRESHOLDS WHERE FLOOR CHANGES OCCUR. REFER TO FLOOR TRANSITION DETAILS ON SHEET A700.
- CONFIRM ORIENTATION OF DIRECTIONAL MATERIAL WITH ARCHITECT PRIOR TO ORDERING AND INSTALLATION.
- REF. INTERIOR ELEVATIONS FOR ADDITIONAL INFORMATION.
- FINISH FLOORING CONTINUES UNDER COUNTERTOPS, KNEE SPACES, TOE KICKS, VANITIES, PLUMBING FIXTURES, REMOVABLE MILLWORK, FURNITURE, AND EQUIPMENT, ETC. U.N.O.
- PROVIDE CONTROL JOINTS IN FLOOR TILE AND WALL TILE PER TCNA STANDARDS.SUBMIT SHOP DRAWINGS TO ARCHITECT FOR REVIEW.
- HATCH PATTERN(S) ARE FOR MATERIAL GRAPHIC REPRESENTATION ONLY AND ARE NOT INDICATIVE OF PATTERN, SIZE, ORIENTATION OR INSTALLATION METHOD OF ANY FINISH PRODUCT. U.N.O.
- PAINT WALL ACCESS PANELS AND GRILLS TO MATCH ADJACENT SURFACES. U.N.O.
- PAINT CEILING ACCESS PANELS AND REGISTERS TO MATCH ADJACENT SURFACE. U.N.O.
- REF. PROJECT SPECIFICATIONS AND MANUFACTURER INSTALLATION SPECIFICATIONS FOR FLOOR AND WALL FINISH SUBSTRATE PREP AND INSTALLATION REQUIREMENTS.
- ALL DOOR FRAMES AND TRIM TO BE PAINTED PER DOOR SCHEDULE.
- REF. FLOOR PLANS AND PARTITION TYPES FOR MATERIAL SUBSTRATES.
- REF. RCPS FOR CEILING MATERIAL INFORMATION AND FINISHES.
- FOR TYPICAL WALL BASE AS CERAMIC OR PORCELAIN TILE WALLS, REFER TO DETAIL A5/A701.


FINISH PLAN LEGEND

- NOT IN SCOPE
- CARPET TILE CPT-1
- CARPET TILE CPT-2
- LUXURY VINYL PLANK TILE LVT-1
- LUXURY VINYL PLANK TILE LVT-2
- QUARRY FLOOR TILE QFT-1
- PORCELAIN FLOOR TILE PFT-1
- SEALED CONCRETE


- OPEN AREA FLOOR TRANSITION TAG**
 - FLOOR FINISH
 - TRANSITION
 - FLOOR FINISH
- FLOOR TRANSITIONS IDENTIFIED ONLY WHERE FLOOR MATERIAL CHANGES OCCUR WITHIN A ROOM OR SPACE - REFERENCE ROOM FINISH TAGS FOR FINISH CHANGES BETWEEN ROOMS.
- FLOOR & WALL BASE TAG**
 - FLOOR FINISH
 - WALL BASE
- WALL ACCENT TAG**
 - WALL PARTITION
 - WALL ACCENT FINISH EXTENTS
 - WALL ACCENT FINISH TAG
- WALL ACCENT FINISH OCCURS FLR. TO CEILING U.N.O. WHERE 'EXTENTS' LINE CONTINUES OVER DOOR FRAME WINDOW - IT IS NOT INTENDED FOR THESE ITEMS TO RECEIVE THE ACCENT FINISH. REF. FINISH SCHEDULES FOR FIELD FINISH INFORMATION.
- SPECIALTY EQUIPMENT TAG**
 - SPECIALTY EQUIPMENT FINISH TAG
- CG-1 CORNER GUARD PER FINISH SCHEDULE
- FINISH STARTING POINT

REVISIONS		
NO	DESCRIPTION	DATE
1	ADDENDUM 1	02/27/2025


TOILET ACCESSORY SCHEDULE								
MARK	TYPE	MANUFACTURER	MODEL NAME	MODEL NUMBER	DIMENSIONS	COLOR	RESPONSIBILITY	NOTES
TP-1	TOILET PARTITION - FLOOR MOUNTED OVERHEAD BRACED	SCRANTON PRODUCTS	ECLIPSE		-	TBD	CFCI	REFER TO PROJECT MANUAL SPECIFICATIONS FOR ADDITIONAL INFORMATION.
PS-1	URINAL PRIVACY SCREEN - WALL MOUNTED	SCRANTON PRODUCTS	ECLIPSE		-	TBD	CFCI	
GB	GRAB BAR	BOBRICK	1-1/1" DIA. GRAB BAR WITH SNAP FLANGE	B-6806 SERIES	19", 36" AND 42" LENGTHS - SEE ELEVATIONS AND ACCESSIBILITY DETAILS FOR PLACEMENT	SATIN FINISH WITH PEENED GRIPPING SURFACE	CFCI	
PT-1	RECESSED PAPER TOWEL DISPENSER/WASTE RECEPTACLE	BOBRICK	-	B-43944		STAINLESS STEEL	CFCI	
TD-1	SURFACE MOUNTED TOILET TISSUE DISPENSER						OFOI	
SD-1	SURFACE MOUNTED SOAP DISPENSER						CFCI	
L-1	ADA LIFT	GULDMANN	REFER TO PROJECT MANUAL SPECIFICATIONS FOR ADDITIONAL INFORMATION.				CFCI	
ND-1	SURFACE MOUNTED SANITARY NAPKIN DISPOSAL UNIT						OFOI	
M-1	SURFACE MOUNTED MIRROR	BOBRICK	-	B-290	24"W x 36"H		CFCI	

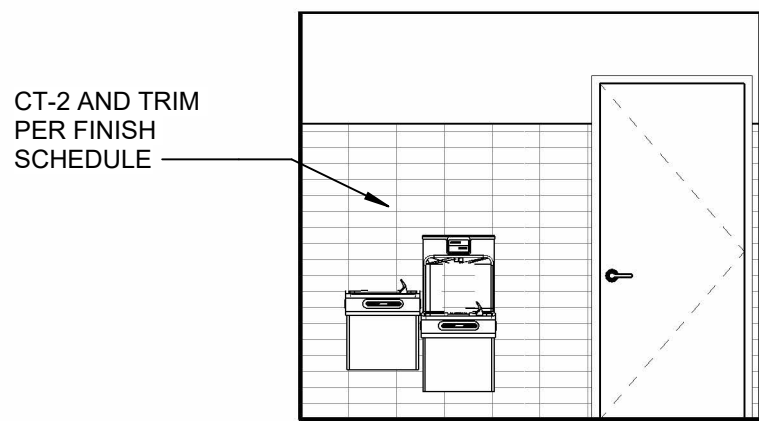


ELEVATION AT WATER FOUNTAIN C4
1/4" = 1'-0"

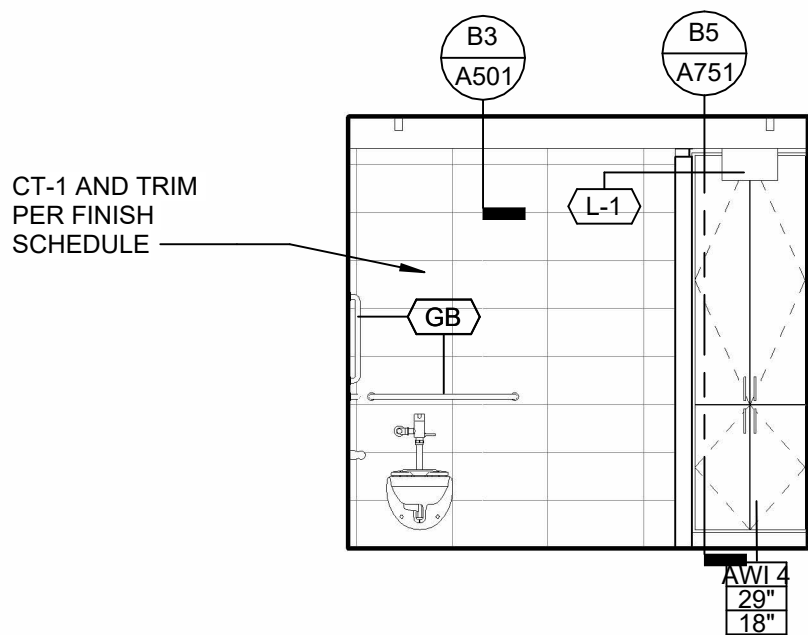


ELEVATION AT FAMILY RESTROOM - EAST C3
1/4" = 1'-0"

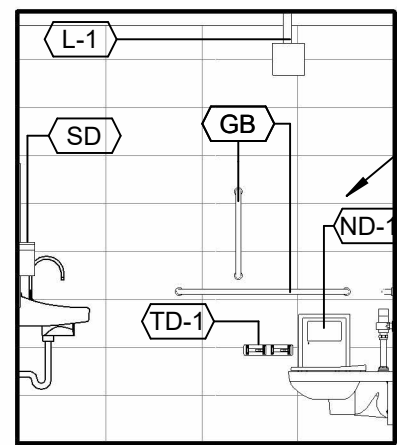


ELEVATION AT FAMILY RESTROOM - NORTH C2
1/4" = 1'-0"

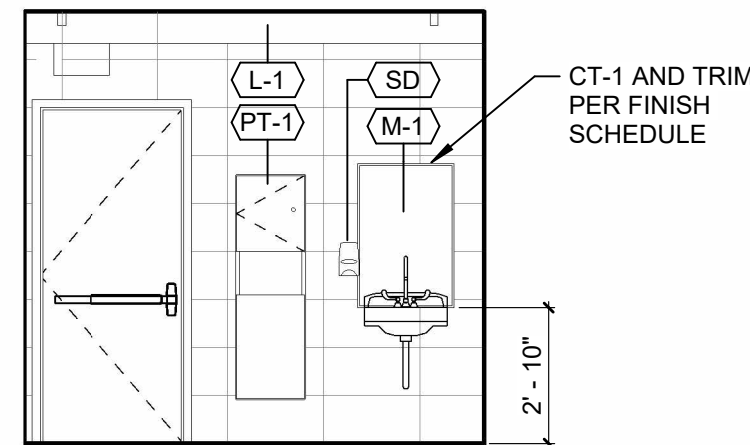


ELEVATION AT FAMILY RESTROOM - WEST C1
1/4" = 1'-0"

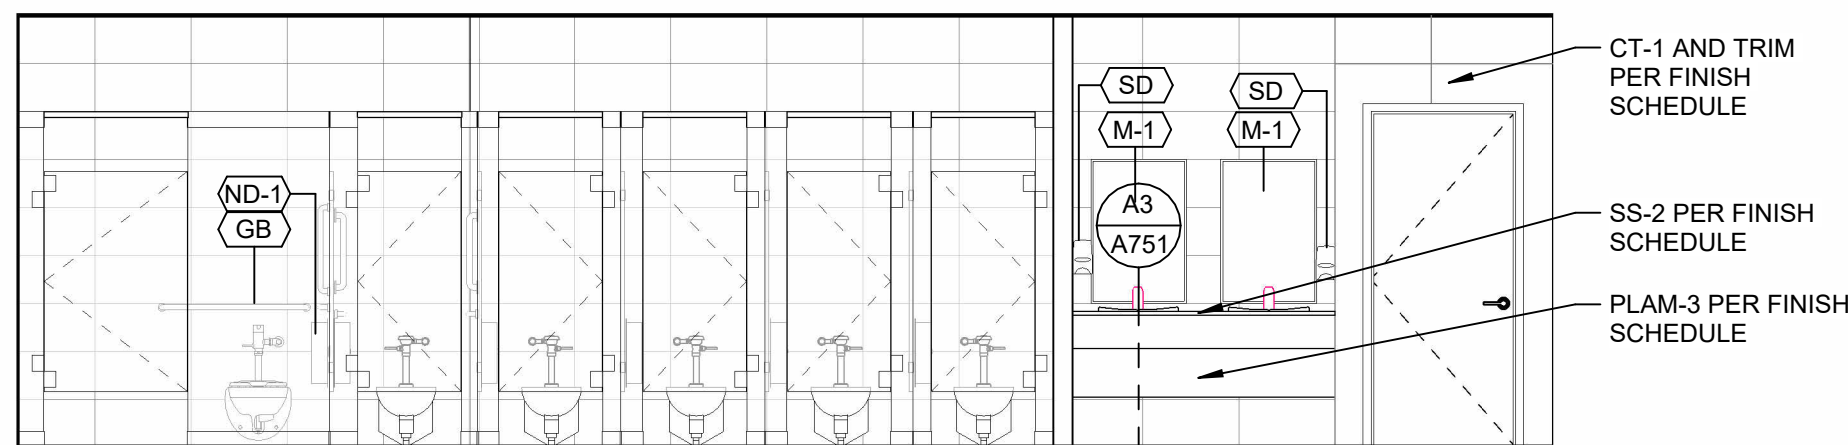


ELEVATION AT WOMEN RESTROOM B3
1/4" = 1'-0"

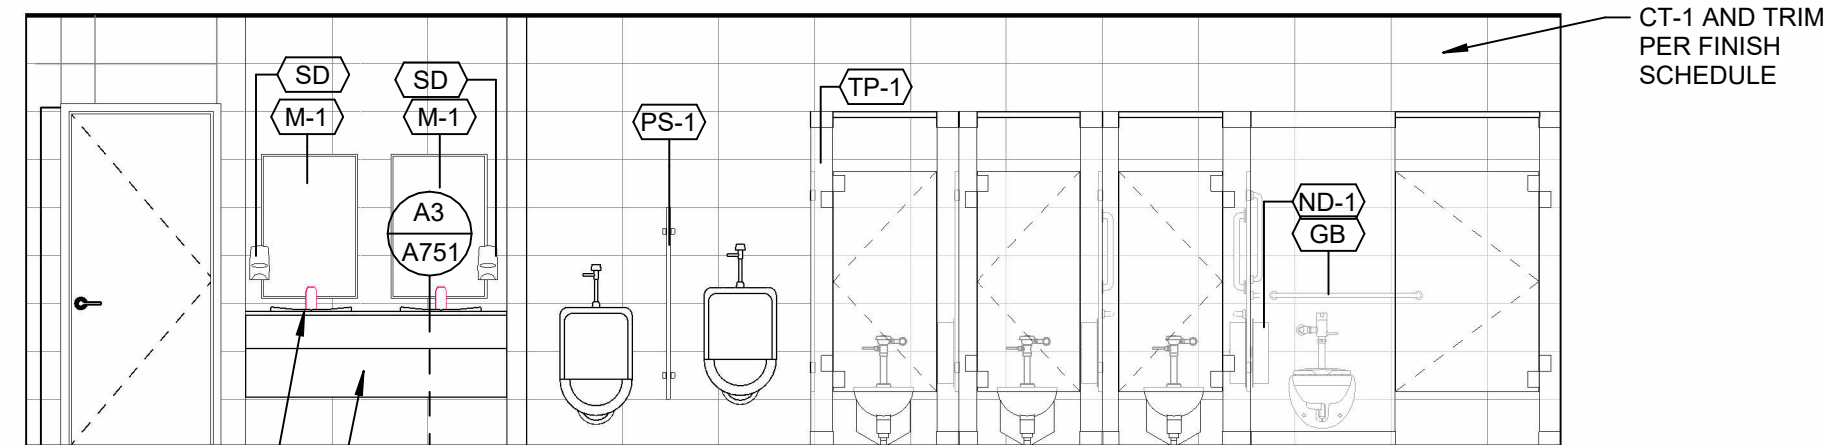

ELEVATION AT MEN RESTROOM B1
1/4" = 1'-0"

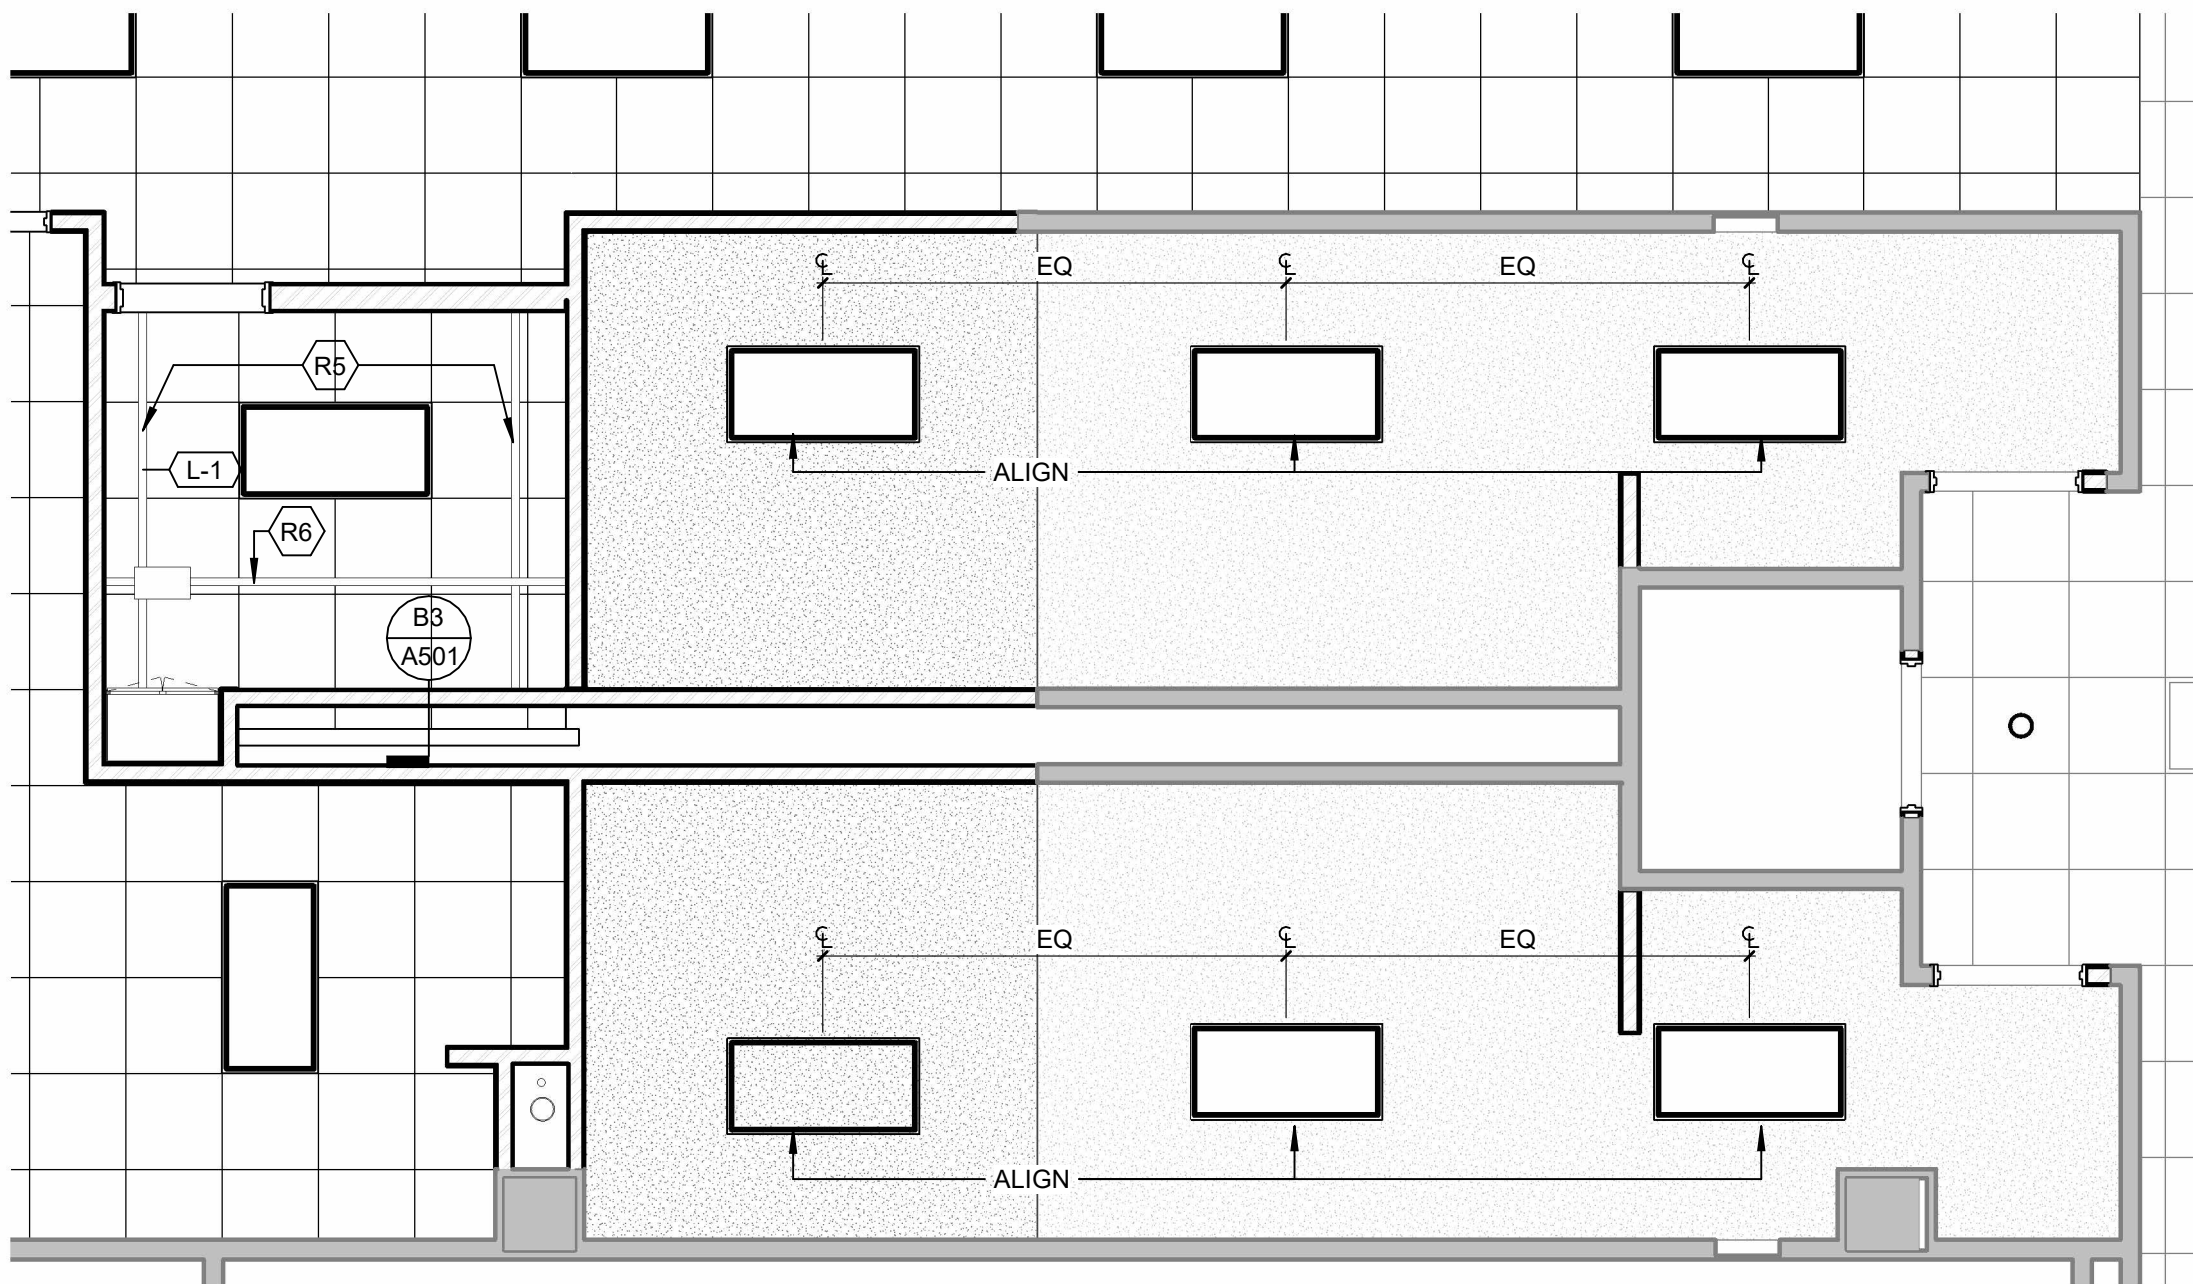

ENLARGED RCP - RESTROOMS A3
1/4" = 1'-0"

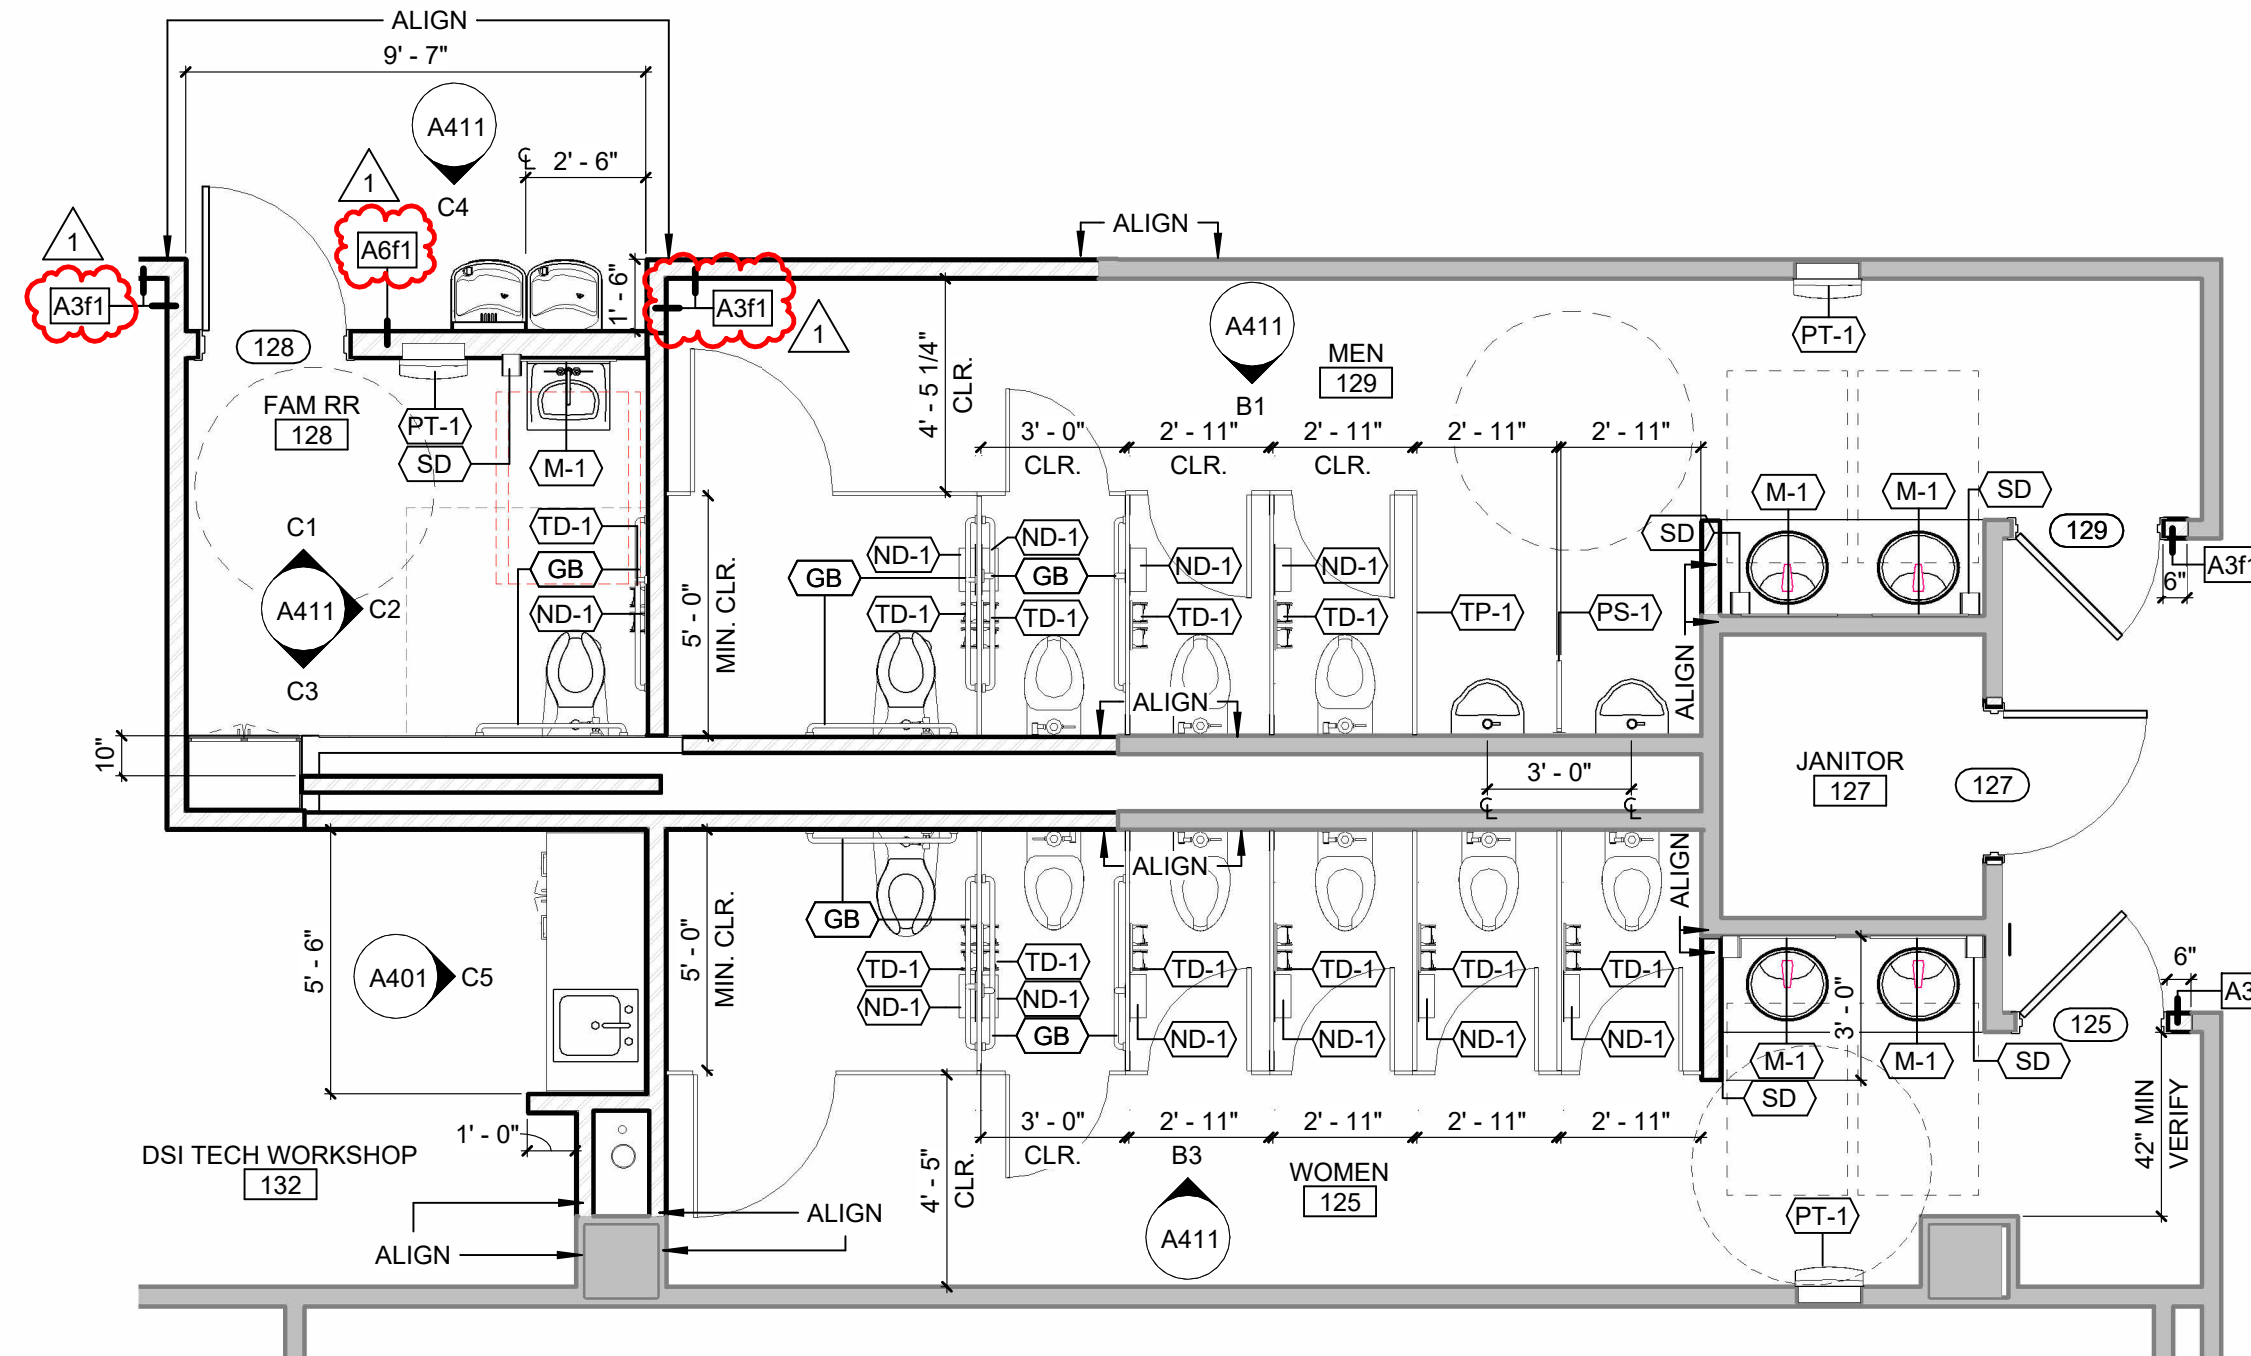

ENLARGED PLAN - RESTROOMS A1
1/4" = 1'-0"

RCP PLAN NOTES

- R5 CEILING MOUNTED PATIENT LIFT RAILS, MOUNTED TO CONCRETE SLAB ABOVE
R6 PATIENT LIFT GANTRY RAIL

ENLARGED PLAN NOTES

UNIVERSITY OF NORTH TEXAS
CHILTON HALL LEVEL 1 RENOVATION

410 Avenue C
Denton, Texas 76201



This drawing is an instrument of service and shall remain the property of Treanor. This drawing and the concepts and ideas contained herein shall not be used, reproduced, revised, or related without the express written approval of Treanor, unless the Architect-Client agreement requires otherwise. Submission or distribution of this drawing to meet official or regulatory requirements or for other purposes in connection with the project is not to be construed as publication in derogation of any of the rights of Treanor.

Issued For: CONSTRUCTION
Date: 01/16/2025


REVISIONS		
NO	DESCRIPTION	DATE
1	ADDENDUM 1	02/27/2025

A411

ENLARGED RESTROOM
PLANS, ELEVATIONS,
AND ACCESSORY
SCHEDULE

Treanor NO. HE0569.2401.00

2/27/2025 7:03:27 AM Autodesk Docs\\HE0569 2401.00 UNT Chilton Hall Level 1 Renovation\\Chilton Hall Level 1 Renovation\\A801.dwg

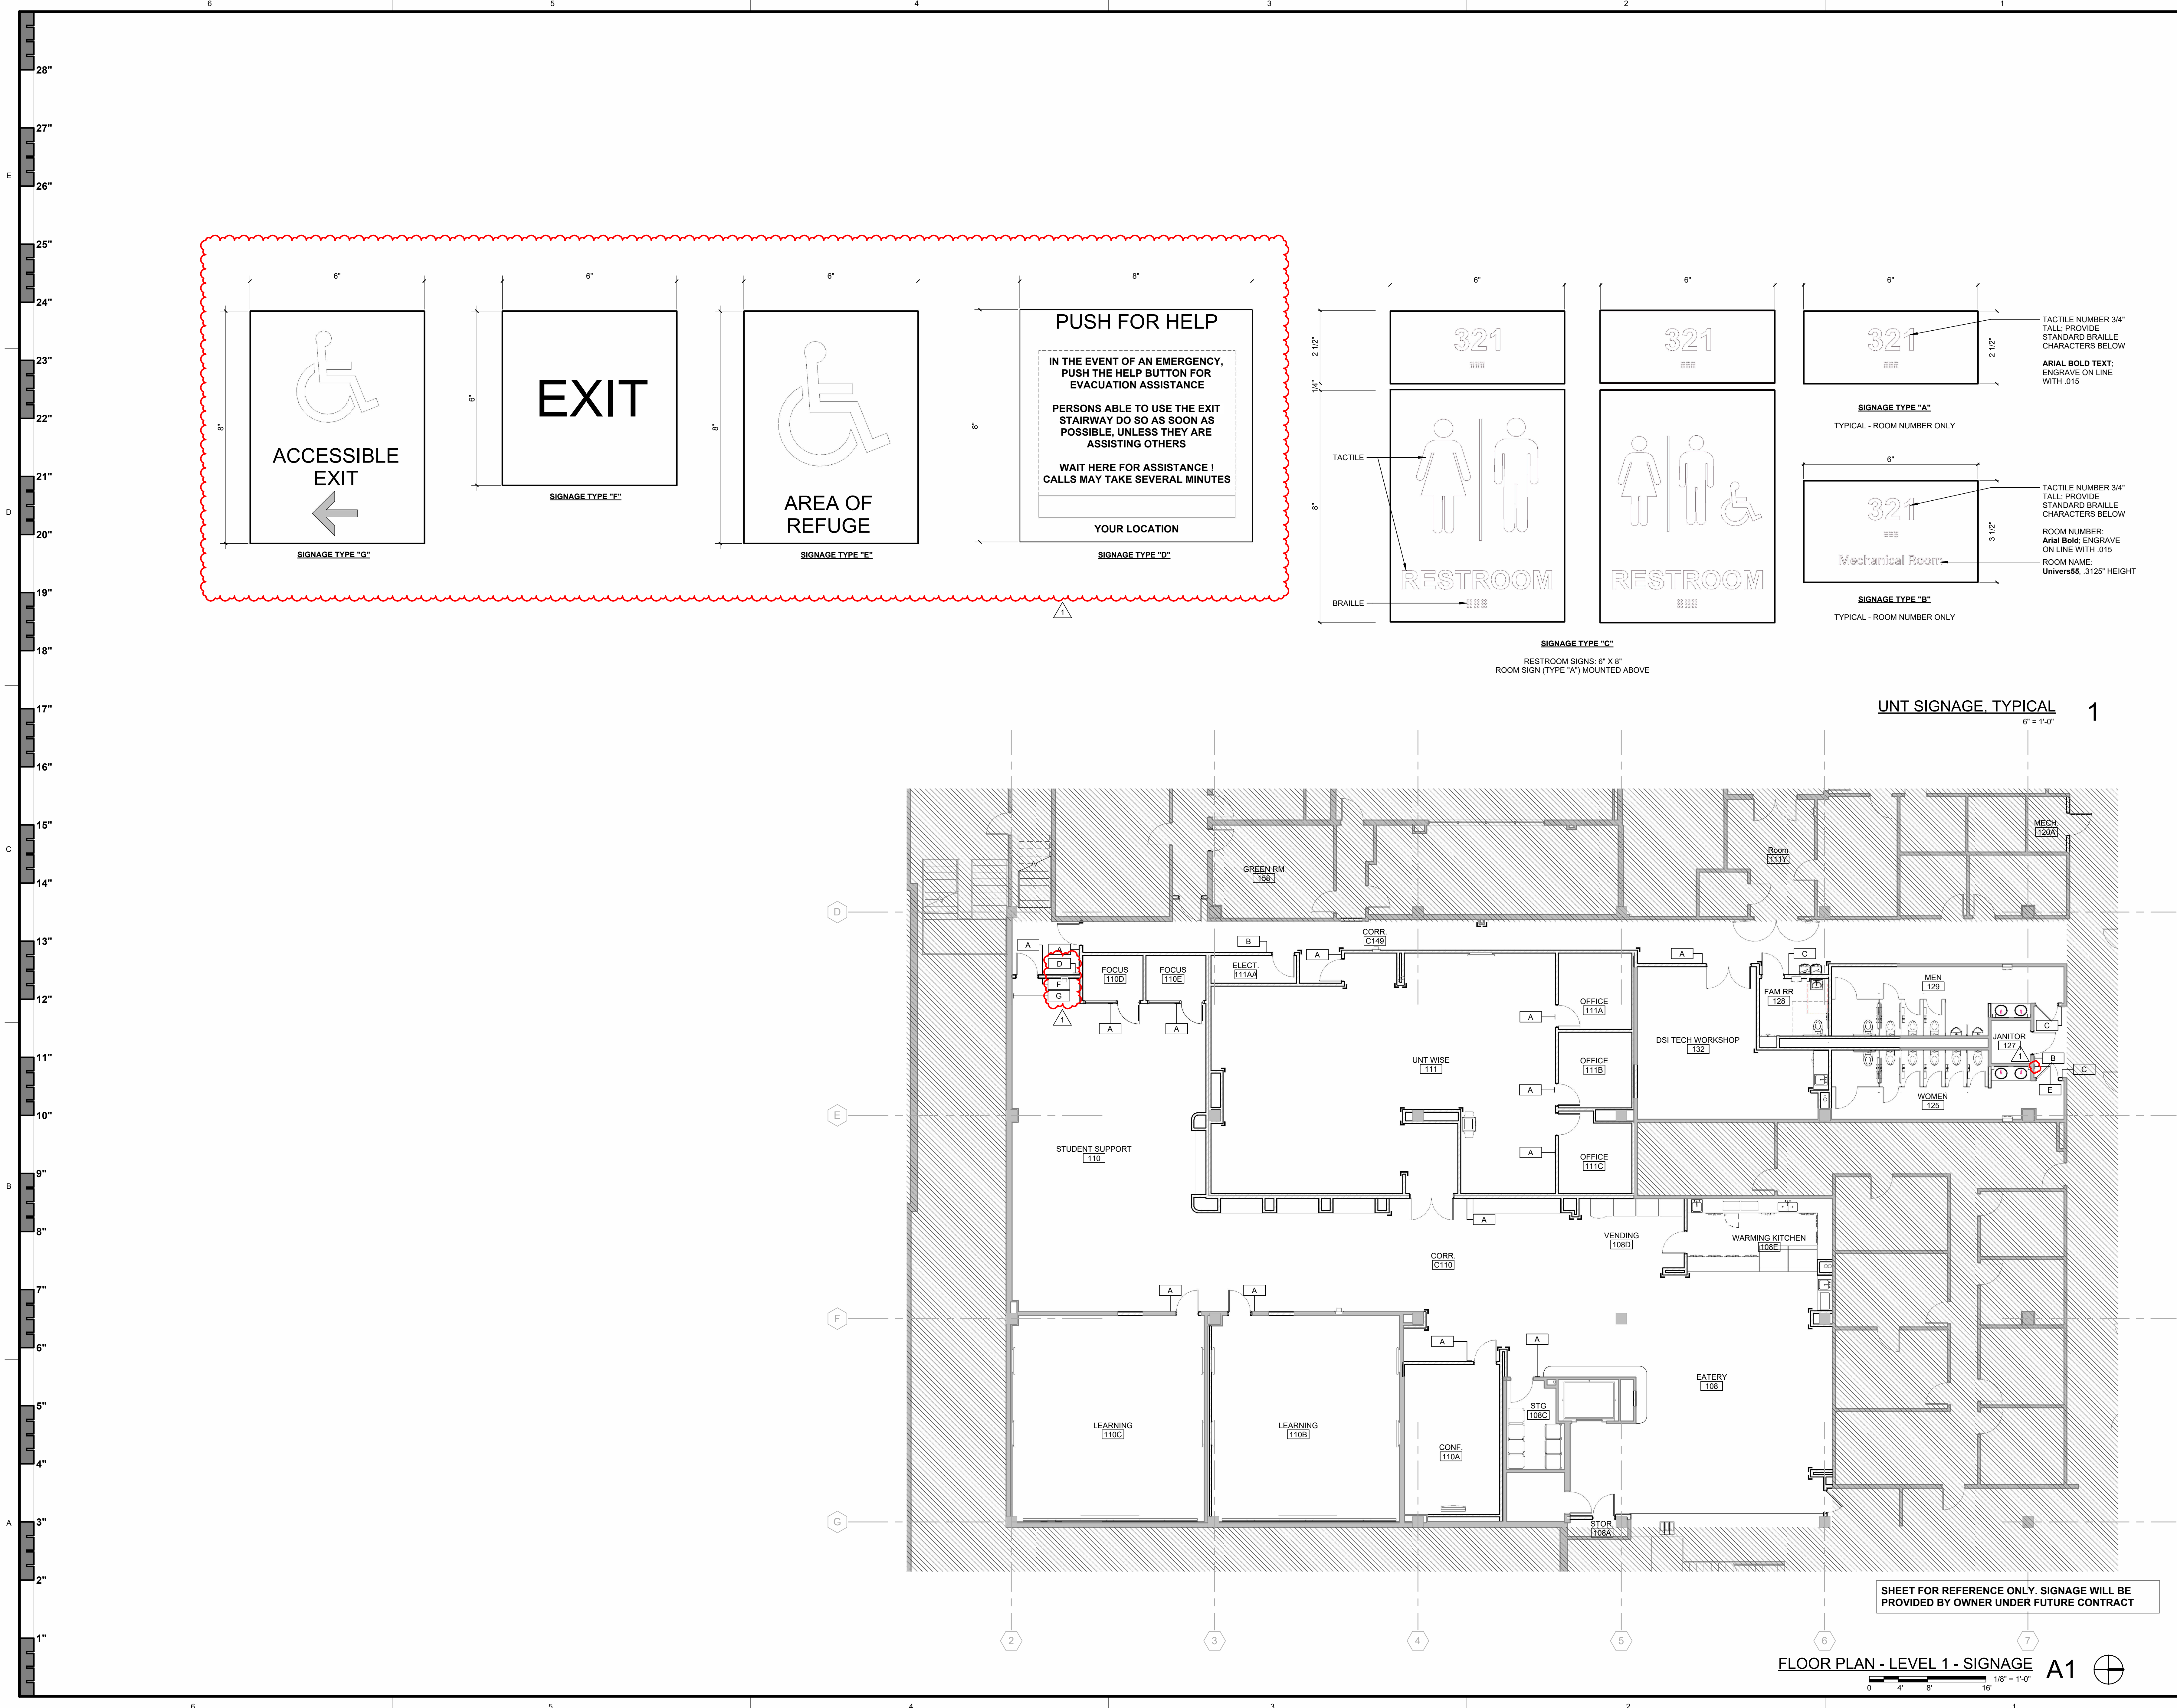

2554 Elm Street, Suite 200
Dallas, TX 75226
Phone: 214.752.0118
www.treanor.com

UNIVERSITY OF NORTH TEXAS
CHILTON HALL LEVEL 1 RENOVATION
410 Avenue C
Denton, Texas 76201


This drawing is an instrument of service and shall remain the property of Treanor. This drawing and the concepts and ideas contained herein shall not be used, reproduced, revised, or related without the express written approval of Treanor, unless the Architect-Client agreement requires otherwise. Submission or distribution of this drawing to meet official or regulatory requirements or for other purposes in connection with the project is not to be construed as publication or derogation of any of the rights of Treanor.

Issued For: **ISSUE FOR CONSTRUCTION**
Date: 01/16/2025

REVISIONS		
NO	DESCRIPTION	DATE
1	ADDENDUM 1	02/27/2025

A801
SIGNAGE FLOOR PLAN
Treanor NO. HE0569 2401.00

Autodesk Docs | HE0569.2401.00 UNT Chilton Hall Level 1 Renovation_R04_BHB.rvt 2/27/2025 1:07:28 PM

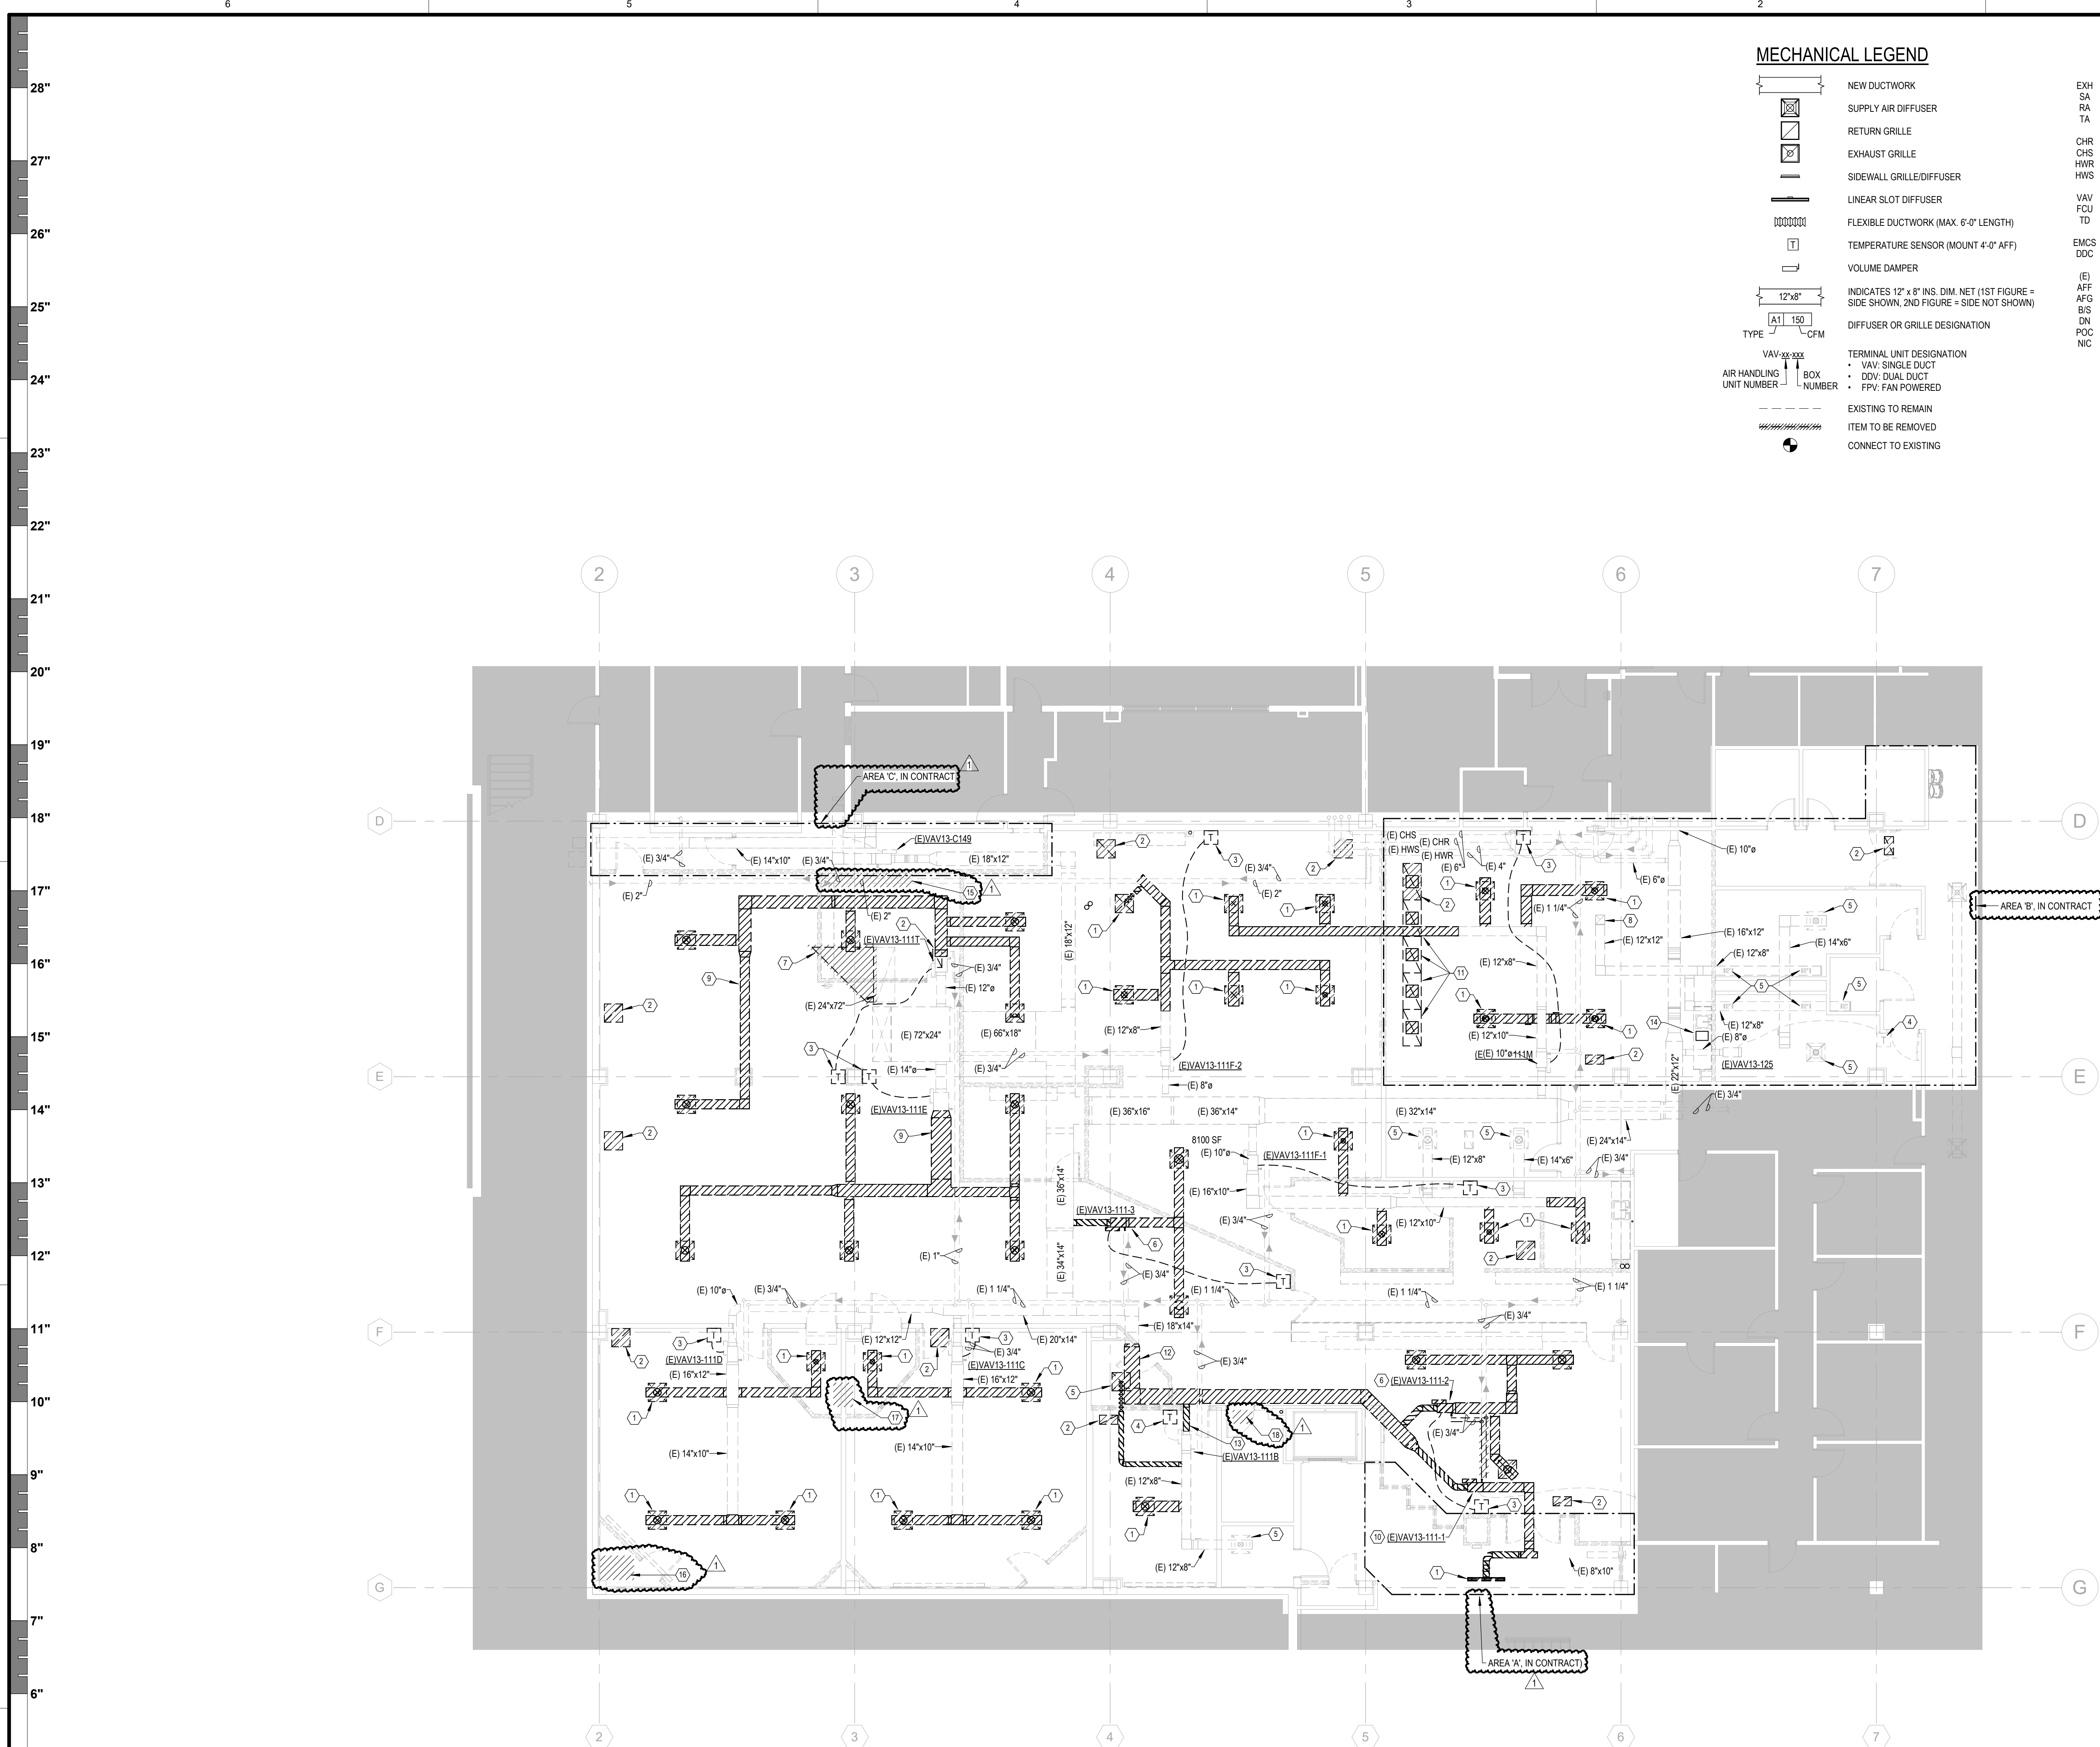

LEVEL 1 FLOOR PLAN - MECHANICAL DEMOLITION
1/8" = 1'-0"

0 4' 8' 16'



MECHANICAL LEGEND

	NEW DUCTWORK	EXH	EXHAUST AIR
	SUPPLY AIR DIFFUSER	SA	SUPPLY AIR
	RETURN GRILLE	RA	RETURN AIR
	EXHAUST GRILLE	TA	TRANSFER AIR
	SIDEWALL GRILLED DIFFUSER	CHR	CHILLED WATER RETURN
	LINEAR SLOT DIFFUSER	CHS	CHILLED WATER SUPPLY
	FLEXIBLE DUCTWORK (MAX. 6'-0" LENGTH)	HWR	HYDRONIC HEATING WATER RETURN
	TEMPERATURE SENSOR (MOUNT 4'-0" AFF)	HWS	HYDRONIC HEATING WATER SUPPLY
	VOLUME DAMPER	VAV	VARIABLE AIR VOLUME
	INDICATES 12" x 8" INS. DIM. NET (1ST FIGURE = SIDE SHOWN, 2ND FIGURE = SIDE NOT SHOWN)	FCU	FAN COIL UNIT
	TERMINAL UNIT DESIGNATION	TD	TRANSFER AIR DEVICE
	• VAV: SINGLE DUCT • DDV: DUAL DUCT • FPV: FAN POWERED	EMCS	ENERGY MANAGEMENT CONTROLS SYSTEM
	EXISTING TO REMAIN	DDC	DIRECT DIGITAL CONTROL
	ITEM TO BE REMOVED	(E)	EXISTING TO REMAIN
	CONNECT TO EXISTING	AFF	ABOVE FINISHED FLOOR

NOTES BY SYMBOL: "E"

- EXISTING SUPPLY AIR DEVICE, BRANCH DUCTWORK AND ASSOCIATED ACCESSORIES TO BE REMOVED AS INDICATED. PREPARE DUCTWORK TO REMAIN FOR NEW CONNECTION.
- EXISTING RETURN AIR DEVICE TO BE REMOVED.
- EXISTING TEMPERATURE SENSOR TO BE REMOVED AND RELOCATED. CONTRACTOR SHALL PRESERVE AND PROTECT EXISTING SENSOR AND ASSOCIATED CONTROL WIRES. REFER TO 1M201 FOR NEW LOCATION.
- EXISTING TEMPERATURE SENSOR TO REMAIN.
- EXISTING AIR DEVICE AND ASSOCIATED DUCTWORK TO REMAIN.
- EXISTING TERMINAL UNIT, DUCTWORK, AIR DEVICES, AND ALL ASSOCIATED ACCESSORIES TO BE REMOVED.
- EXISTING RETURN AIR DUCTWORK AND ELBOW TO BE REMOVED. PREPARE EXISTING RETURN AIR DUCT RISER FOR NEW CONNECTION.
- EXISTING 12"x12" EXHAUST RISER TO REMAIN.
- EXISTING SUPPLY DUCTWORK, AIR DEVICE, AND ASSOCIATED ACCESSORIES TO BE REMOVED BACK TO EXISTING TERMINAL UNIT AS INDICATED. PREPARE TERMINAL UNIT TO REMAIN FOR NEW CONNECTION.
- EXISTING TERMINAL UNIT TO BE RELOCATED. REMOVE EXISTING SUPPLY DUCTWORK AS INDICATED AND PREPARE DUCTWORK TO REMAIN FOR NEW CONNECTION. REMOVE EXISTING 3/4" HWS/HWR BRANCH PIPING BACK TO EXISTING TEE AND CAP WATER TIGHT. CONTRACTOR SHALL PRESERVE AND PROTECT EXISTING TERMINAL UNIT, HWS/HWR VALVES, AND ASSOCIATED CONTROLS WIRING. REFER TO 1M101 AND 1M201 FOR NEW LOCATION.
- EXISTING RETURN AIR DEVICE TO BE RELOCATED FOR NEW CEILING LAYOUT. CONTRACTOR SHALL PRESERVE, PROTECT, AND THOROUGHLY CLEAN AIR DEVICE PRIOR TO REINSTALLATION. REFER TO 1M101 FOR NEW LOCATION.
- EXISTING SUPPLY AIR DUCTWORK TO BE REMOVED AS INDICATED. PREPARE DUCTWORK TO REMAIN FOR NEW CONNECTION.
- EXISTING 8" BRANCH DUCT TO EXISTING TERMINAL UNIT TO BE REMOVED. PREPARE EXISTING TERMINAL UNIT FOR NEW CONNECTION.
- EXISTING SPACE DEHUMIDIFIER TO BE RELOCATED. CONTRACTOR SHALL PRESERVE AND PROTECT DEHUMIDIFIER. REFER TO 1M101 FOR NEW LOCATION.
- EXISTING ABANDONED BASEBOARD HEATER SHALL BE REMOVED.
- EXISTING ABANDONED EXHAUST FAN SHALL BE REMOVED.
- EXISTING ABANDONED EXHAUST FAN CONTROL SWITCHES SHALL BE REMOVED.
- EXISTING ABANDONED VISTA CONTROLS BOX SHALL BE REMOVED.

DEMOLITION SHEET NOTES:

- CONTRACTOR SHALL PRESERVE AND PROTECT ALL EXISTING TEMPERATURE SENSORS AND THE ASSOCIATED CONTROL WIRES THAT ARE NOTED TO BE REMOVED AND RELOCATED.
- ANY VAV BOXES AND THEIR ASSOCIATED CONTROLLERS THAT ARE TO BE DEMOLISHED SHALL BE SALVAGED AND RETURNED TO THE OWNER. CONTRACTOR SHALL COORDINATE ITEM TYPE, QUANTITY, AND STORAGE LOCATION WITH THE OWNER.
- THIS BUILDING WILL BE OCCUPIED DURING THE CONSTRUCTION OF THIS PROJECT. CONTRACTOR SHALL CAREFULLY COORDINATE AND SCHEDULE ANY REQUIRED SHUTDOWNS WITH THE UNIVERSITY TO MINIMIZE DISTURBANCES TO BUILDING OCCUPANTS.
- ANY DUCTWORK THAT IS NOTED TO BE CAPPED AIR-TIGHT SHALL BE CAPPED PER SMACNA STANDARDS AND RECOMMENDATIONS. ALL DUCTWORK THAT IS NO LONGER TO BE USED SHALL BE REMOVED. NO ABANDONED DUCTWORK IS ALLOWED.
- AREAS NOT IN SCOPE OF WORK.

BHB
BAIRD, HAMPTON & BROWN
building partners

6300 Ridglea Pl., Ste. 700 Fort Worth, TX 76116
mail@bhbc.com • (817)338-1277 • bhbc.com
TBPBLS Firm #44, #10011300, #10011302, #10194146
BHB Project # 2023.029.003



TREANOR

2554 Elm Street, Suite 200
Dallas, TX 75201
Phone: (214) 742-0108
www.treanor.com

UNIVERSITY OF NORTH TEXAS

CHILTON HALL LEVEL 1 RENOVATION

410 Avenue C
Denton, Texas 76201



This drawing is an instrument of service and shall remain the property of Treanor. The drawing and the concepts and ideas contained herein shall not be used, reproduced, revised, or related without the express written approval of Treanor, unless the Architect-Client agreement requires otherwise.

Issued For: CONSTRUCTION

Date: 11/27/2024


REVISIONS		
NO	DESCRIPTION	DATE
1	ADDENDUM 1	02/27/25

MD101

LEVEL 1 FLOOR PLAN -
DEMO MECHANICAL

Treanor NO. HE0569.2401.00

Autodesk Docs/ME5656.2401.00 UNT Chilton Hall Level 1 Renovation_F04_BHB.rvt 2/27/2025 1:07:32 PM

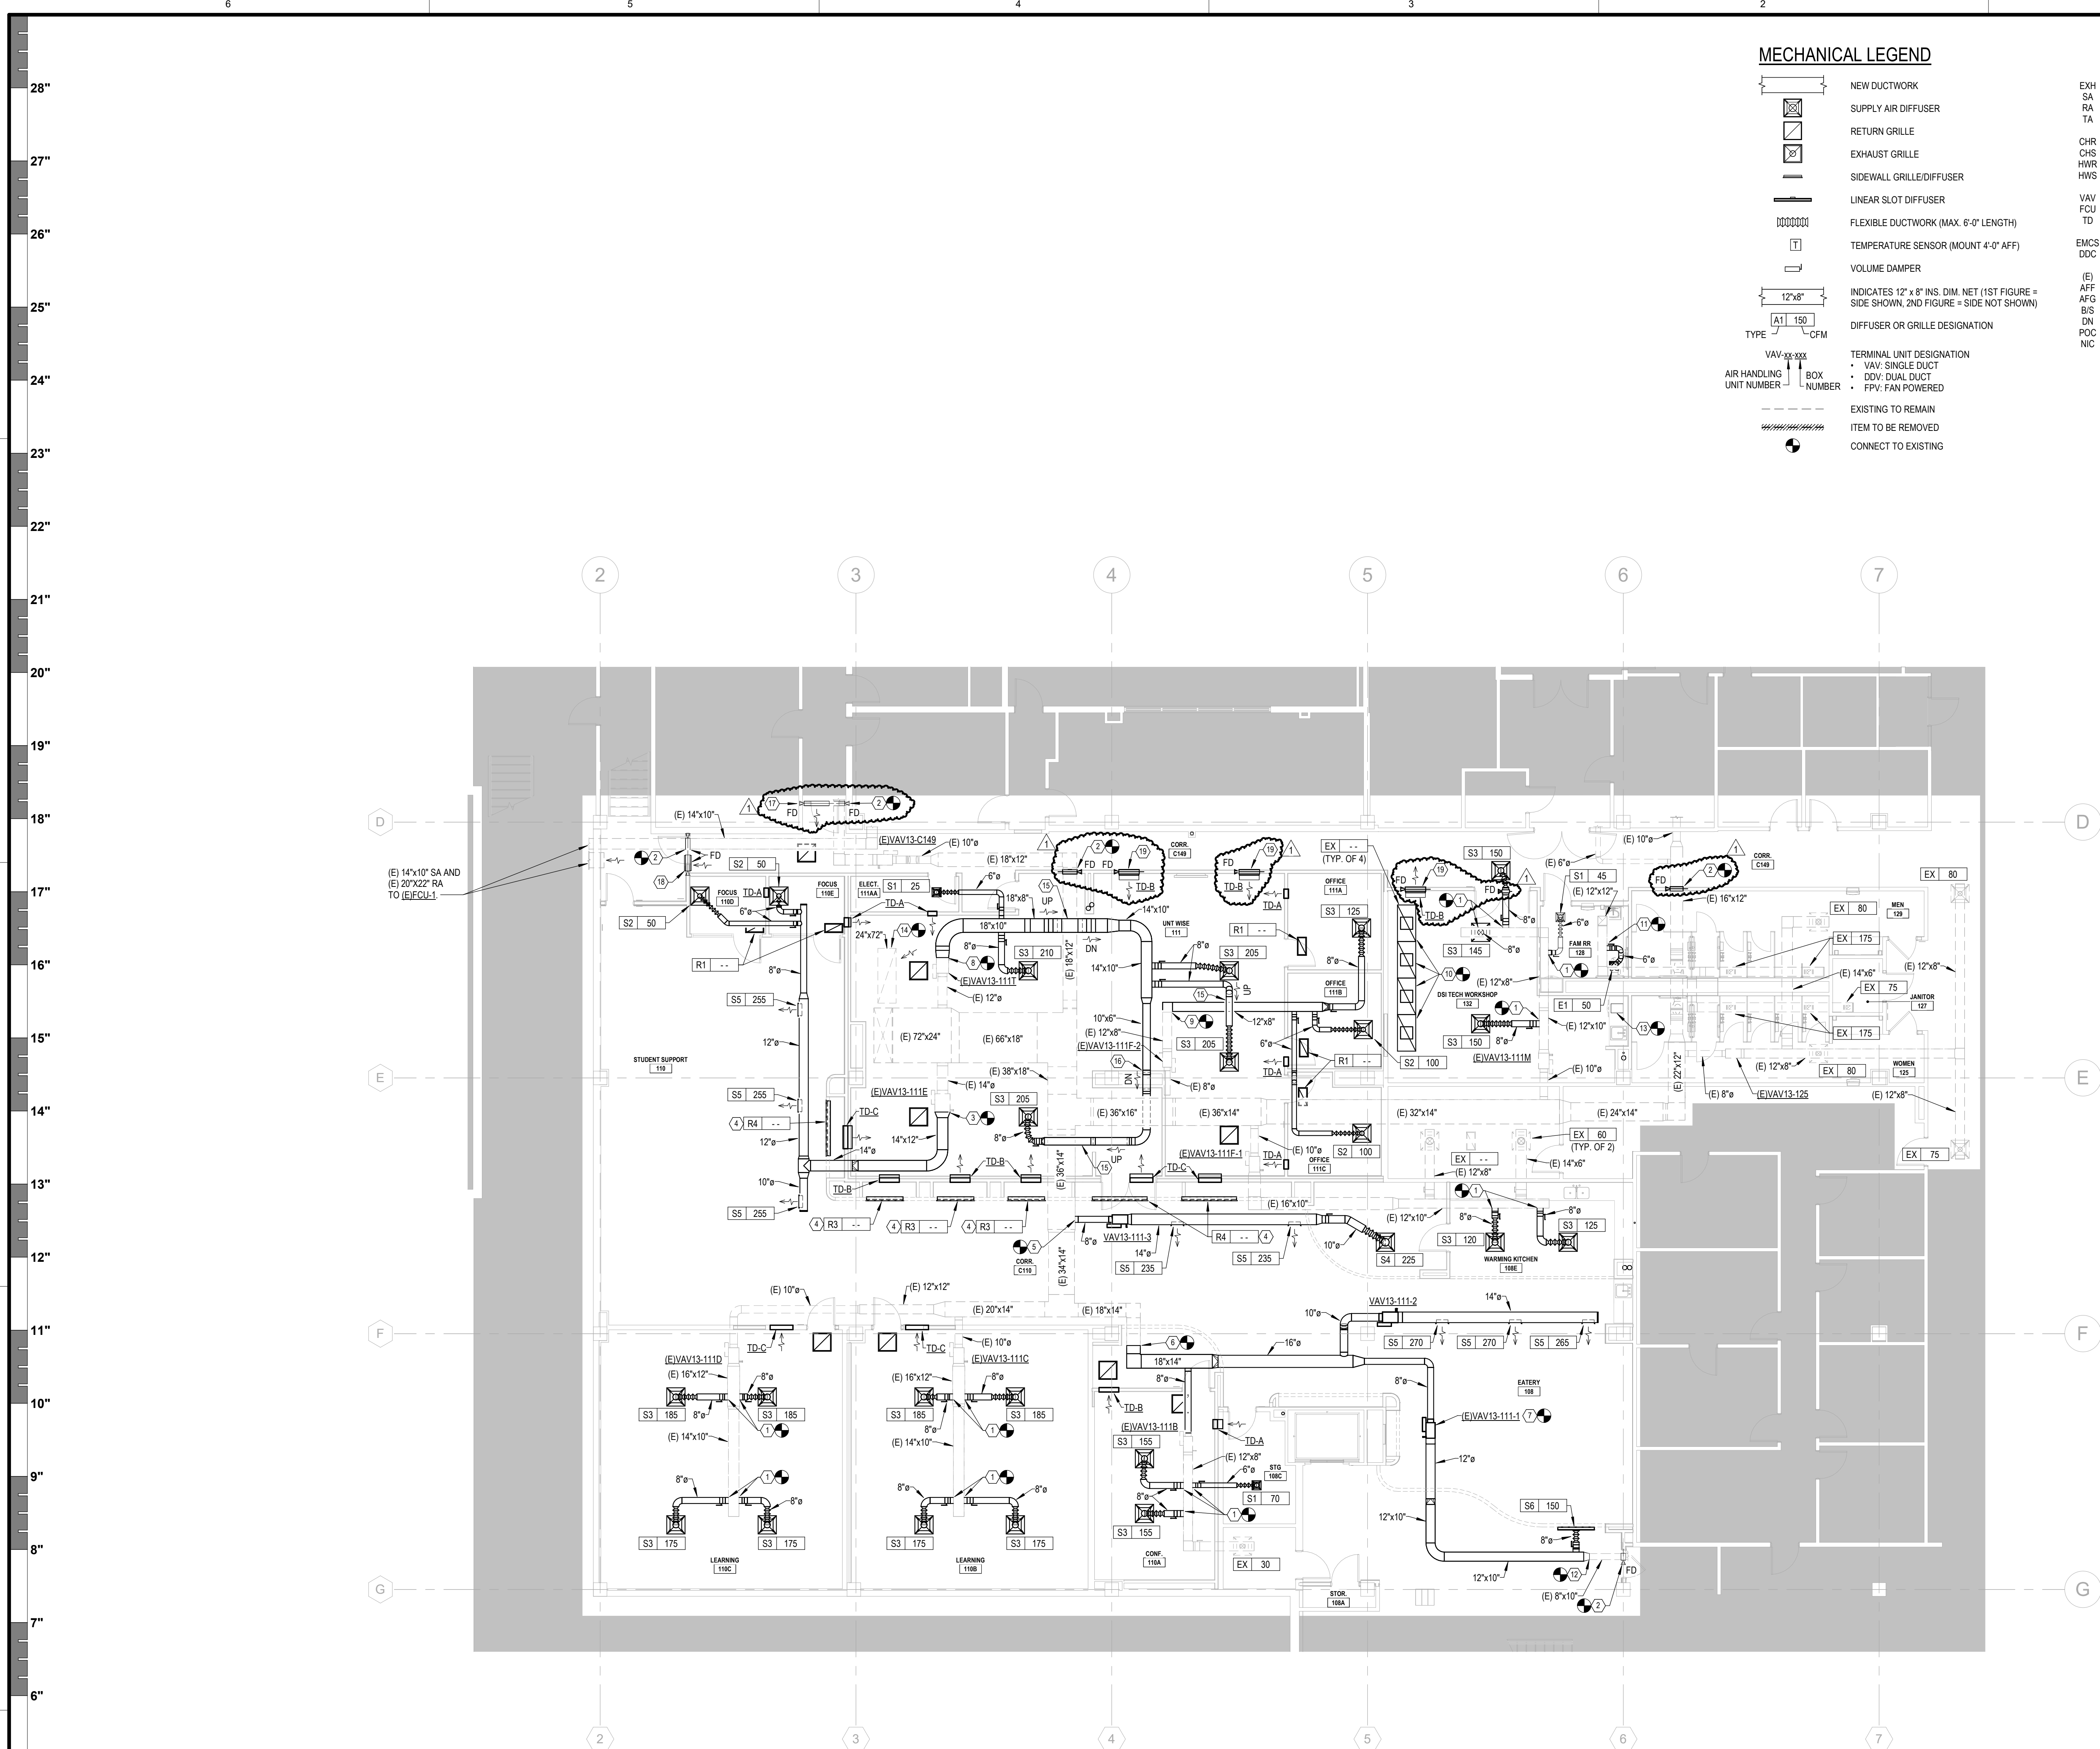

LEVEL 1 FLOOR PLAN - MECHANICAL

1/8" = 1'-0"

1

0 4' 8' 16'




MECHANICAL LEGEND

	NEW DUCTWORK	EXH	EXHAUST AIR
	SUPPLY AIR DIFFUSER	SA	SUPPLY AIR
	RETURN GRILLE	RA	RETURN AIR
	EXHAUST GRILLE	TA	TRANSFER AIR
	SIDE WALL GRILLED DIFFUSER	CHR	CHILLED WATER RETURN
	LINEAR SLOT DIFFUSER	CHS	CHILLED WATER SUPPLY
	FLEXIBLE DUCTWORK (MAX. 6'-0" LENGTH)	HWR	HYDRONIC HEATING WATER RETURN
	TEMPERATURE SENSOR (MOUNT 4'-0" AFF)	HWS	HYDRONIC HEATING WATER SUPPLY
	VOLUME DAMPER	VAV	VARIABLE AIR VOLUME
	INDICATES 12" x 8" INS. DIM. NET (1ST FIGURE = SIDE SHOWN, 2ND FIGURE = SIDE NOT SHOWN)	FCU	FAN COIL UNIT
	TERMINAL UNIT DESIGNATION	TD	TRANSFER AIR DEVICE
	VAV: SSS (S: SINGLE DUCT)	EMCS	ENERGY MANAGEMENT CONTROLS SYSTEM
	VAV: DDS (D: DUAL DUCT)	DOC	DIRECT DIGITAL CONTROL
	VAV: FPP (F: FAN POWERED)	(E)	EXISTING TO REMAIN
	EXISTING TO REMAIN	AFG	ABOVE FINISHED FLOOR
	ITEM TO BE REMOVED	BLG	BELOW GRADE
	CONNECT TO EXISTING	DN	DOWN
		POC	POINT OF CONNECTION
		NIC	NOT IN CONTRACT

NOTES BY SYMBOL: "Ⓔ"

- CONNECT NEW SUPPLY AIR BRANCH DUCT TO (E) SUPPLY AIR DUCTWORK AND ROUTE ABOVE CEILING AS INDICATED TO NEW AIR DEVICE.
- PROVIDE AND INSTALL FIRE DAMPER IN (E) DUCTWORK AT PENETRATION OF NEW FIRE RATED PARTITION. CONFIRM LOCATION AND SIZE OF (E) DUCTWORK ON SITE.
- CONNECT 14"x12" SUPPLY DUCT TO (E)WAV13-111E AND ROUTE ABOVE CEILING AS INDICATED.
- RETURN AIR LINEAR BAR GRILLE WITH CONCEALED PLASTERED MUD FRAME. CENTERLINE OF AIR DEVICE SHALL BE INITIALLY SET AT 9'-6" AFF. CONFIRM WITH ARCHITECT PRIOR TO ROUGH-IN. CONCEALED PLASTERED MUD FRAME SHALL BE INSTALLED PRIOR TO WALL MUDDING AND PAINTING.
- CONNECT 8" SUPPLY DUCT TO (E) 36"x14" MAIN AND ROUTE AS INDICATED TO WAV13-111-3.
- CONNECT 18"x14" SUPPLY DUCT TO (E) 18"x14" MAIN AND ROUTE AS INDICATED.
- REINSTALL (E)WAV13-111-1. ROUTE NEW 12" SUPPLY DUCT AS INDICATED. TRANSITION TO 12"x10" ABOVE WOOD SLAT CEILING.
- CONNECT 18"x10" SUPPLY DUCT TO (E)WAV13-111-1 AND ROUTE ABOVE CEILING AS INDICATED.
- CONNECT 12"x8" SUPPLY DUCT TO (E) 12"x8" MAIN AND ROUTE ABOVE CEILING AS INDICATED.
- THOROUGHLY CLEAN AND RE-INSTALL (E) RETURN AIR DEVICE. COORDINATE INSTALLED LOCATION WITH NEW CEILING GRID, FURNITURE LAYOUT, AND ARCHITECT PRIOR TO INSTALLING.
- CONNECT 6" EXHAUST DUCT TO (E) 12"x12" EXHAUST MAIN AND ROUTE ABOVE CEILING AS INDICATED.
- CONNECT 8"x10" SUPPLY DUCT TO (E) 8"x10" MAIN ABOVE CEILING.
- REINSTALL (E) SPACE DEHUMIDIFIER AND ROUTE FULL SIZE DRAIN FROM DEHUMIDIFIER DISCHARGE FULL SIZE DRAIN INDIRECT INTO HUB DRAIN BELOW (E) RELOCATED SINK. COORDINATE EXACT LOCATION ON SITE WITH OWNER PRIOR TO INSTALLATION.
- CONNECT 72"x24" ELBOW TO (E) 72"x24" RA RISER AND COVER OPENING WITH 3/4" STAINLESS-STEEL WIRE MESH.
- OFFSET DUCTWORK UP AND ROUTE OVER DUCTWORK AS REQUIRED.
- OFFSET DUCTWORK DOWN AND ROUTE UNDER DUCTWORK AS REQUIRED.
- PROVIDE 32"x20" TA OPENING WITH FIRE DAMPER ABOVE CEILING AS HIGH AS POSSIBLE.
- PROVIDE 20"x22" TA OPENING WITH FIRE DAMPER ABOVE CEILING AS HIGH AS POSSIBLE.
- TRANSFER AIR DUCT ABOVE THE CEILING WITH TRANSFER AIR SILENCER. REFER TO TRANSFER AIR DEVICE SCHEDULE ON SHEET M301 FOR MORE INFORMATION ON TRANSFER AIR DEVICE. PROVIDE AND INSTALL FIRE DAMPER AT RATED PARTITION PENETRATION.

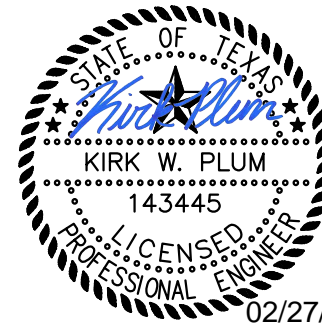

TREANOR

2554 Elm Street, Suite 200
Dallas, TX 75201
Phone: (214) 750-0108
www.treanor.design

UNIVERSITY OF NORTH TEXAS
CHILTON HALL LEVEL 1 RENOVATION
410 Avenue C
Denton, Texas 76201



This drawing is an instrument of service and shall remain the property of Treanor. This drawing and the concepts and ideas contained herein shall not be used, reproduced, revised, or related without the express written approval of Treanor, unless the Architect-Client agreement requires otherwise. Submission or distribution of this drawing to meet official or regulatory requirements or for other purposes in connection with this project is to be considered as publication in derogation of any of the rights of Treanor.

Issued For: CONSTRUCTION
Date: 01/16/2025

REVISIONS		
NO	DESCRIPTION	DATE
1	ADDENDUM 1	02/27/25

M101


LEVEL 1 FLOOR PLAN - MECHANICAL

Treanor NO. HE0569.2401.00

BHB
BAIRD, HAMPTON & BROWN
building partners

6300 Ridglea Pl., Ste. 700 Fort Worth, TX 76116
mail@bhinc.com • (817)338-1277 • bhinc.com
TBPCLS Firm #44, #10011300, #10011302, #10194146
BHB Project # 2023.029.003



Autodesk Docs | HE0569.2401.00 UNT Chilton Hall Level 1 Renovation_R04_BHB.rvt 2/27/2025 1:07:34 PM

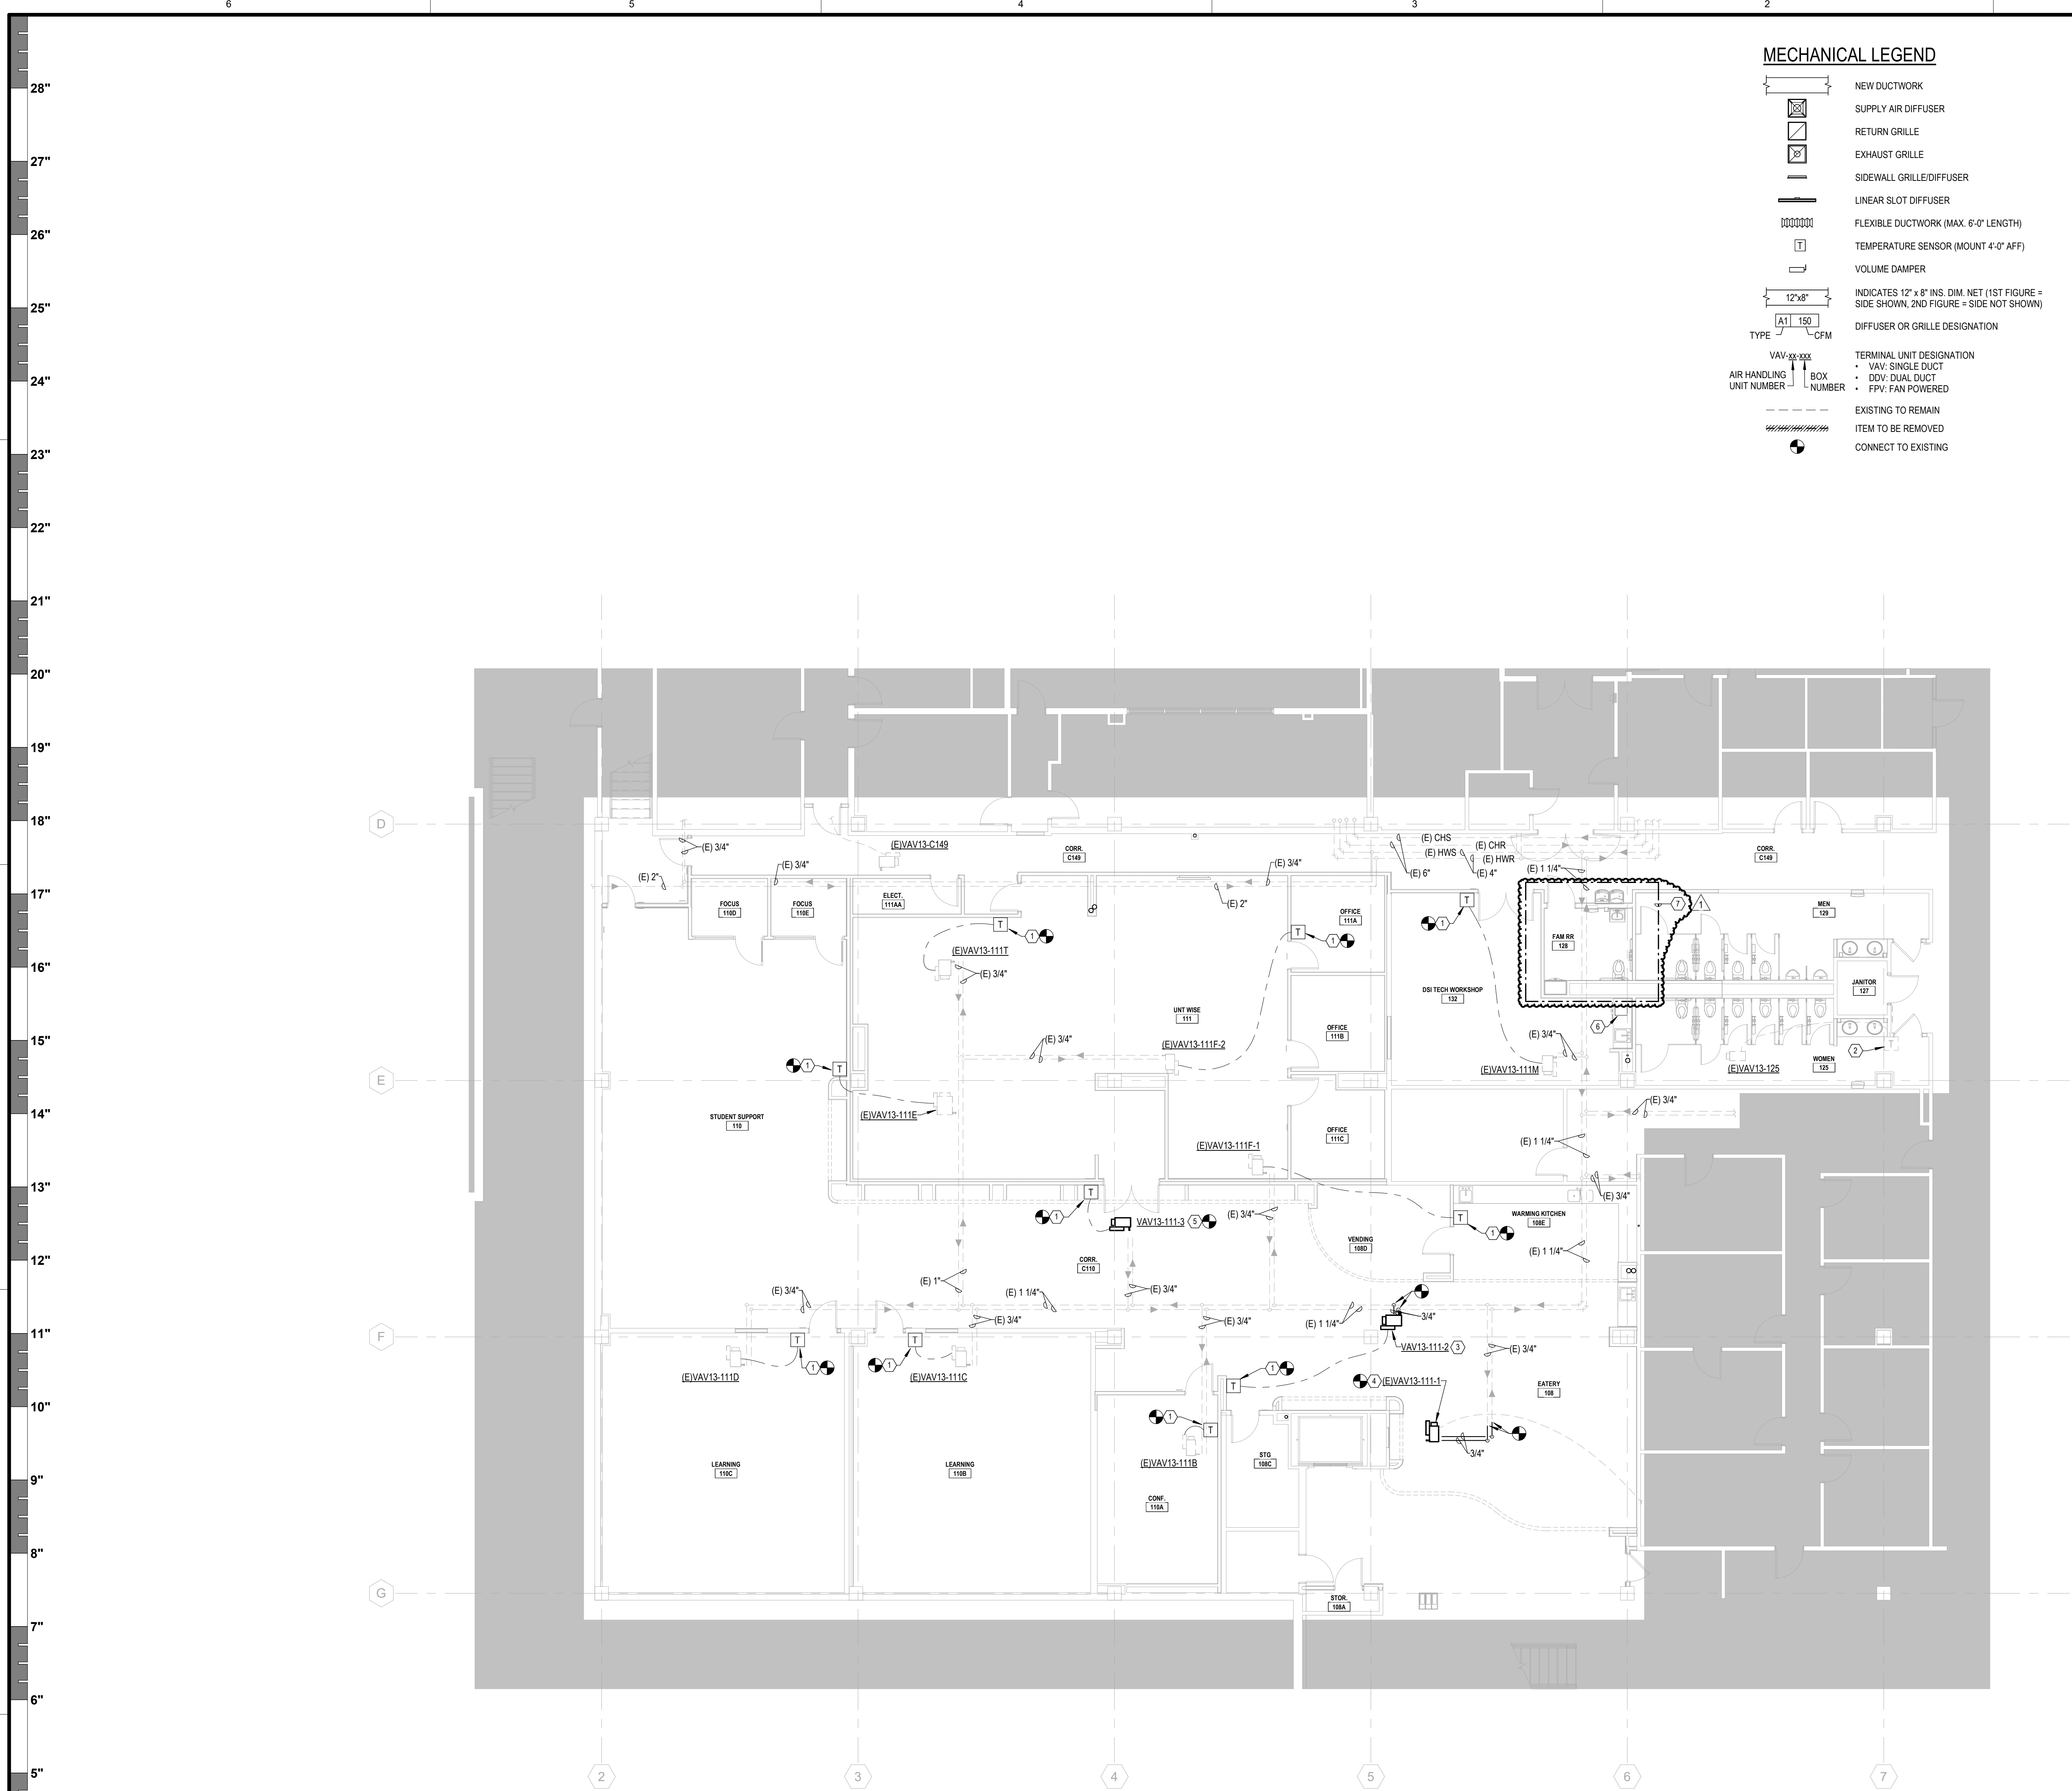

LEVEL 1 FLOOR PLAN - HYDRONIC AND CONTROLS

1/8" = 1'-0"

1

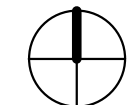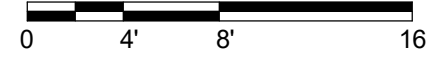

MECHANICAL LEGEND

	NEW DUCTWORK	EXH	EXHAUST AIR
	SUPPLY AIR DIFFUSER	SA	SUPPLY AIR
	RETURN GRILLE	RA	RETURN AIR
	EXHAUST GRILLE	TA	TRANSFER AIR
	SIDE WALL GRILLES/DIFFUSER	CHR	CHILLED WATER RETURN
	LINEAR SLOT DIFFUSER	CHS	CHILLED WATER SUPPLY
	FLEXIBLE DUCTWORK (MAX. 6'-0" LENGTH)	HWR	HYDRONIC HEATING WATER RETURN
	TEMPERATURE SENSOR (MOUNT 4'-0" AFF)	HWS	HYDRONIC HEATING WATER SUPPLY
	VOLUME DAMPER	VAV	VARIABLE AIR VOLUME
	INDICATES 12" x 8" INS. DIM. NET (1ST FIGURE = SIDE SHOWN, 2ND FIGURE = SIDE NOT SHOWN)	FCU	FAN COIL UNIT
	DIFFUSER OR GRILLE DESIGNATION	TD	TRANSFER AIR DEVICE
	TERMINAL UNIT DESIGNATION	EMCS	ENERGY MANAGEMENT CONTROLS SYSTEM
	AIR HANDLING UNIT	DDC	DIRECT DIGITAL CONTROL
	EXISTING TO REMAIN	(E)	EXISTING TO REMAIN
	ITEM TO BE REMOVED	AFF	ABOVE FINISHED FLOOR
	CONNECT TO EXISTING	AFG	ABOVE FINISHED GRADE
		B/S	BELOW SLAB
		DN	DOWN
		POC	POINT OF CONNECTION
		NIC	NOT IN CONTRACT

NOTES BY SYMBOL: "Ⓔ"


- REINSTALL (E) RELOCATED TEMPERATURE SENSOR.
- (E) TEMPERATURE SENSOR TO REMAIN.
- CONNECT 3/4" HWSHWR TO (E) 1-1/4" HWSHWR AND ROUTE TO NEW VAV13-111.2. PROVIDE AND INSTALL ISOLATION SHUT-OFF VALVES PRIOR TO FINAL CONNECTION TO (E) 1-1/4" HWSHWR MAINS.
- CONNECT 3/4" HWSHWR TO (E) 3/4" HWSHWR AND ROUTE TO RELOCATED (E) VAV13-111.1. EXTEND AND RECONNECT (E) CONTROL WIRING TO (E) VAV13-111.1.
- CONNECT (E) 3/4" HWSHWR TO NEW VAV13-111.3.
- (E) RELOCATED SPACE DEHUMIDIFIER, REFER TO M101 FOR ADDITIONAL INFORMATION.
- EXISTING ABANDONED HYDRONIC PIPING ABOVE CEILING IN THIS AREA SHALL BE CAPPED WATER-TIGHT.

SHEET NOTES:

- LOCATIONS OF TEMPERATURE SENSORS SHALL BE COORDINATED WITH THE FURNITURE LAYOUT AND CONFIRMED WITH THE ARCHITECT/OWNER PRIOR TO ROUGH-IN. EXISTING TEMPERATURE SENSORS SHALL BE RELOCATED AS REQUIRED TO COMPLY WITH TEXAS ACCESSIBILITY STANDARDS.
- MOUNT ALL TEMPERATURE SENSORS 4'-0" ABOVE FLOOR.
- AREAS NOT IN SCOPE OF WORK.
- ANY DUCTWORK, PIPING, AND CONTROL WIRING THAT IS NO LONGER TO BE USED SHALL BE REMOVED. NO ABANDONED DUCTWORK, PIPING, OR CONTROL WIRING IS ALLOWED. ANY EXISTING ABANDONED PNEUMATIC CONTROLS SHALL BE REMOVED.
- ALL EXISTING VAV BOXES TO REMAIN SHALL BE RE-SUPPORTED PER 1M301.

BHB
BAIRD, HAMPTON & BROWN
building partners

6300 Ridglea Pl., Ste. 700 Fort Worth, TX 76116
mail@bhbc.com • (817)338-1277 • bhbc.com
TBPBLS Firm #44, #10011300, #10011302, #10194146
BHB Project # 2023.029.003

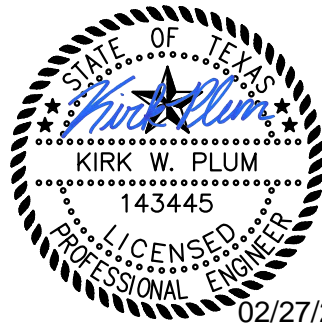

TREANOR

2554 Elm Street, Suite 200
Dallas, TX 75201
Phone: 214.760.0108
www.treanor.com

UNIVERSITY OF NORTH TEXAS
CHILTON HALL LEVEL 1 RENOVATION
410 Avenue C
Denton, Texas 76201



This drawing is an instrument of service and shall remain the property of Treanor. This drawing and the concepts and ideas contained herein shall not be used, reproduced, revised, or related without the express written approval of Treanor, unless the Architect-Client agreement requires otherwise. Submission or distribution of this drawing to meet official or regulatory requirements or for other purposes in connection with this project is to be considered as publication in derogation of any of the rights of Treanor.

Issued For: CONSTRUCTION

Date: 01/16/2025

REVISIONS		
NO	DESCRIPTION	DATE
1	ADDENDUM 1	02/27/25

M201

LEVEL 1 FLOOR PLAN -
HYDRONIC AND
CONTROLS

Treanor NO. HE0569.2401.00

Autodesk Docs\\HE0569.2401.00 UNIT Chilton Hall Level 1 Renovation\\P04_1BHB.rvt 2/27/2025 1:07:37 PM


MAXIMUM PIPE SUPPORT SPACING, FEET														
NOM. PIPE SIZE	THRU 3/4"	1	1-1/4	1-1/2	2	2-1/2	3	4	5	6	8	10	12	14
SPACING	7 FT	7	8	9	10	11	12	14	16	17	19	22	25	27
NOTE: FOR TRAPEZE HANGER TAKE SPACING OF SMALLEST PIPE SIZE ON TRAPEZE														

PIPE HANGER DETAILS


NOT TO SCALE

3

ADJUSTABLE CLEVIS HANGER

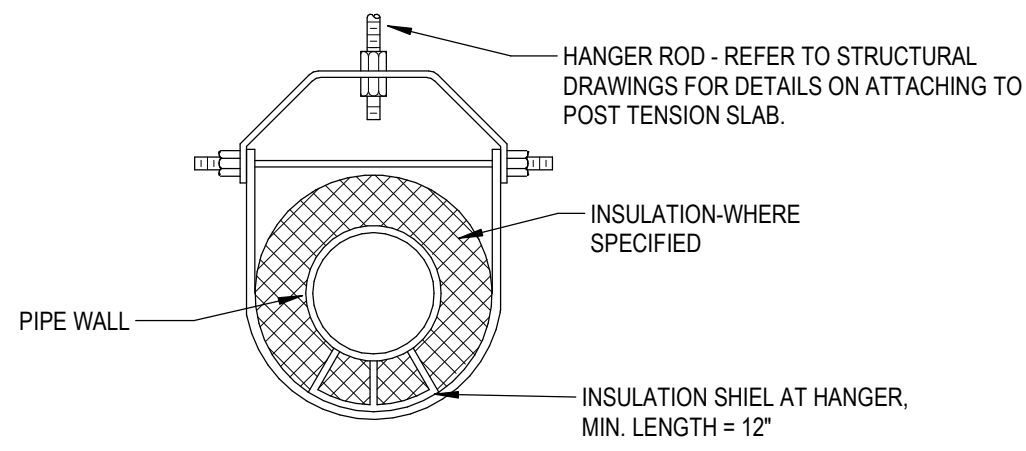

ADJUSTABLE ROLLER HANGER

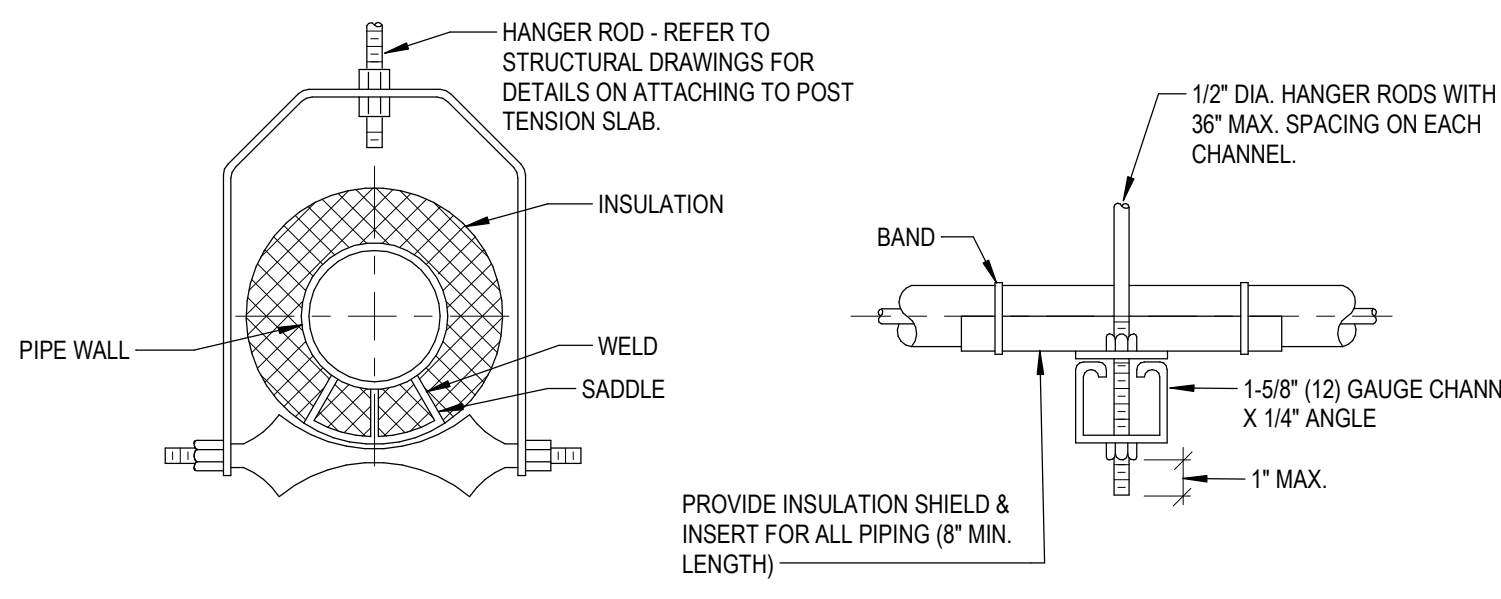

SIDE VIEW

TRAPEZE HANGER FOR UP TO 1000 LB. UNIFORM LOAD

TERMINAL UNIT DETAIL (VAV w/HYDRONIC RE-HEAT)

NOT TO SCALE

1

VARIABLE AIR VOLUME UNIT CONTROL DIAGRAM

NOT TO SCALE

2

FIRE DAMPER INSTALLATION DETAIL

NOT TO SCALE

4

TYPICAL FLEX CONNECTION DETAIL

NOT TO SCALE

5

TRANSFER AIR DEVICE SCHEDULE

TAG	SIZE W/ 1\"/>
TD-A	12\"/>
TD-B	26\"/>
TD-C	30\"/>

NOTES:

- ALL TRANSFER AIR DEVICES EXPOSED TO VIEW, SHALL BE PAINTED TO MATCH SURROUNDING CONDITIONS. COORDINATE COLOR WITH ARCHITECT.
- ALL TRANSFER AIR DEVICES SHALL HAVE FIBER FREE FOAM ACOUSTIC MEDIA.
- ALL TRANSFER AIR DEVICES SHALL HAVE A PRIME COAT FINISH.

BHB
BAIRD, HAMPTON & BROWN
building partners

6300 Ridglea Pl., Ste. 700 Fort Worth, TX 76116
mail@bhbc.com • (817)338-1277 • bhbc.com
TBPCLS Firm #44, #10011300, #10011302, #10194146
BHB Project # 2023.029.003

M301

MECHANICAL
SCHEDULES AND
DETAILS

Treanor NO. HE0569.2401.00

UNIVERSITY OF NORTH TEXAS

CHILTON HALL LEVEL 1 RENOVATION

410 Avenue C
Denton, Texas 76201



This drawing is an instrument of service and shall remain the property of Treanor. This drawing and the concepts and ideas contained herein shall not be used, reproduced, revised, or retained without the express written approval of Treanor, unless the Architect-Client agreement requires otherwise.
Submission or distribution of this drawing to meet official or regulatory requirements or for other purposes in connection with this project is not to be construed as publication in derogation of any of the rights of Treanor.

Issued For: CONSTRUCTION
Date: 01/16/2025

NO	DESCRIPTION	DATE
1	ADDENDUM 1	02/27/25

Treanor NO. HE0569.2401.00

TREANOR

2554 Elm Street, Suite 200
Dallas, TX 75226
Phone: (214) 742-0108
www.treanor.com



MECHANICAL GENERAL NOTES

- FURNISH AND INSTALL ALL MATERIALS AND LABOR REQUIRED TO PROVIDE COMPLETE AND OPERABLE HVAC SYSTEMS WITH ALL ITEMS AND APPURTENANCES NECESSARY EVEN THOUGH NOT SPECIFICALLY IDENTIFIED.
- ALL WORK AND/OR MATERIALS SHALL BE INSTALLED BY A LICENSED CONTRACTOR AND SHALL CONFORM TO ALL APPLICABLE NATIONAL AND LOCAL BUILDING AND MECHANICAL CODES.
- ALL DUCTWORK SHALL BE FABRICATED AND INSTALLED IN ACCORDANCE WITH SMACNA STANDARDS. INSTALL TURNING VANES IN ALL DUCTWORK ELBOWS.
- WHERE DUCTWORK IS INDICATED TO BE EXPOSED TO VIEW IN OCCUPIED SPACES, PROVIDE MATERIALS THAT ARE FREE FROM VISUAL IMPERFECTIONS INCLUDING FITTING, SEAM MARKS, ROLLER MARKS, AND STAINS AND DISCOLORATIONS, AND OTHER IMPERFECTIONS, INCLUDING THOSE THAT WOULD IMPAIR PAINTING.
- ALL INTERIOR DUCTS SHALL BE CONSTRUCTED WITH G-60 OR BETTER GALVANIZED STEEL (ASTM A 653A 653M) LFGQ. CHEM TREAT EXTERIOR DUCTWORK OR DUCT EXPOSED TO HIGH HUMIDITY CONDITIONS (I.E. MOISTURE LADEN EXHAUSTS NOT SPECIFIED TO BE STAINLESS STEEL) SHALL BE G-90 OR BETTER GALVANIZED STEEL LFGQ CHEM TREAT.
- COORDINATE EXACT ROUTING OF ALL WORK WITH ALL OTHER TRADES PRIOR TO INSTALLATION OF WORK.
- MECHANICAL CONTRACTOR SHALL COORDINATE EXACT LOCATION AND ROUTING OF DUCTWORK WITH REFLECTED CEILING PLANS AND ELECTRICAL LIGHTING LAYOUT. MECHANICAL CONTRACTOR SHALL COORDINATE EXACT LOCATION OF ALL AIR DEVICES WITH REFLECTED CEILING PLANS AND ELECTRICAL LIGHTING AND OTHER PLAYS.
- ALL SUPPLY AND RETURN AIR DUCTWORK SHALL BE INSULATED WITH 2" THICK, 0.75 LB/CFZ (MINIMUM) FSK WRAP INSULATION (MINIMUM INSTALLED R-VALUE = R-6).
- FLEXIBLE DUCTWORK RUNOUTS SHALL BE LIMITED TO 6' EXTENDED LENGTH. FLEXIBLE DUCTWORK SHALL BE EQUAL TO ATCO #306. FLEXIBLE DUCTS, BOTH SUPPLY AND RETURN, SHALL HAVE INSULATION WITH A MINIMUM R-VALUE OF 6.0 PER IECC. DUCT SHALL HAVE A CONTINUOUS FLEXIBLE FIBERGLASS SHEATH WITH UL APPROVED METALIZED POLYESTER BARRIER JACKET.
- INSTALL FLEXIBLE DUCTWORK CONNECTIONS AT ALL DUCT CONNECTIONS TO TERMINAL UNITS AND FANS.
- ALL DUCT DIMENSIONS SHOWN ARE NET CLEAR INSIDE DIMENSIONS.
- MOUNT ALL TEMPERATURE SENSORS 4" 0" ABOVE FLOOR (TYPICAL).
- FOR ALL VOLUME DAMPERS LOCATED ABOVE A HARD CEILING, PROVIDE AND INSTALL A WORM GEAR REMOTE VOLUME DAMPER REGULATOR. INSTALL KEY ACCESS IN THE CEILING DIRECTLY BELOW THE DAMPER AND PAINT CAP TO MATCH CEILING.
- DO NOT ROUTE ANY DUCTWORK OVER ELECTRICAL PANELS OR I.T. SERVERS.
- ALL NEW DUCTWORK EXPOSED TO VIEW SHALL BE 1-1/2" INSULATED DOUBLE WALL GALVANIZED DUCT AND PAINT GRIP TYPE. THE COLOR AND EXTENT OF EXPOSED DUCTWORK OR EXISTING WRAP INSULATION TO BE PAINTED SHALL BE COORDINATED AND CONFIRMED WITH THE ARCHITECT.
- THE MECHANICAL CONTRACTOR SHALL COORDINATE WITH THE OWNER'S TESTING AND BALANCING AGENCY TO TEST AND BALANCE THE HVAC SYSTEMS. SYSTEMS SHALL BE BALANCED PER SPECIFICATION REQUIREMENTS. THE CONTRACTOR SHALL PLACE ALL SYSTEMS AND EQUIPMENT INTO FULL OPERATION FOR TESTING AND BALANCING. ONE COPY OF THE FINAL TEST AND BALANCE REPORT WITH THE ASBC NATIONAL PERFORMANCE GUARANTY SHALL BE SENT DIRECTLY TO THE ENGINEER OF RECORD. PROVIDE FIVE (5) ADDITIONAL COPIES TO THE CONTRACTOR.
- BRANCH DUCTS SHALL BE PROVIDED WITH A MANUAL VOLUME BALANCING DAMPER. ALL EXISTING AND NEW MANUAL VOLUME BALANCING DAMPERS WITHIN THE PROJECT AREA SHALL BE PROVIDED WITH ORANGE RIBBON ON THE HANDLE FOR TEST AND BALANCING.
- ALL EXISTING DUCTWORK TO REMAIN SHALL BE THOROUGHLY INSPECTED FOR DAMAGE AND AIR LEAKAGE. ALL OBSERVED DAMAGED DUCTWORK OR AIR LEAKAGE SHALL BE PATCHED OR REPAIRED, SEAL, AIR AND WATER TIGHT.
- CONTRACTOR SHALL INSPECT ALL EXISTING DUCTWORK TO REMAIN AND CONFIRM WHETHER THIS DUCTWORK IS PROVIDED WITH WRAP INSULATION OR IS INTERNALLY LINED. ANY DUCTWORK TO REMAIN THAT IS UNINSULATED SHALL BE PROVIDED WITH INSULATION PER THE SPECIFICATIONS. ADDITIONALLY, ALL EXISTING UNINSULATED PIPING TO REMAIN SHALL BE PROVIDED WITH INSULATION AS REQUIRED IN THE SPECIFICATIONS.
- FOR ALL PIPING AND DUCTWORK WITHIN THE PROJECT AREA, MISSING SECTIONS OF INSULATION SHALL BE PATCHED AND REPAIRED. USE INSULATION OF SAME THICKNESS AS EXISTING INSULATION. INSTALL NEW JACKET LAPPING AND SEALED OVER EXISTING.
- ALL VAV BOXES AND VALVES LOCATED ABOVE THE CEILING SHALL BE PROVIDED WITH AN IDENTIFICATION LABEL ON THE CEILING BELOW THE ITEM.

AIR DEVICE SCHEDULE


TAG	DESCRIPTION	OPPOSED SLATE DAMPER	FINISH	PRICE MODEL NO.
S1	12"x12" SQ. LOUVERED FACE CEILING DIFFUSER 6" NECK	NO	WHITE ENAMEL	SCD
S2	24"x24" SQ. LOUVERED FACE CEILING DIFFUSER 8" NECK	NO	WHITE ENAMEL	SCD
S3	24"x24" SQ. LOUVERED FACE CEILING DIFFUSER 8" NECK	NO	WHITE ENAMEL	SCD
S4	24"x24" SQ. LOUVERED FACE CEILING DIFFUSER 10" NECK	NO	WHITE ENAMEL	SCD
S5	16"x6" SPIRAL DUCT GRILLE EXTRUDED ALUMINUM FRAME 22" DEFLECTION	AIR SCOOP	PC12 PRIME COAT	SDGE
S6	4'-0" LONG LINEAR SLOT DIFFUSER WITH (2) 3/4" SLOTS AND INSULATED PLENUM	NO	WHITE ENAMEL	SDS75 w/ SDS75
R1	12"x24" PERFORATED FACE CEILING RETURN GRILLE 10"x22" NECK	NO	WHITE ENAMEL	PDDR
R2	24"x24" PERFORATED FACE CEILING RETURN GRILLE 22"x22" NECK	NO	WHITE ENAMEL	PDDR
R3	48"x6" LINEAR BAR GRILLE 1/8" BARS WITH 1/2" SPACING 15" DEFLECTION WITH CONCEALED PLASTER FRAME	NO	WHITE ENAMEL	LBPH WITH CPF
R4	72"x6" LINEAR BAR GRILLE 1/8" BARS WITH 1/2" SPACING 15" DEFLECTION WITH CONCEALED PLASTER FRAME	NO	WHITE ENAMEL	LBPH WITH CPF
E1	12"x12" PERFORATED FACE CEILING EXHAUST GRILLE 6" NECK	NO	WHITE ENAMEL	PDDR

NOTES:

- ALL SUPPLY DIFFUSERS LISTED AS LOUVERED FACE TYPE SHALL BE (4) CONE LOUVER TYPE.
- REFER TO ARCHITECTURAL DRAWINGS FOR CEILING TYPES.
- ALL AIR DEVICES INSTALLED IN GYP BOARD, PLASTER, OR OTHER HARD CEILING SHALL HAVE A SEPARATE MOUNTING FRAME.
- LINEAR SLOT DIFFUSERS SHALL HAVE AN INSULATED PLENUM AND BLACK PATTERN CONTROLLERS.
- SPIRAL DUCT GRILLES CURVED FRAME SHALL MATCH THE SUPPLY AIR DUCT RADIIUS.

Autodesk Docs/HE0569.2401.00 UNT Chilton Hall Level 1 Renovation_R04_BHB.rvt

2/27/2025 1:07:39 PM

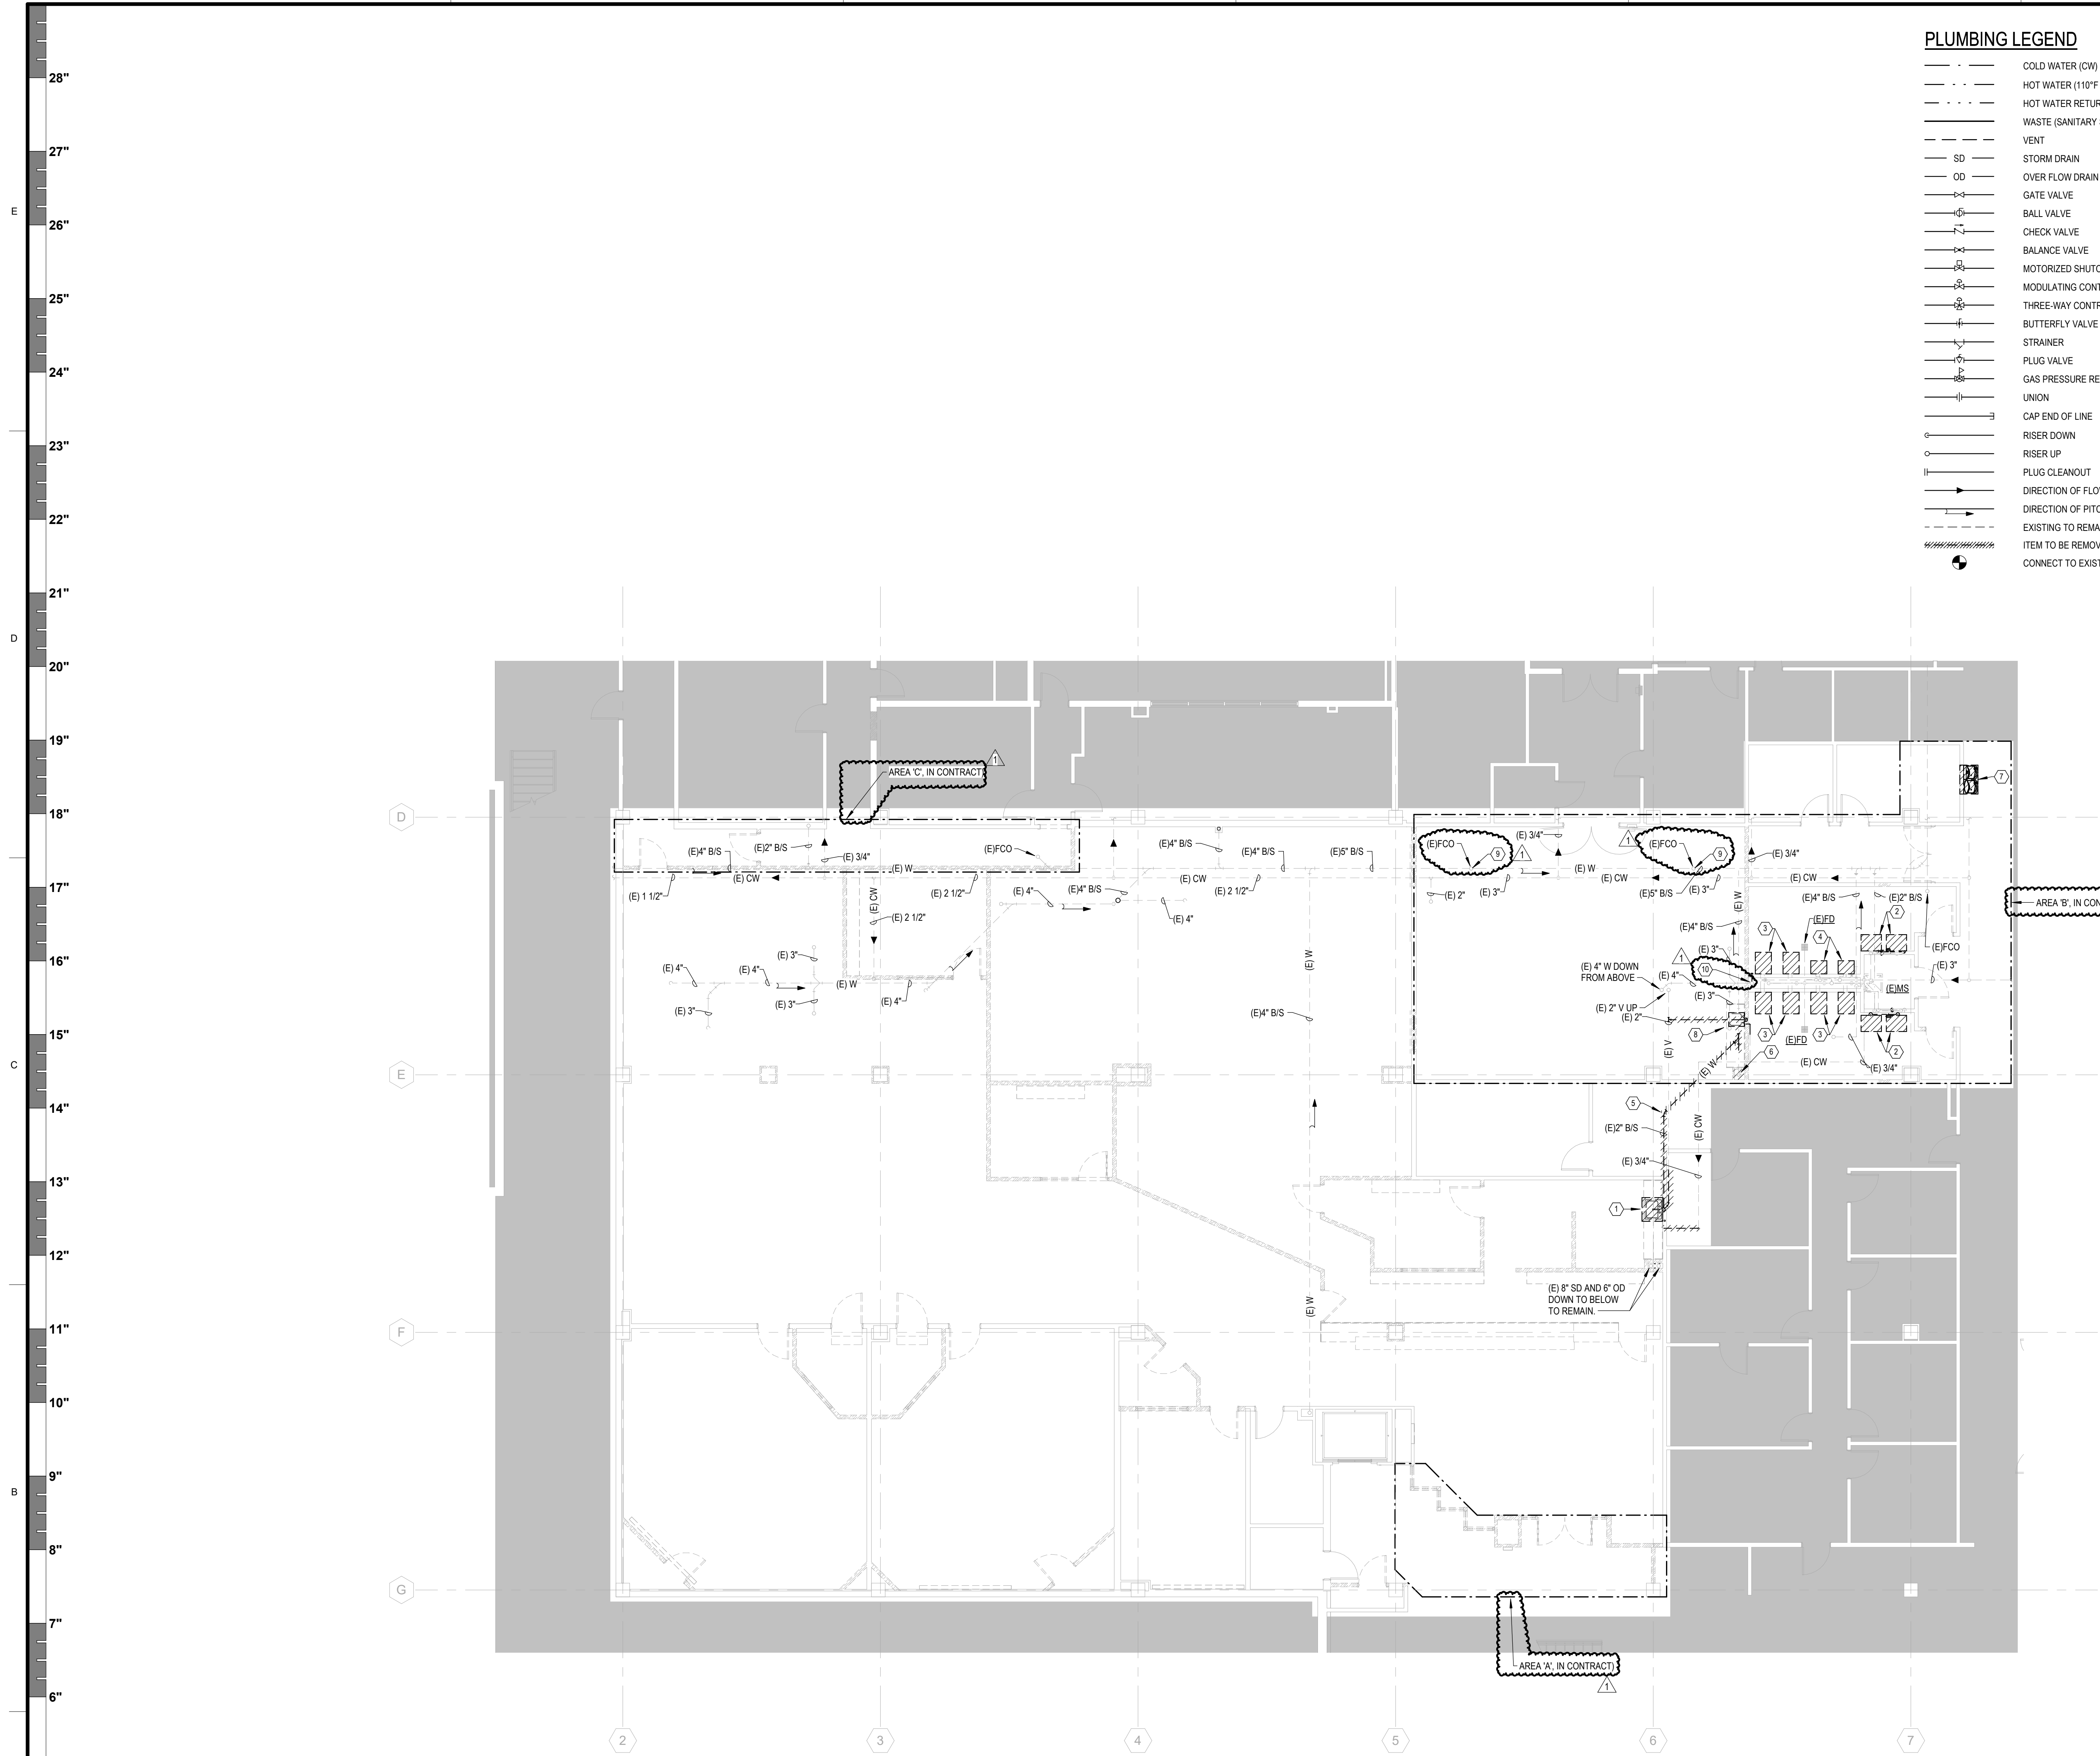

LEVEL 1 FLOOR PLAN - PLUMBING DEMOLITION

1/8\" = 1'-0"

0 4' 8' 16'



PLUMBING LEGEND

- COLD WATER (CW)
- HOT WATER (110°F HW)
- HOT WATER RETURN
- WASTE (SANITARY SEWER)
- VENT
- STORM DRAIN
- OVER FLOW DRAIN
- GATE VALVE
- BALL VALVE
- CHECK VALVE
- BALANCE VALVE
- MOTORIZED SHUTOFF VALVE
- MODULATING CONTROL VALVE
- THREE-WAY CONTROL VALVE
- BUTTERFLY VALVE
- STRAINER
- PLUG VALVE
- GAS PRESSURE REGULATOR
- UNION
- CAP END OF LINE
- RISER DOWN
- RISER UP
- PLUG CLEANOUT
- DIRECTION OF FLOW
- DIRECTION OF PITCH (DOWN)
- EXISTING TO REMAIN
- ITEM TO BE REMOVED
- CONNECT TO EXISTING

- FLOOR DRAIN
- GAUGE
- THERMOMETER
- PIPE WELL
- THERMOMETER WELL
- POINT-OF-USE MIXING VALVE
- WATER HAMMER ARRESTOR
- CLEANOUT
- FLOOR CLEANOUT
- WALL CLEANOUT
- OVERFLOW DRAIN
- ROOF DRAIN
- WASTE
- EXISTING TO REMAIN
- ABOVE FINISHED FLOOR
- BELOW SLAB
- INVERT ELEVATION
- POINT OF CONNECTION
- NOT IN CONTACT

NOTES BY SYMBOL: "①"

- REMOVE EXISTING SINK AND ALL ASSOCIATED UTILITIES. CAP EXISTING UTILITIES ABOVE CEILING WATER-TIGHT.
- REMOVE EXISTING LAVATORY, DOMESTIC COLD WATER, AND WASTE PIPING BACK TO WALL. PREPARE EXISTING PIPING TO REMAIN FOR NEW CONNECTION. REMOVE EXISTING TANKLESS WATER HEATER, PIPING, AND ALL ASSOCIATED ACCESSORIES.
- REMOVE EXISTING WATER CLOSET AND ALL ASSOCIATED UTILITIES BACK TO WALL. PREPARE EXISTING PIPING FOR NEW CONNECTION.
- REMOVE EXISTING URINAL AND ALL ASSOCIATED UTILITIES BACK TO WALL. PREPARE EXISTING PIPING FOR NEW CONNECTION.
- REMOVE EXISTING WASTE MAIN BELOW SLAB AS INDICATED. PREPARE PIPING TO REMAIN FOR NEW CONNECTION.
- REMOVE EXISTING 4\" WASTE RISER FROM FIRST FLOOR PENETRATION TO ABOVE CEILING AND PREPARE PIPING FOR NEW CONNECTION. INSTALL NEW FLOOR CLEANOUT AT EXISTING FIRST FLOOR PENETRATION.
- REMOVE EXISTING ELECTRIC WATER COOLERS AND ALL UTILITIES BACK TO ASSOCIATED MAINS. CAP EXISTING UTILITIES ABOVE CEILING WATER-TIGHT. PLUG AND CAP EXISTING WASTE PIPING IN WALL.
- EXISTING SINK TO BE REMOVED AND RELOCATED. CONTRACTOR SHALL PRESERVE AND PROTECT EXISTING SINK. REMOVE EXISTING UTILITIES BACK TO THEIR ASSOCIATED MAINS AND PREPARE PIPING FOR NEW CONNECTION. REFER TO 1P101 FOR NEW LOCATION.
- EXISTING FLOOR CLEANOUT SHALL BE REPLACED WITH NEW FLOOR CLEANOUT COMPATIBLE WITH NEW FLOORING.
- EXISTING COUPLINGS ON EXISTING WASTE PIPING SHALL BE REPLACED WITH HEAVY DUTY COUPLINGS CONFORMING TO ASTM C 1540 AS MANUFACTURED BY HUSKY SD 4000.

SHEET NOTES:

- THIS BUILDING WILL BE OCCUPIED DURING THE CONSTRUCTION OF THIS PROJECT. CONTRACTOR SHALL CAREFULLY COORDINATE AND SCHEDULE ANY REQUIRED SHUTDOWNS WITH THE UNIVERSITY TO MINIMIZE DISRUPTIONS TO BUILDING OCCUPANTS.
- AREAS NOT IN SCOPE OF WORK.
- ANY PIPING THAT IS NO LONGER TO BE USED SHALL BE REMOVED. NO ABANDONED PIPING IS ALLOWED.
- EXISTING RUBBER CAPS ON EXISTING CHEMICAL WASTE PIPING SHALL BE REPLACED WITH NEW CAPS OF SAME MATERIAL AS EXISTING PIPING.
- EXISTING ACCESS PANELS SHALL BE MAINTAINED WITHIN NEW WALLS TO ALLOW FOR REQUIRED ACCESS TO VALVES.

BHB
BAIRD, HAMPTON & BROWN
building partners

6300 Ridglea Pl., Ste. 700 Fort Worth, TX 76116
mail@bhbc.com • (817)338-1277 • bhbc.com
TBP&S Firm #44, #10011300, #10011302, #10194146
BHB Project # 2023.029.003



TREANOR

2554 Elm Street, Suite 200
Dallas, TX 75201
Phone: 214.761.0108
www.treanor.com

UNIVERSITY OF NORTH TEXAS
CHILTON HALL LEVEL 1 RENOVATION

410 Avenue C
Denton, Texas 76201



This drawing is an instrument of service and shall remain the property of Treanor. This drawing and the concepts and ideas contained herein shall not be used, reproduced, revised, or retained without the express written approval of Treanor, unless the Architect-Client agreement requires otherwise. Submission or distribution of this drawing to meet official or regulatory requirements or for other purposes in connection with the project is prohibited as a violation in derogation of any of the rights of Treanor.

Issued For: CONSTRUCTION

Date: 11/21/2024

REVISIONS		
NO	DESCRIPTION	DATE
1	ADDENDUM 1	02/27/25

PD101

LEVEL 1 FLOOR PLAN -
DEMO PLUMBING


Treanor NO. HE0569.2401.00

WATER HEATER SCHEDULE (ELECTRIC)										
TAG	LOCATION	VOLUME (GAL)	NUMBER ELEMENTS	ELEMENT WATTAGE	RATED KW	VOLTAGE	PHASE	RECOVERY RATE (GPH @ 80°F RISE)	MANUFACTURER	MODEL NO.
WH-1	120A - MECH	30	2	3,000	3,000	208	1	15	A. O. Smith	DEL-30
NOTES:										
1. PROVIDE SHUTOFF VALVE ON HOT AND COLD WATER LINE.										
2. PROVIDE EXPANSION TANK EQUAL TO AMTROL ST-05.										
3. ELEMENTS SHALL BE WIRED NON-SIMULTANEOUS.										


PLUMBING PUMP SCHEDULE									
TAG	TYPE	FLOW (GPM)	HEAD (FT)	MOTOR			MANUFACTURER	MODEL NO.	
				HP	RPM	VOLTAGE			
CP-1	IN-LINE	5	25	3/62	3300	115	1	Bel & Gossett	NBF-45

PLUMBING FIXTURE SCHEDULE						
TAG	FIXTURE	C	H	W	V	DESCRIPTION
WC-1	WATER CLOSET, WALL HUNG FLUSH VALVE, ACCESSIBLE	1"	-	4"	2"	AMERICAN STANDARD #3351-128 VITREOUS CHINA (1.28 GPF) ELONGATED TOILET WITH TOP SPUD. SLOW ROYAL #111-SFSM-128 (1.28 GPF) BATTERY POWERED AUTOMATIC FLUSH VALVE. CHURCH #9500CT OPEN FRONT SEAT WITH STA-TITE HINGES. TOP OF SEAT 17'-10" AFF.
WC-2	WATER CLOSET, WALL HUNG FLUSH VALVE	1"	-	4"	2"	AMERICAN STANDARD #3351-128 VITREOUS CHINA (1.28 GPF) ELONGATED TOILET WITH TOP SPUD. SLOW ROYAL #111-SFSM-128 (1.28 GPF) BATTERY POWERED AUTOMATIC FLUSH VALVE. CHURCH #9500CT OPEN FRONT SEAT WITH STA-TITE HINGES. TOP OF SEAT 15" AFF.
UR-1	URINAL, WALL HUNG FLUSH VALVE, ACCESSIBLE	3/4"	-	2"	2"	AMERICAN STANDARD #6590-025 VITREOUS CHINA, 0.125 GPF, ELONGATED RIM WITH TOP SPUD. SLOW ROYAL #106-SFSM-13 (0.125GPF) BATTERY POWERED AUTOMATIC FLUSH VALVE. MOUNT RIM 15'-10" AFF.
UR-2	URINAL, WALL HUNG FLUSH VALVE	3/4"	-	2"	2"	AMERICAN STANDARD #6590-025 VITREOUS CHINA, 0.125 GPF, ELONGATED RIM WITH TOP SPUD. SLOW ROYAL #106-SFSM-13 (0.125GPF) BATTERY POWERED AUTOMATIC FLUSH VALVE. MOUNT RIM 24" AFF.
L-1	LAVATORY, WALL HUNG ACCESSIBLE	1/2"	1/2"	2"	2"	AMERICAN STANDARD #0356-421 VITREOUS CHINA WALL LAVATORY WITH SINGLE CENTER FAUCET HOLE AND CONCEALED ARMS SUPPORT. SLOW #SF-2150-4-BAT-80M-CP-0.35GPM-MLM-R-FCT (0.35 GPM) BATTERY OPERATED FAUCET WITH MANUFACTURER'S ASSE 1070 BELOW DECK THERMOSTATIC MIXING VALVE, GRID STRAINER & P-TRAP. ADA INSULATION PACKAGE.
L-2	LAVATORY, UNDERCOUNTER MOUNT, ACCESSIBLE	1/2"	1/2"	2"	2"	KOHLER #K-2210-0 VITREOUS CHINA OVAL UNDERMOUNT LAVATORY. SLOW #SF-2150-4-BAT-80M-CP-0.35GPM-MLM-R-FCT (0.35 GPM) BATTERY OPERATED FAUCET WITH MANUFACTURER'S ASSE 1070 BELOW DECK THERMOSTATIC MIXING VALVE, GRID STRAINER & P-TRAP. ADA INSULATION PACKAGE.
S-1	DOUBLE COMPARTMENT SINK COUNTERTOP, ACCESSIBLE	1/2"	1/2"	2"	2"	ELKAY #LAD332269D, 18 GA. STAINLESS STEEL 30"x22"x6-1/2" DEEP COUNTERTOP SINK. DRAIN OPENING TO BE IN THE CENTER REAR LOCATION. 1/8" REC-3100-XP-F15 (1.5 GPM) BATTERY POWERED SENSOR FAUCET WITH ACDC CONTROL MODULE, 6" GOOSENECK SPOUT, VANDAL RESISTANT AERATOR, GRID STRAINER AND P-TRAP. ADA INSULATION PACKAGE.
S-2	SINGLE COMPARTMENT HAND SINK COUNTERTOP ACCESSIBLE	1/2"	1/2"	2"	2"	ELKAY #BLR1560, 18 GA. STAINLESS STEEL 15"x15"x6-1/8" DEEP COUNTERTOP SINK. DRAIN OPENING TO BE IN THE CENTER REAR LOCATION. 1/8" REC-3100-XP-F15 (1.5 GPM) BATTERY POWERED SENSOR FAUCET WITH ACDC CONTROL MODULE, 6" GOOSENECK SPOUT, VANDAL RESISTANT AERATOR, GRID STRAINER AND P-TRAP. ADA INSULATION PACKAGE.
FD-1	FLOOR DRAIN SQUARE TOP	-	-	SEE PLAN	2"	WATTS #FD-100-M COATED CAST IRON WITH ADJUSTABLE SQUARE NIKALOY STRAINER. FLOOR DRAIN SHALL HAVE INSIDE CAULK CONNECTION AND PROSET TRAP GUARD.
FS-1	FLOOR SINK HALF GRATE	-	-	SEE PLAN	2"	WATTS #FS-730 CAST IRON 12"x12"x6" DEEP SINK WITH ACID-RESISTANT COATING, FLANGE AND ALUMINUM INTERNAL DOME STRAINER. PROVIDE NIKALOY 1/2" GRATE. FLOOR SINKS SHALL HAVE INSIDE CAULK CONNECTION AND PROSET TRAP GUARD.
HD-1	HUB DRAIN	-	-	SEE PLAN	2"	WATTS #FD-100-DD COATED CAST IRON HUB ADAPTER AND MALE THREADED OUTLET.
ENC-1	ELECTRIC WATER COOLER WALL MOUNTED, TWO LEVEL ACCESSIBLE WITH BOTTLE FILLER	1/2"	-	1-1/2"	1-1/2"	HALSEY TAYLOR #HTB-HAC8BL-PV-HF, BARRIER FREE, TWO LEVEL, WALL MOUNTED WITH WATER FILTER AND BOTTLE FILLING STATION. CABINET SHALL BE VINYL CLAD STEEL, CHILD AND ADULT ADA COMPLIANT. COOLER SHALL DELIVER 8.0 GPH OF 50°F DRINKING WATER, 115/160HZ, UTILIZE R-134A REFRIGERANT. PROVIDE AND INSTALL "UPLIFTER" SKIRT UNDER THE HIGH EWC, HALSEY TAYLOR #98312C, AS REQUIRED BY ADA #117.1.
NOTES:						
1.	ALL FIXTURES SHALL MEET LOW WATER CONSUMPTION REQUIREMENTS.					
2.	PROVIDE STOPS AT ALL FIXTURES.					
3.	PROVIDE A COMPLETE PROSET TRAP GUARD SYSTEM FOR ALL FLOOR DRAINS AS REQUIRED BY LOCAL CODE.					
4.	ACCESSIBLE FIXTURES SHALL BE MOUNTED AND INSTALLED PER TAS.					
5.	PROVIDE FLOOR MOUNTED CARRIERS FOR ALL WALL MOUNTED FIXTURES.					
6.	PROVIDE TRUE-BRO "LAV-GUARD" INSULATION KIT FOR EXPOSED PIPING AT ALL ACCESSIBLE SINKS AND LAVS.					


PLUMBING GENERAL NOTES	
1. FURNISH AND INSTALL ALL MATERIALS AND LABOR REQUIRED TO PROVIDE AND OPERABLE PLUMBING SYSTEMS WITH ALL ITEMS AND APPURTENANCES NECESSARY, EVEN THOUGH NOT SPECIFICALLY CALLED OUT.	
2. ALL WORK AND/OR MATERIAL SHALL BE INSTALLED BY A LICENSED CONTRACTOR.	
3. ALL WORK SHALL BE PERFORMED IN STRICT ACCORDANCE WITH ALL APPLICABLE STATE AND LOCAL CODES AND ORDINANCES. IN CASE OF CONFLICT BETWEEN THE DRAWINGS/SPECIFICATIONS AND THE CODES AND ORDINANCES, THE HIGHEST STANDARD SHALL APPLY. THE PLUMBING CONTRACTOR SHALL SATISFY CODE REQUIREMENTS AS A MINIMUM STANDARD WITHOUT ANY EXTRA COST TO THE OWNER.	
4. CROSS-CONNECTIONS OF ANY FIXTURE, DEVICE OR CONSTRUCTION WHICH WILL PERMIT BACKFLOW CONNECTIONS BETWEEN A WATER DISTRIBUTION SYSTEM AND ANY PART OF THE DRAINAGE SYSTEM SHALL NOT BE INSTALLED.	
5. PLUMBING FIXTURES SHALL BE AS SCHEDULED. ALL HANDICAP FIXTURE INSTALLATIONS SHALL BE IN COMPLIANCE WITH ADA AND TAS (TEXAS ACCESSIBILITY STANDARDS). CONFIRM EXACT LOCATIONS OF ALL PLUMBING FIXTURES WITH ARCHITECT PRIOR TO INSTALLATION. ALL FIXTURES SHALL BE COMPLETE WITH ALL NECESSARY TRIM. ALL EXPOSED METAL PARTS SHALL BE CHROME PLATED BRASS.	
6. CONFIRM ROUGH-IN REQUIREMENTS FOR ALL EQUIPMENT PRIOR TO INSTALLATION.	
7. COORDINATE EXACT ROUTING OF ALL WORK WITH ALL OTHER TRADES PRIOR TO INSTALLATION OF WORK.	
8. PROVIDE TRAP GUARDS FOR ALL FLOOR DRAINS AND FLOOR SINKS EXCEPT FOR THOSE AREAS NOT REQUIRED BY THE CITY OF DENTON PLUMBING CODE.	
9. PROVIDE FACTORY MANUFACTURED WATER HAMMER ARRESTORS WHERE REQUIRED AND/OR INDICATED ON THE DRAWINGS.	
10. CONTRACTOR SHALL CONFIRM DEPTHS OF EXISTING SEWER LINES AND CONFIRM ADEQUACY FOR CONNECTION OF NEW SYSTEM. THE ENGINEER SHALL BE NOTIFIED IF THE REQUIRED SLOPES CAN NOT BE MAINTAINED, PRIOR TO INSTALLATION OF ANY NEW PIPING.	
11. ALL WATER PIPING PASSING THROUGH CONCRETE FLOOR SLABS SHALL BE COMPLETELY ISOLATED FROM THE CONCRETE BY ENCASING IN 1/2" THICK FLEXIBLE FOAM PLASTIC INSULATION FROM WELL BELOW THE BOTTOM OF THE CONCRETE SLAB UP TO TWO INCHES ABOVE THE BEAMS BELOW GRADE. IT SHALL BE WRAPPED WITH 2 PLYS OF 15# FELT TO ISOLATE THE PIPE FROM THE CONCRETE. WHERE WATER PIPE EXTENDS THROUGH CONCRETE GRADE BEAMS BELOW GRADE, IT SHALL BE ENCASED IN 30" THICK FLEXIBLE FOAM PLASTIC INSULATION. PIPING BELOW SLAB SHALL BE TYPE "M" SFT TEMPER COPPER WITHOUT JOINTS.	
12. ALL EXPOSED PIPING PASSING THROUGH FLOORS, CEILINGS OR WALLS SHALL BE PROVIDED WITH APPROVED PLATES OF SUFFICIENT DIAMETER TO COVER THE SLEEVE OPENING AND FIT SNUGLY AROUND THE PIPE.	
13. WATER AND SEWER LINES SHALL BE LAID IN SEPARATE TRENCHES WITH A MINIMUM HORIZONTAL SPACING AS REQUIRED BY CODE.	
14. THIS CONTRACTOR SHALL FURNISH ALL PIPE SUPPORTS REQUIRED FOR HIS EQUIPMENT AND MATERIAL. ALL HORIZONTAL RUNS OF PIPING SHALL BE SUPPORTED BY PIPE HANGERS SPACED NOT MORE THAN 10 FEET APART FOR PIPES 1-1/4" AND LARGER, AND 8' FOR PIPES SMALLER THAN 1-1/4", AND AT EACH JOINT FOR SOIL OR WASTE PIPE. ADDITIONAL SUPPORTS SHALL BE PROVIDED WHERE REQUIRED TO PREVENT SAGGING. HANGERS FOR COPPER PIPE SHALL HAVE NYLON INSULATED BUSHINGS OR PIPE SHALL BE WRAPPED WITH 15# FELT.	
15. CLEANOUTS SHALL BE PROVIDED WHERE INDICATED ON THE DRAWINGS, OR WHERE REQUIRED, TO PROVIDE ACCESS TO ALL LINES AND AT HORIZONTAL RUN AT INTERVALS NOT EXCEEDING 80 FEET IN ALL SOIL, WASTE AND DRAIN LINES. CLEANOUTS SHALL BE SAME AS PIPE EXCEPT CLEANOUTS LARGER THAN 4" WILL NOT BE REQUIRED.	
16. DO NOT INSTALL PVC PIPING IN ANY RETURN AIR PLENUMS.	
17. BACKFLOW PREVENTERS (RPZ) SHALL BE CERTIFIED AND SUBMITTED TO THE CITY OF DENTON.	
18. PROVIDE A MINIMUM CLEARANCE OF 24" OF FREE AREA IN FRONT OF BACKFLOW PREVENTERS FOR ACCESSIBILITY. ALL BACKFLOW PREVENTERS SHALL BE PROVIDED WITH SEDIMENT STRAINER, ISOLATION VALVES, AIR GAP, AND FULL-SIZE DRAIN PIPING.	
19. CONTRACTOR SHALL WRAP ALL EXISTING PVC PIPING, INSTALLED WITHIN THE RETURN AIR PLENUM SPACE, WITH UNIFRAX FIBREWRAP 0.5 PLENUM INSULATION.	
20. ALL VALVES LOCATED ABOVE THE CEILING SHALL BE PROVIDED WITH AN IDENTIFICATION LABEL ON THE CEILING BELOW THE ITEM.	
21. FOR ALL PIPING WITHIN THE PROJECT AREA, MISSING SECTIONS OF INSULATION SHALL BE PATCHED AND REPAIRED. USE INSULATION OF SAME THICKNESS AS EXISTING INSULATION. INSTALL NEW JACKET LAPPING AND SEALED OVER EXISTING.	

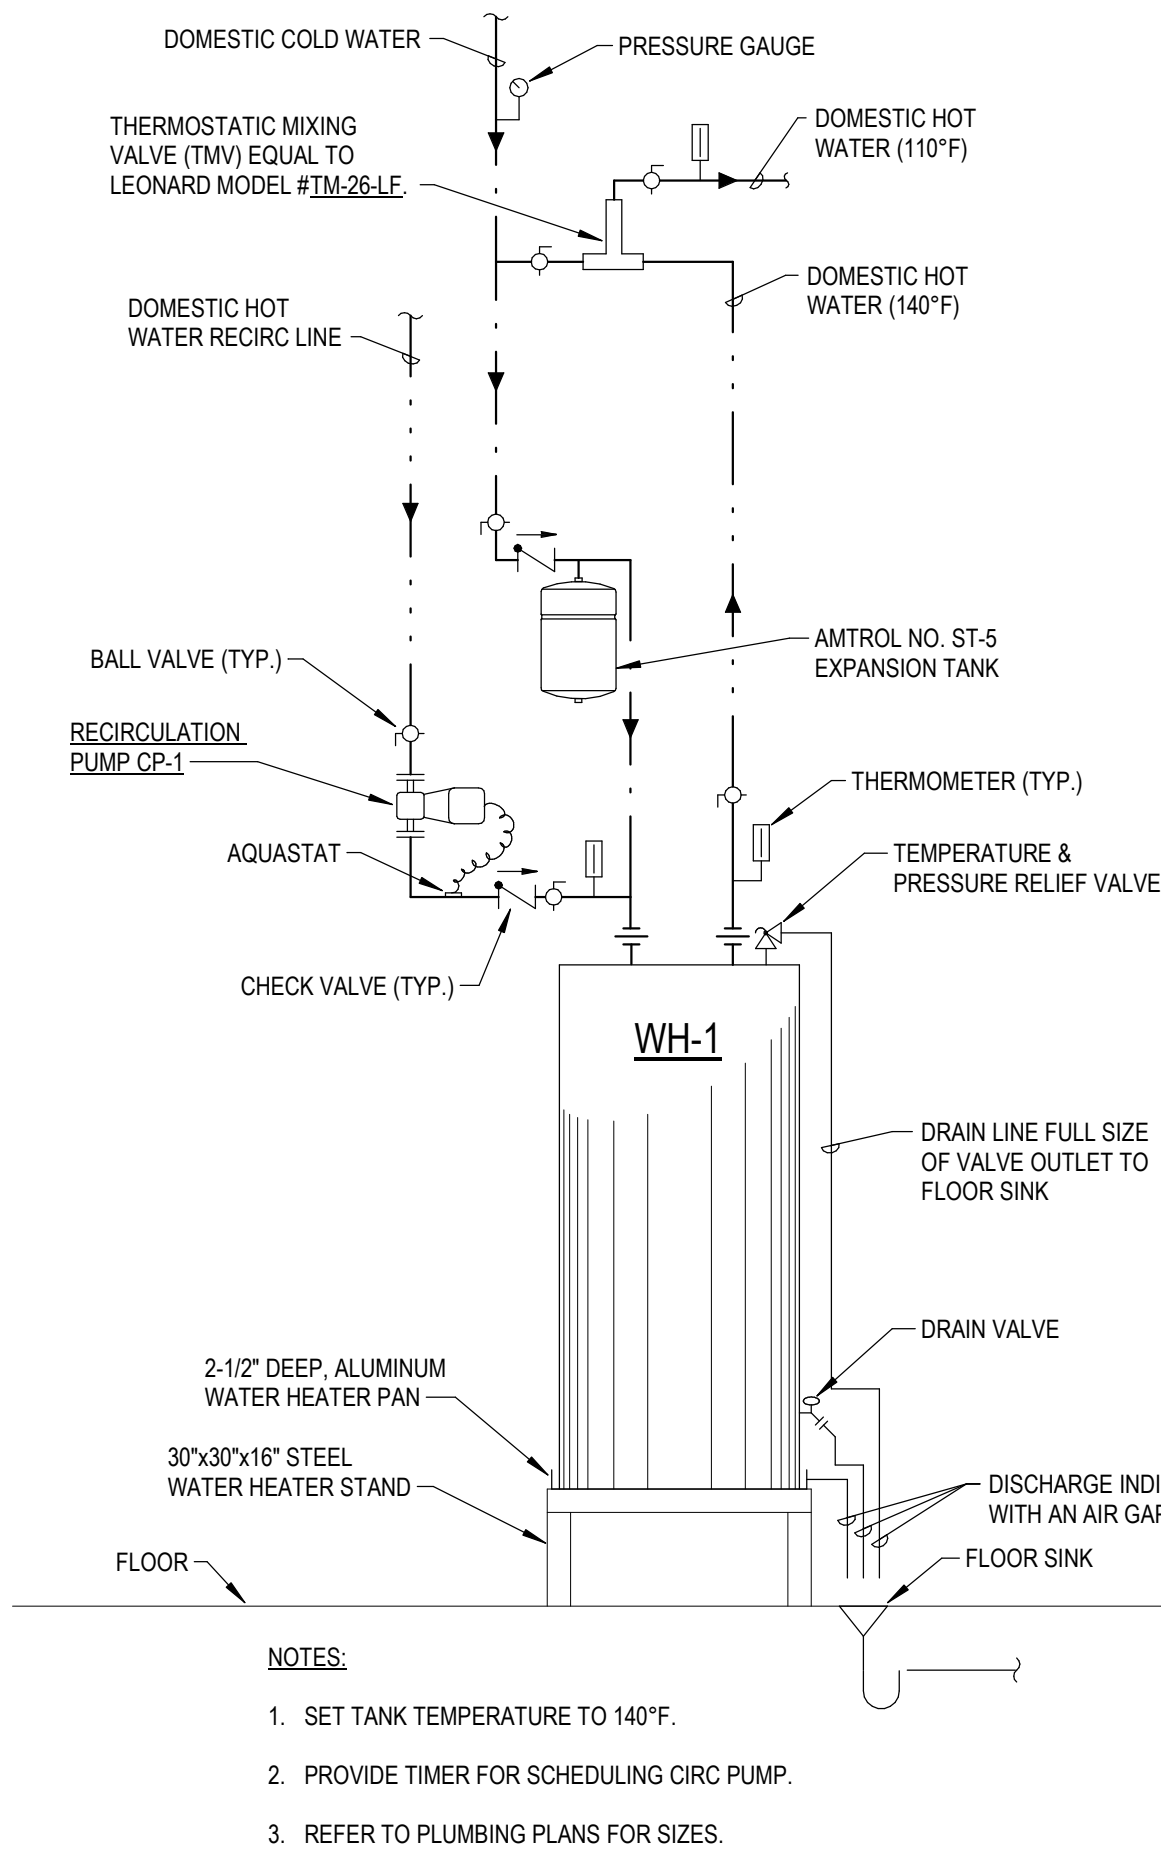

ELECTRIC WATER HEATER DETAIL
NOT TO SCALE

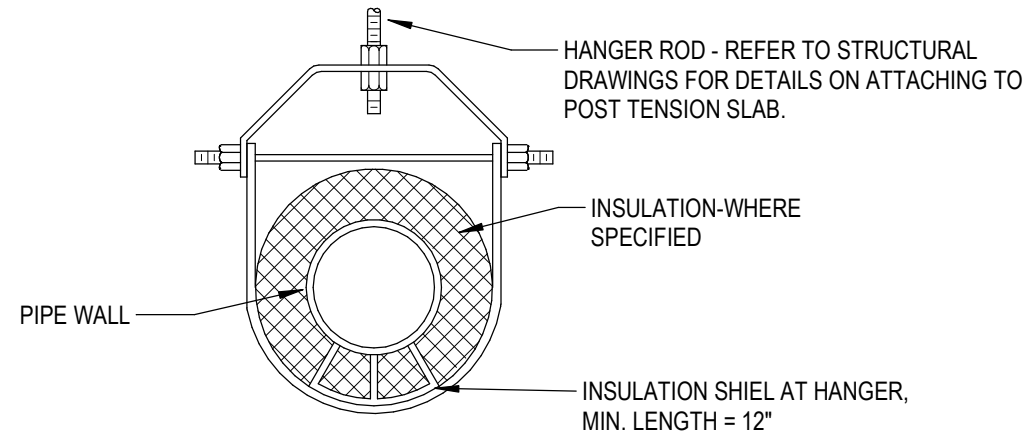

ADJUSTABLE CLEVIS HANGER

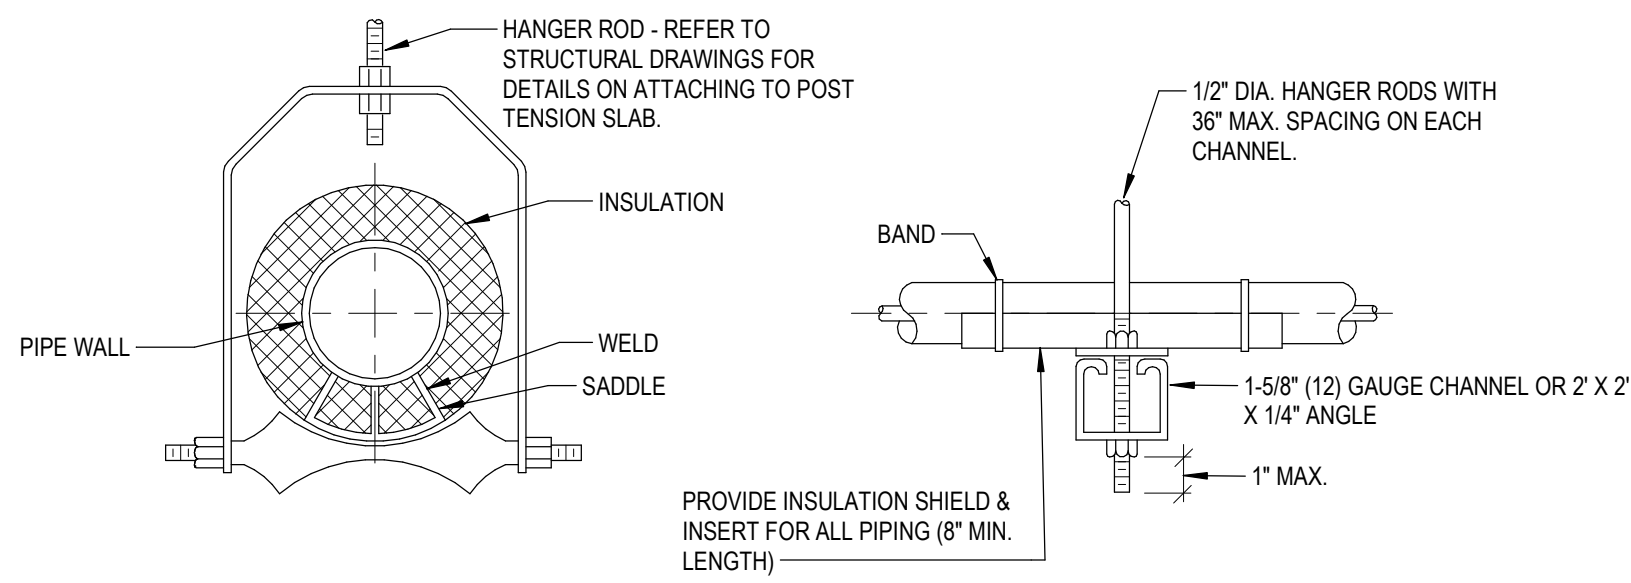


ADJUSTABLE ROLLER HANGER

MAXIMUM PIPE SUPPORT SPACING, FEET																		
NOM. PIPE SIZE	THRU 3/4"	1	1-1/4	1-1/2	2	2-1/2	3	4	5	6	8	10	12	14	16	18	20	24
SPACING	7 FT	7	8	9	10	11	12	14	16	17	19	22	23	25	27	28	30	32


NOTE: FOR TRAPEZE HANGER TAKE SPACING OF SMALLEST PIPE SIZE ON TRAPEZE.

PIPE HANGER DETAILS
NOT TO SCALE


FLUSH VALVE INSTALLATION DETAIL
NOT TO SCALE

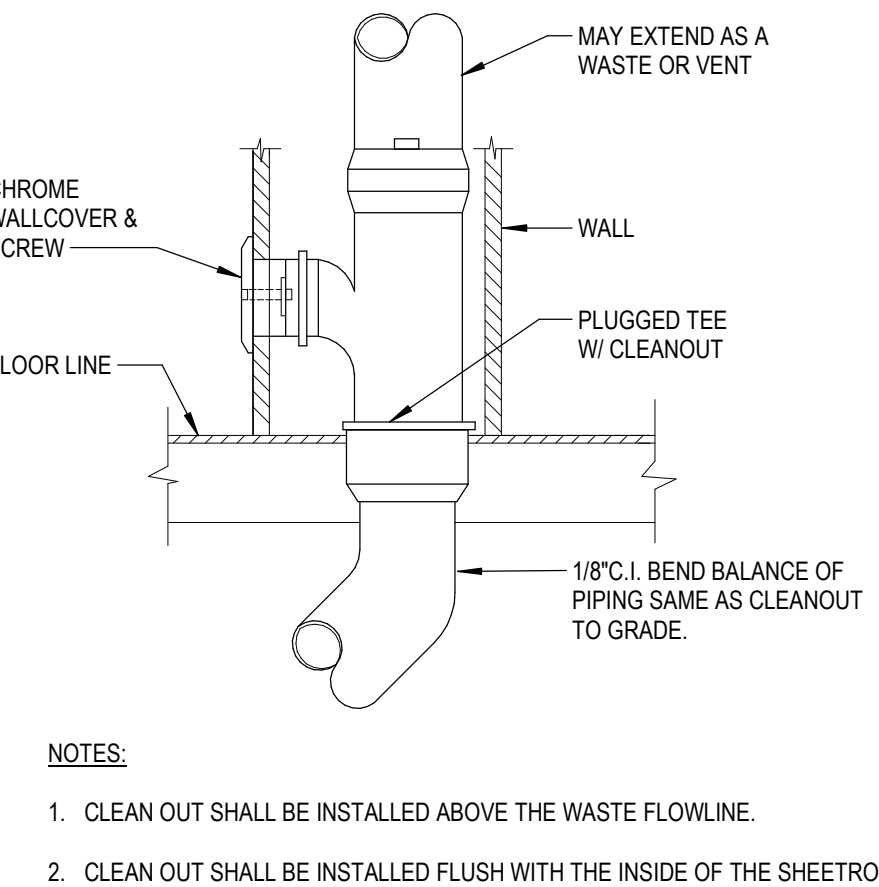

WALL CLEANOUT DETAIL
NOT TO SCALE

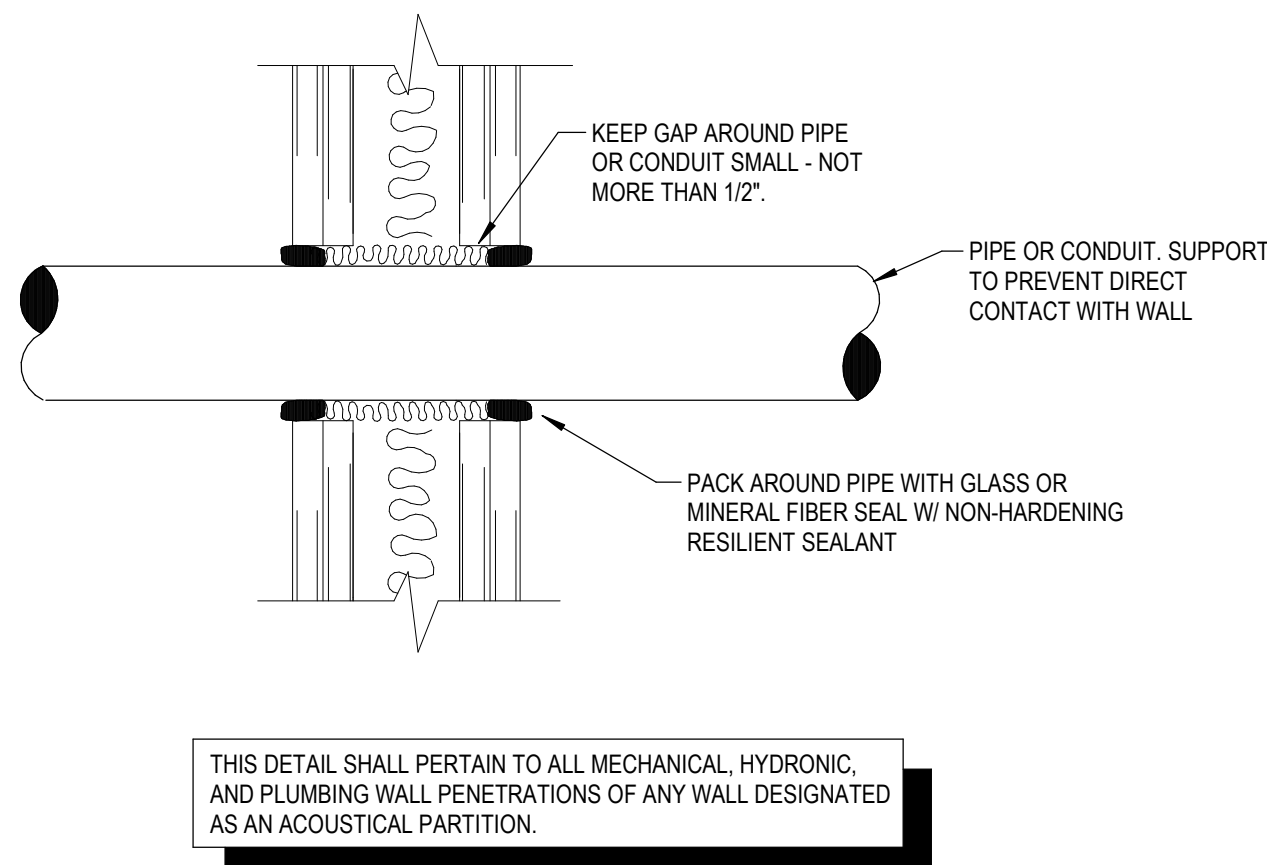

DRYWALL PIPE PENETRATION DETAIL
NOT TO SCALE

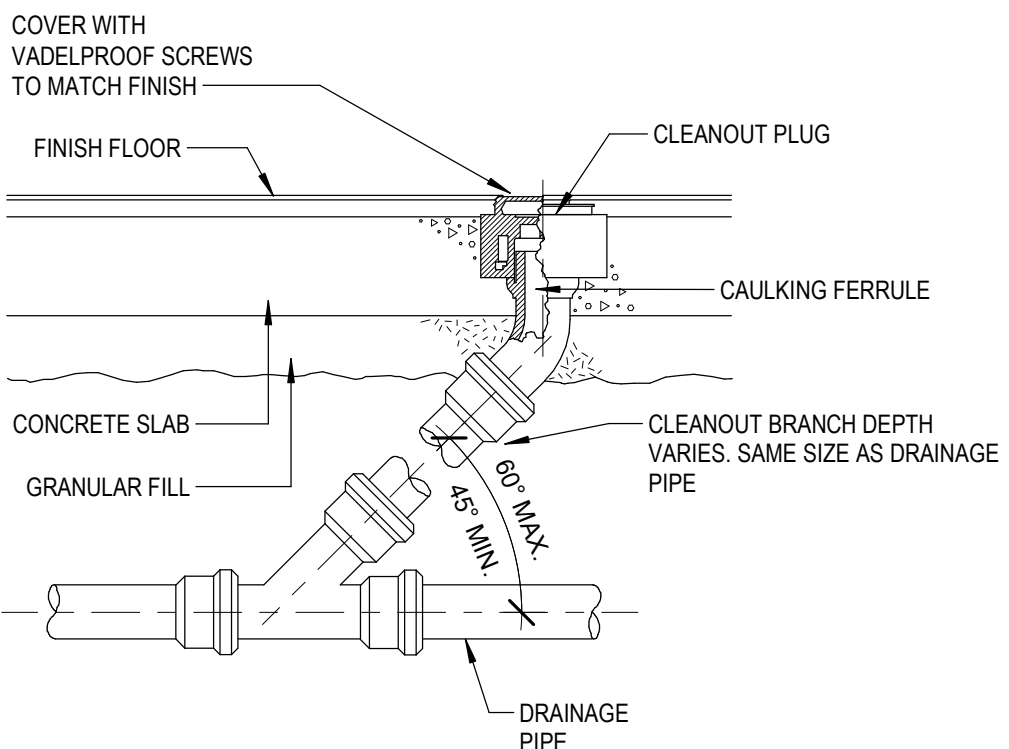

BELOW FLOOR CLEANOUT DETAIL
NOT TO SCALE

TREANOR

2554 Elm Street, Suite 200
Dallas, TX 75226
Phone: 214.752.0108
www.treanor.design

UNIVERSITY OF NORTH TEXAS
CHILTON HALL LEVEL 1 RENOVATION
410 Avenue C
Denton, Texas 76201

This drawing is an instrument of service and shall remain the property of Treanor. The drawing and the concepts and ideas contained herein shall not be used, reproduced, revised, or retained without the express written approval of Treanor, unless the Architect-Client agreement requires otherwise. Submission or distribution of this drawing to meet official or regulatory requirements or for other purposes in connection with this project is prohibited as it is contrary to the public interest and constitutes a violation of any of the rights of Treanor.

Issued For: **ISSUE FOR CONSTRUCTION**
Date: 01/16/2025

REVISIONS		
NO	DESCRIPTION	DATE
1	ADDENDUM 1	02/27/25

BHB
BAIRD, HAMPTON & BROWN
building partners


8300 Ridglea Pl., Ste. 700 Fort Worth, TX 76116
mail@bhbc.com • (817)338-1277 • bhbc.com
TBP&S Firm #44, #10011300, #10011302, #10194146
BHB Project # 2023.029.003

P301

PLUMBING SCHEDULES
AND DETAILS

Treanor NO. HE0569.2401.00

8/28/2024 1:05:30 AM Autodesk Docs:HE0569.2401.00 UNT Chilton Hall Level 1 Renovation Chilton Hall Level 1 Renovation_R04_Arch.rvt

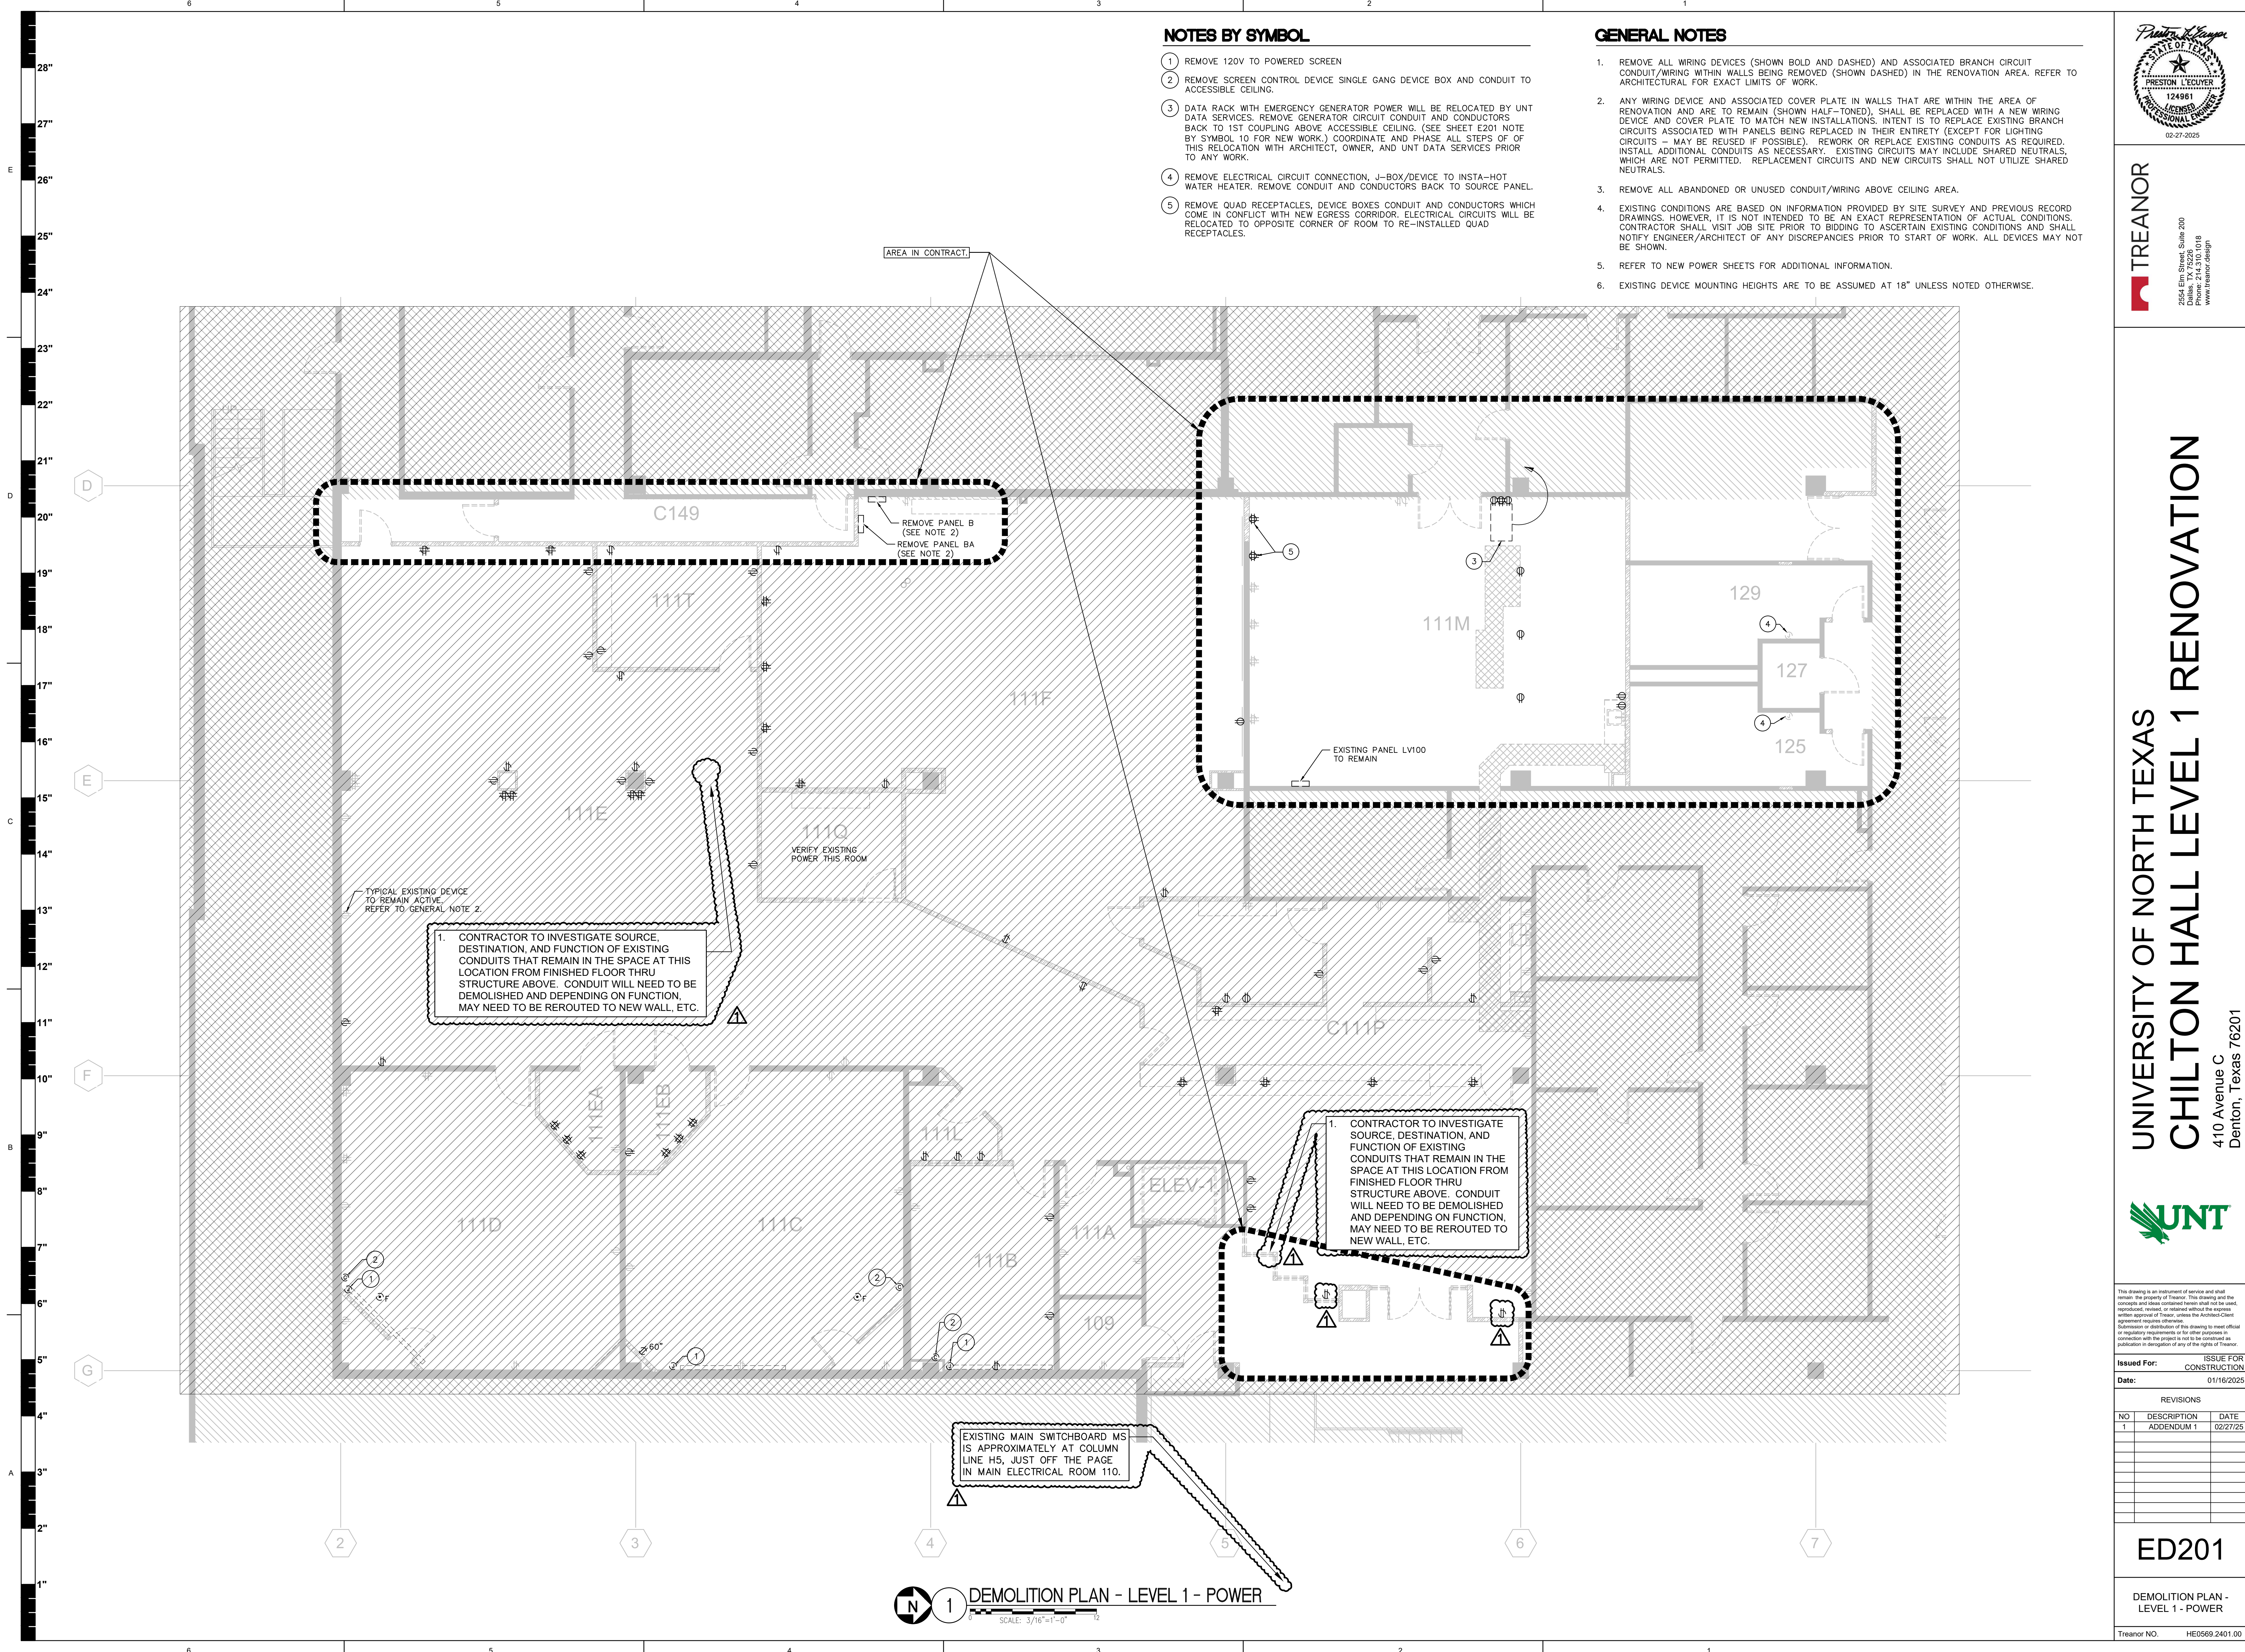

NOTES BY SYMBOL

- 1 REMOVE 120V TO POWERED SCREEN
- 2 REMOVE SCREEN CONTROL DEVICE SINGLE GANG DEVICE BOX AND CONDUIT TO ACCESSIBLE CEILING.
- 3 DATA RACK WITH EMERGENCY GENERATOR POWER WILL BE RELOCATED BY UNT DATA SERVICES. REMOVE GENERATOR CIRCUIT CONDUIT AND CONDUCTORS BACK TO 1ST COUPLING ABOVE ACCESSIBLE CEILING. (SEE SHEET E201 NOTE BY SYMBOL 10 FOR NEW WORK.) COORDINATE AND PHASE ALL STEPS OF THIS RELOCATION WITH ARCHITECT, OWNER, AND UNT DATA SERVICES PRIOR TO ANY WORK.
- 4 REMOVE ELECTRICAL CIRCUIT CONNECTION, J-BOX/DEVICE TO INSTA-HOT WATER HEATER. REMOVE CONDUIT AND CONDUCTORS BACK TO SOURCE PANEL.
- 5 REMOVE QUAD RECEPTACLES, DEVICE BOXES CONDUIT AND CONDUCTORS WHICH COME IN CONFLICT WITH NEW EGRESS CORRIDOR. ELECTRICAL CIRCUITS WILL BE RELOCATED TO OPPOSITE CORNER OF ROOM TO RE-INSTALLED QUAD RECEPTACLES.

GENERAL NOTES

1. REMOVE ALL WIRING DEVICES (SHOWN BOLD AND DASHED) AND ASSOCIATED BRANCH CIRCUIT CONDUIT/WIRING WITHIN WALLS BEING REMOVED (SHOWN DASHED) IN THE RENOVATION AREA. REFER TO ARCHITECTURAL FOR EXACT LIMITS OF WORK.
2. ANY WIRING DEVICE AND ASSOCIATED COVER PLATE IN WALLS THAT ARE WITHIN THE AREA OF RENOVATION AND ARE TO REMAIN (SHOWN HALF-TONED), SHALL BE REPLACED WITH A NEW WIRING DEVICE AND COVER PLATE TO MATCH NEW INSTALLATIONS. INTENT IS TO REPLACE EXISTING BRANCH CIRCUITS ASSOCIATED WITH PANELS BEING REPLACED IN THEIR ENTIRETY (EXCEPT FOR LIGHTING CIRCUITS - MAY BE REUSED IF POSSIBLE). REWORK OR REPLACE EXISTING CONDUITS AS REQUIRED. INSTALL ADDITIONAL CONDUITS AS NECESSARY. EXISTING CIRCUITS MAY INCLUDE SHARED NEUTRALS, WHICH ARE NOT PERMITTED. REPLACEMENT CIRCUITS AND NEW CIRCUITS SHALL NOT UTILIZE SHARED NEUTRALS.
3. REMOVE ALL ABANDONED OR UNUSED CONDUIT/WIRING ABOVE CEILING AREA.
4. EXISTING CONDITIONS ARE BASED ON INFORMATION PROVIDED BY SITE SURVEY AND PREVIOUS RECORD DRAWINGS. HOWEVER, IT IS NOT INTENDED TO BE AN EXACT REPRESENTATION OF ACTUAL CONDITIONS. CONTRACTOR SHALL VISIT JOB SITE PRIOR TO BIDDING TO ASCERTAIN EXISTING CONDITIONS AND SHALL NOTIFY ENGINEER/ARCHITECT OF ANY DISCREPANCIES PRIOR TO START OF WORK. ALL DEVICES MAY NOT BE SHOWN.
5. REFER TO NEW POWER SHEETS FOR ADDITIONAL INFORMATION.
6. EXISTING DEVICE MOUNTING HEIGHTS ARE TO BE ASSUMED AT 18" UNLESS NOTED OTHERWISE.



TREANOR

2554 Elm Street, Suite 300
Dallas, TX 75226-0018
www.treanor.com

UNIVERSITY OF NORTH TEXAS CHILTON HALL LEVEL 1 RENOVATION

410 Avenue C
Denton, Texas 76201



This drawing is an instrument of service and shall remain the property of Treanor. The drawing and the concepts and ideas contained herein shall not be used, reproduced, copied, or otherwise disclosed without the express written approval of Treanor, unless the Architect/Client agreement requires otherwise. Subsequent to distribution of this drawing to meet official or regulatory requirements or for other purposes in connection with the project is not to be construed as publication in derogation of any of the rights of Treanor.

Issued For: ISSUE FOR CONSTRUCTION

Date: 01/16/2025

REVISIONS		
NO	DESCRIPTION	DATE
1	ADDENDUM 1	02/27/25

ED201

DEMOLITION PLAN -
LEVEL 1 - POWER


Treanor NO. HE0569.2401.00

NOTES BY SYMBOL

- 1 NOT USED.
- 2 NOT USED.
- 3 TV/FLAT PANEL DISPLAY RECEPTACLE IN A/V BACK BOX. COORDINATE WITH A/V.
- 4 RECEPTACLE MOUNTED AT COUNTER TOP HEIGHT. COORDINATE WITH ARCHITECT.
- 5 POWERED FURNITURE FEED. (2+2, 8-WIRE STANDARD WHIP IS BASIS OF DESIGN)
- 6 3KW TANKLESS WATER HEATER.
- 7 RESTROOM MOTORIZED LIFT (208V, 1-PHASE).
- 8 PROJECTOR RECEPTACLE IN A/V CEILING BOX. COORDINATE LOCATION WITH A/V.
- 9 INSTALL RECEPTACLE IN CEILING. MODIFY/EXTEND EXISTING CONDUIT AND CONDUCTORS FROM ORIGINAL LOCATION IN THIS ROOM (SEE SHEET ED201).
- 10 INSTALL EMERGENCY GENERATOR POWER FOR RELOCATED DATA RACK. MODIFY/EXTEND EXISTING CONDUIT AND CONDUCTORS FROM ORIGINAL LOCATION (SEE SHEET ED201). UNIT DATA SERVICES WILL RELOCATE DATA RACK WHEN GENERATOR POWER IS READY. CONNECT GENERATOR CIRCUIT CONDUCTORS IN SAME FASHION AS ORIGINAL CONNECTION. COORDINATE AND PHASE ALL STEPS OF THIS RELOCATION WITH ARCHITECT, OWNER, AND UNIT DATA SERVICES PRIOR TO ANY WORK.
- 11 MOUNT RECEPTACLES HORIZONTALLY ABOVE BACK CUSHION OF SEATING, APPROXIMATELY 42". COORDINATE WITH ARCHITECT AND "UNT GATHR"
- 12 OVERHEAD ROLLING FIRE GRILLE CONTROL LOCATION (J-BOX AND CONDUIT TO ABOVE CEILING).
- 13 OVERHEAD ROLLING FIRE GRILLE.
- 14 OVERHEAD COILING SECURITY GRILLE CONTROL LOCATION (J-BOX AND CONDUIT TO ABOVE CEILING).
- 15 OVERHEAD COILING SECURITY GRILLE.
- 16 POINT OF SALE RECEPTACLE MOUNTED INSIDE MILLWORK.

GENERAL NOTES

1. REFER TO DATA, SECURITY, AUDIO/VISUAL, MECHANICAL, PLUMBING, FIRE, AND ARCHITECTURAL SERIES DRAWINGS AND SPECIFICATIONS FOR EQUIPMENT INFORMATION AND ADDITIONAL ELECTRICAL WORK.
2. ALL CONDUITS SHALL BE CONCEALED IN WALLS OR ABOVE CEILING. DO NOT INSTALL SURFACE MOUNTED CONDUIT EXCEPT IN ELECTRICAL ROOM AND IN ROOF STRUCTURE AREA OF ROOMS WITHOUT CEILINGS. NO CURVED PORTION OF CONDUIT SHALL EXIT WALLS. IN ROOMS WITH NO CEILINGS, CONDUITS SHALL EXIT WALLS TIGHT TO ROOF STRUCTURE.
3. VERIFY ALL POWER AND J-BOX LOCATIONS WITH ARCHITECT AND OWNER PRIOR TO ROUGH-IN.
4. ALL FURNITURE SHALL BE FED FROM WALL. POWER POLES ARE NOT ACCEPTABLE.
5. ALL RECEPTACLES IN RESTROOMS, ON COUNTERS EQUIPPED WITH SINKS, AND ANY RECEPTACLE WITHIN 6'-0" OF A SINK (AND ANY OTHER AREAS REQUIRED BY THE NEC) SHALL BE GFI.
6. VERIFY FINISH OF DEVICES WITH ARCHITECT AND INTERIOR DESIGNER PRIOR TO SUBMITTING.
7. PROVIDE CODE REQUIRED DISCONNECT FOR ALL MECHANICAL AND PLUMBING EQUIPMENT.
8. HEIGHTS INDICATED ARE FROM FINISHED FLOOR TO CENTER OF OUTLET. DEVICES ARE AT 18" AFF IF THERE IS NO DESIGNATION.
9. REPLACE WIRING DEVICES AND COVER PLATES FOR ALL EXISTING WIRING DEVICES TO REMAIN IN THE RENOVATION AREA. ALL COVER PLATES SHALL BE LABELED WITH ASSOCIATED CIRCUIT NUMBER.
10. ANY WIRING DEVICE AND ASSOCIATED COVER PLATE IN WALLS THAT ARE WITHIN THE AREA OF RENOVATION AND ARE TO REMAIN (SHOWN HALF-TONED), SHALL BE REPLACED WITH A NEW WIRING DEVICE AND COVER PLATE TO MATCH NEW INSTALLATIONS. INTENT IS TO REPLACE EXISTING BRANCH CIRCUITS ASSOCIATED WITH PANELS BEING REPLACED IN THEIR ENTIRETY (EXCEPT FOR LIGHTING CIRCUITS - MAY BE REUSED IF POSSIBLE). REWORK OR REPLACE EXISTING CONDUITS AS REQUIRED. INSTALL ADDITIONAL CONDUITS AS NECESSARY. EXISTING CIRCUITS MAY INCLUDE SHARED NEUTRALS, WHICH ARE NOT PERMITTED. REPLACEMENT CIRCUITS AND NEW CIRCUITS SHALL NOT UTILIZE SHARED NEUTRALS.
11. BRING UP TO CODE ALL EXISTING ELECTRICAL ITEMS THAT ARE TO REMAIN (INSTALL PUSH-PENNIES IN J-BOX OPENINGS, ETC.)

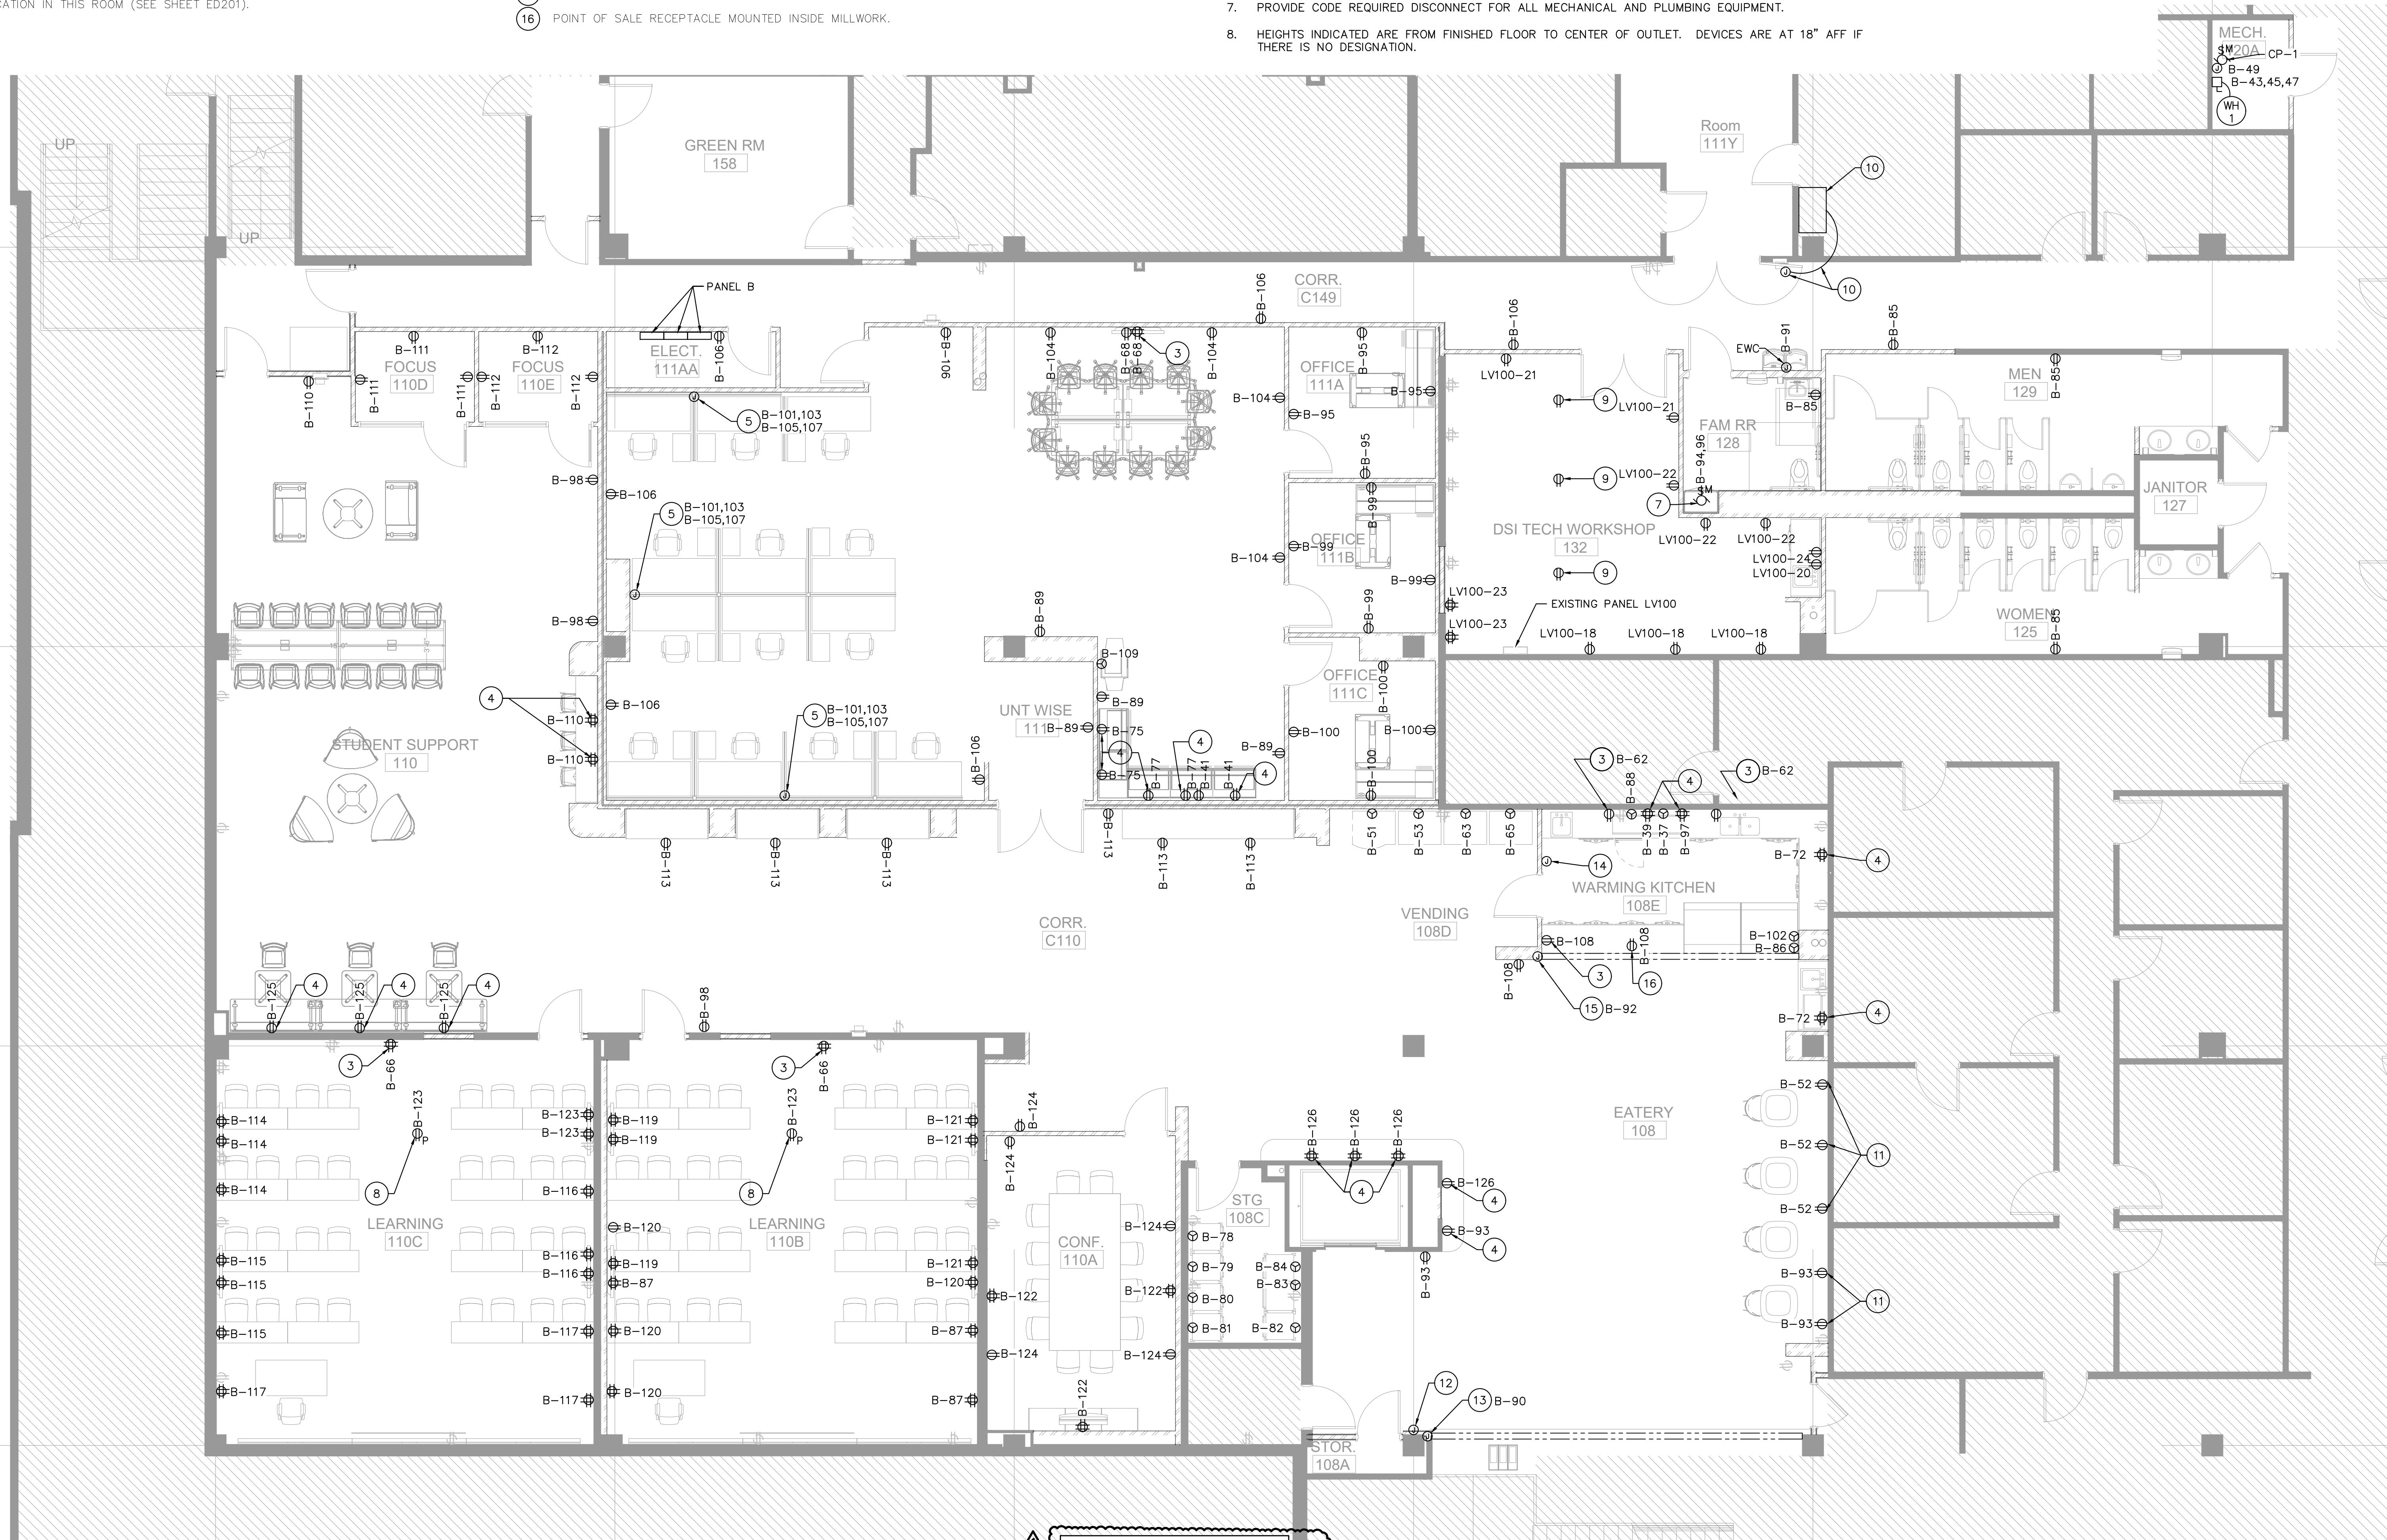

EXISTING MAIN SWITCHBOARD MS IS APPROXIMATELY AT COLUMN LINE H5, JUST OFF THE PAGE IN MAIN ELECTRICAL ROOM 110.

120V CONTROL NOTES

PROVIDE 120V POWER CIRCUIT TO EACH ITEM OF EQUIPMENT AS REQUIRED. REFER TO MECHANICAL SCHEDULES, ETC. THESE CIRCUITS ARE NOT NECESSARILY IDENTIFIED BUT SHALL BE PROVIDED AS NECESSARY TO PROVIDE COMPLETE OPERATIONAL SYSTEM. TYPICAL EQUIPMENT INCLUDES HVAC CONTROL PANELS, FIRE DAMPERS, SMOKE DAMPERS, DUCT DETECTORS, FIRE ALARM CONTROL PANELS, LIGHTING CONTROLS, ETC. MAXIMUM OF (2) CONTROL CIRCUITS PER 120V, 20 AMP CIRCUIT. IDENTIFY CIRCUITS USED ON RECORD DRAWINGS.



TREANOR

2554 Elm Street, Suite 200
Dallas, TX 75226-1018
www.treanor.com

UNIVERSITY OF NORTH TEXAS CHILTON HALL LEVEL 1 RENOVATION

410 Avenue C
Denton, Texas 76201



This drawing is an instrument of service and shall remain the property of Treanor. This drawing and the concepts and ideas contained herein shall not be used, reproduced, copied, or otherwise disclosed without the express written approval of Treanor, unless the Architect/Client agreement requires otherwise. Subsequent to completion of this drawing, Treanor shall not be responsible for any errors or omissions in the drawing or for any consequences resulting therefrom.

Issued For: CONSTRUCTION

Date: 01/16/2025

REVISIONS		
NO	DESCRIPTION	DATE
1	ADDENDUM 1	02/27/25

E201

FLOOR PLAN -

LEVEL 1 - POWER

Treanor NO. HE0569.2401.00

PANEL BA (EXISTING)								SECTION 1 OF 1	
V (L-L)		208	PHASE		3	BUS	100 A	SURFACE MOUNTED	
V (L-N)		120	WIRE		4	MLO		22,000 A.I.C.	
DESCRIPTION	LOAD (KVA)	BKR POLES	BKR AMPS	CKT #	CKT 1	BKR POLES	BKR AMPS	LOAD (KVA)	DESCRIPTION
IWH-1		2	30	1	2	1	20		111 LTS
				-	3	4	1		111 LTS
IWH-2		2	30	5	6	1	20		111 LTS
		-	-	7	8	1	20		111 LTS
SPARE		1	20	9	10	1	20		SPARE
SPARE		1	20	11	12	1	20		111E PLUGS
GEN. BATT. CHARGER		2	20	13	14	1	20		111D PLUGS
		-	-	15	16	1	20		111D PLUGS
GEN. JACKET HEATER		1	20	17	18	1	20		111D PLUGS
GENERATOR PLUGS		1	20	19	20	1	20		111D PLUGS
SPACE		1	21	22	23	1	20		111D PLUGS
		-	-	23	24	1	20		SPACE
111F PLUG		1	30	25	26	1	20		111D PLUGS
111E PLUGS		1	20	27	28	1	20		111D PLUGS
111E PLUGS		1	20	29	30	1	20		SPACE
111E PLUGS		1	20	31	32	1	20		111K PLUGS
SPACE		1	20	33	34	1	20		111K PLUGS
SPACE		1	20	35	36	1	20		SPACE
SPACE		1	20	37	38	1	20		SPACE
SPACE		1	20	39	40	1	20		SPACE
SPACE		1	20	41	42	1	20		SPACE
	CONN. LOAD (KVA)	N.E.C. MULT. (KVA)							
LIGHTING									
MOTOR									
HEATING									
KITCHEN									
RECEPTACLE									
MISCELLANEOUS									
TOTAL									
								CONN. LOAD (AMPS)	
								N.E.C. MULT. (AMPS)	
								#DIVIDED PERCENT SPARE	
								1.00 KITCHEN MULTIPLIER	
								1.00 MISC. MULTIPLIER	

PANEL LV100 (EXISTING)										SECTION 1 OF 1	
V (L-L)		208	PHASE 3		BUS		#N/A		SURFACE MOUNTED		
V (L-N)		120	WIRE 4		MLO				22,000 A.I.C		
										#N/A	
DESCRIPTION	LOAD (KVA)	BKR POLES	BKR AMPS	CKT #	CKT #	BKR POLES	BKR AMPS	LOAD (KVA)	DESCRIPTION		
RECEPTACLES		1	20	1	2	1	20		RECEPTACLES		
RECEPTACLES		1	20	3	4	1	20		RECEPTACLES		
RECEPTACLES		1	20	5	6	1	20		RECEPTACLES		
RECEPTACLES		1	20	7	8	1	20		RECEPTACLES		
RECEPTACLES		1	20	9	10	1	20		RECEPTACLES		
RECEPTACLES		1	20	11	12	1	20		RECEPTACLES		
RECEPTACLES		1	20	13	14	1	20		RECEPTACLES		
CENTER DESK		1	20	15	16	1	20		RECEPTACLES		
FAIRALL DESK		1	20	17	18	1	20		SPARE		
MORAN DESK		1	20	19	20	1	20		SPARE		
SPARE		1	20	21	22	1	20		SPARE		
SPARE			20	23	24		20		SPARE		
				25	26						
				27	28						
				29	30						
				31	32						
				33	34						
				35	36						
				37	38						
				39	40						
				41	42						
	CONN. LOAD (KVA)	N.E.C. MULT. (KVA)									
LIGHTING MOTOR											
HEATING KITCHEN											
RECEPTACLE											
MISCELLANEOUS											
SPARE											
TOTAL											

CONN. LOAD (AMPS)

N.E.C. MULT. (AMPS)

#DIVIDED PERCENT SPARE

1.00 KITCHEN MULTIPLIER

1.00 MISC. MULTIPLIER

PANEL B

V (L-L) 208
V (L-N) 120

PHASE 3
WIRE 4

MCB


BUS
300 A


400 A
300 A


SECTION 1 OF 3
SURFACE MOUNTED
22,000 A I.C

DESCRIPTION	LOAD (KVA)	BKR POLES	BKR AMPS	CKT #	CKT #	BKR POLES	BKR AMPS	LOAD (KVA)	DESCRIPTION
110G PLUGS	1	1	20	1	2	1	20	111 LIGHTS	
110A AND 110H PLUGS	1	1	20	3	4	1	20	111 LIGHTS	
110H PLUGS	1	1	20	5	6	1	20	111 LIGHTS	
110 PLUGMOLD	1	1	20	7	8	1	20	112 PLUGMOLD	
112 PLUGMOLD	1	1	20	9	10	1	20	112 PLUGMOLD	
112 PLUGMOLD	1	1	20	11	12	1	20	112 PLUGS	
10P PLUGS	1	1	20	13	14	1	20	12 GPO PLUGS	
110 PLUGS	1	1	20	15	16	1	20	REFRIGERATOR	
110 PLUGS	1	1	20	17	18	1	20	110Q, 10A, 10E PLUGS	
111Q PLUGS	1	1	20	19	20	1	20	FRONT COMPUTERS	
110 PLUGS	1	1	20	21	22	1	20	10E PLUGS	
110 PLUGS	1	1	20	23	24	1	20	110H PLUGS	
110 PLUGS	1	1	20	25	26	1	20	10E QUADS	
10E QUADS	1	1	20	27	28	1	20	CARRELS PLUGS	
CARRELS PLUGS	1	1	20	29	30	1	20	10E DED. PLUG	
CARRELS PLUGS	1	1	20	31	32	1	20	111 LIGHTS	
110 NIGHT LIGHTS	1	1	20	33	34	1	20	111 LIGHTS	
110 NIGHT PLUGS	1	1	20	35	36	1	20	111 LIGHTS	
KITCHEN EQUIP.	1.6	1	20	37	38	1	20	111 LIGHTS	
KITCHEN EQUIP.	1.6	1	20	39	40	1	20	111 LIGHTS	
UNT W/SE BREAK ROOM	0.5	1	20	41	42	1	20	111 LIGHTS	
DESCRIPTION	LOAD (KVA)	BKR POLES	BKR AMPS	CKT #	CKT #	BKR POLES	BKR AMPS	LOAD (KVA)	DESCRIPTION
WATER HEATER "WH-1"	4.5	3	20	43	44	3	20	111 LIT	
RECIP. PUMP "CP-1"	0.3	1	20	45	46	1	20	111 LIT	
VENDING	1.6	1	20	47	48	1	20	111 LIT	
VENDING	1.6	1	20	49	50	1	20	0.4 RECEPTACLES	
GEN. BATT. CHARGER	2	2	20	51	52	1	20	110 PLUGS	
GEN. JACKET HEATER	1	1	20	53	54	1	20	110 PLUGS	
GENERATOR PLUGS	1	1	20	55	56	1	20	110 PLUGS	
VENDING	1.6	1	20	57	58	1	20	10 KITCHEN TV	
VENDING	1.6	1	20	59	60	1	20	0.7 TV RECEPTS 110A, 110B	
111F PLUGS	1	1	20	61	62	1	20	0.4 TV RECEPTS 111	
111E PLUGS	1	1	20	63	64	1	20	110 PLUGS	
111E PLUGS	1	1	20	65	66	1	20	16 KITCHEN QUAD	
111E PLUGS	1	1	20	67	68	1	20	110 PLUGS	
UNT W/SE BREAK ROOM	0.7	1	20	69	70	1	20	110 PLUGS	
UNT W/SE BREAK ROOM	0.7	1	20	71	72	1	20	16 LAPTOP CART CHARGER	
LAPTOP CART CHARGER	1.6	1	20	73	74	1	20	16 LAPTOP CART CHARGER	
LAPTOP CART CHARGER	1.6	1	20	75	76	1	20	16 LAPTOP CART CHARGER	
LAPTOP CART CHARGER	1.6	1	20	77	78	1	20	16 LAPTOP CART CHARGER	
LAPTOP CART CHARGER	1.6	1	20	79	80	1	20	16 LAPTOP CART CHARGER	
LAPTOP CART CHARGER	1.6	1	20	81	82	1	20	16 LAPTOP CART CHARGER	
LAPTOP CART CHARGER	1.6	1	20	83	84	1	20	16 LAPTOP CART CHARGER	
DESCRIPTION	LOAD (KVA)	BKR POLES	BKR AMPS	CKT #	CKT #	BKR POLES	BKR AMPS	LOAD (KVA)	DESCRIPTION
RECEPTACLES	0.9	1	20	85	86	1	20	11 KITCHEN EQUIP	
RECEPTACLES	1.1	1	20	87	88	1	20	10 KITCHEN EQUIP	
RECEPTACLES	0.7	1	20	89	90	1	20	10 FIRE GRILLE	
WATER COOL. GFI-BREAKER	0.5	1	20	91	92	1	20	10 SECURITY GRILLE	
RECEPTACLES	1.3	1	20	93	94	2	40	40 MOUNTED LIGHT	
RECEPTACLES	0.7	1	20	95	96	-	-	-	
KITCHEN EQUIP.	0.7	1	20	97	98	1	20	RECEPTACLES	
RECEPTACLES	0.7	1	20	99	100	1	20	0.7 RECEPTACLES	
MOD. FURNITURE	19	2	20	101	102	1	20	0.7 KITCHEN EQUIP.	
MOD. FURNITURE	-	-	20	103	104	1	20	0.9 RECEPTACLES	
MOD. FURNITURE	19	2	20	105	106	1	20	1.1 RECEPTACLES	
MOD. FURNITURE	-	-	20	107	108	1	20	1.3 RECEPTACLES & POS	
COPY EQUIPMENT	1.5	1	20	109	110	1	20	0.7 RECEPTACLES	
RECEPTACLES	0.7	1	20	111	112	1	20	0.7 RECEPTACLES	
RECEPTACLES	0.7	1	20	113	114	1	20	1.1 RECEPTACLES	
RECEPTACLES	1.1	1	20	115	116	1	20	1.1 RECEPTACLES	
RECEPTACLES	1.1	1	20	117	118	1	20	1.1 SPARE	
RECEPTACLES	1.1	1	20	119	120	1	20	1.3 RECEPTACLES	
RECEPTACLES	1.1	1	20	121	122	1	20	1.1 RECEPTACLES	
RECEPTACLES	1.1	1	20	123	124	1	20	1.1 RECEPTACLES	
RECEPTACLES	0.7	1	20	125	126	1	20	1.3 RECEPTACLES	
CONN. N.E.C. LOAD MULT. (KVA)									
HALF-TONE DESCRIPTION TEXT INDICATES EXISTING CIRCUIT									
CIRCUITS/LOADS EXTENDING TO THIS PANEL									
SECTION 1 - RESERVED FOR EX. PANEL B RELOCATIONS. SECTION 2									
RESERVED FOR EX. PANEL BA RELOCATIONS. SECTION 3									
RESERVED FOR NEW CIRCUITS OF RELOCATION.									
LIGHTING								201	CONN. LOAD (AMPS)
MOTOR	4	5						153	N.E.C. MULT. (AMPS)
HEATING	5	6						100	PERCENT SPARE
KITCHEN								100	KITCHEN MULT.PLIER
RECEPTACLE	49	29						100	MISC. MULT.PLIER
MISCELLANEOUS	15	15							
SPARE									
TOTAL	73	55							

ELECTRICAL (ROOM 111T)

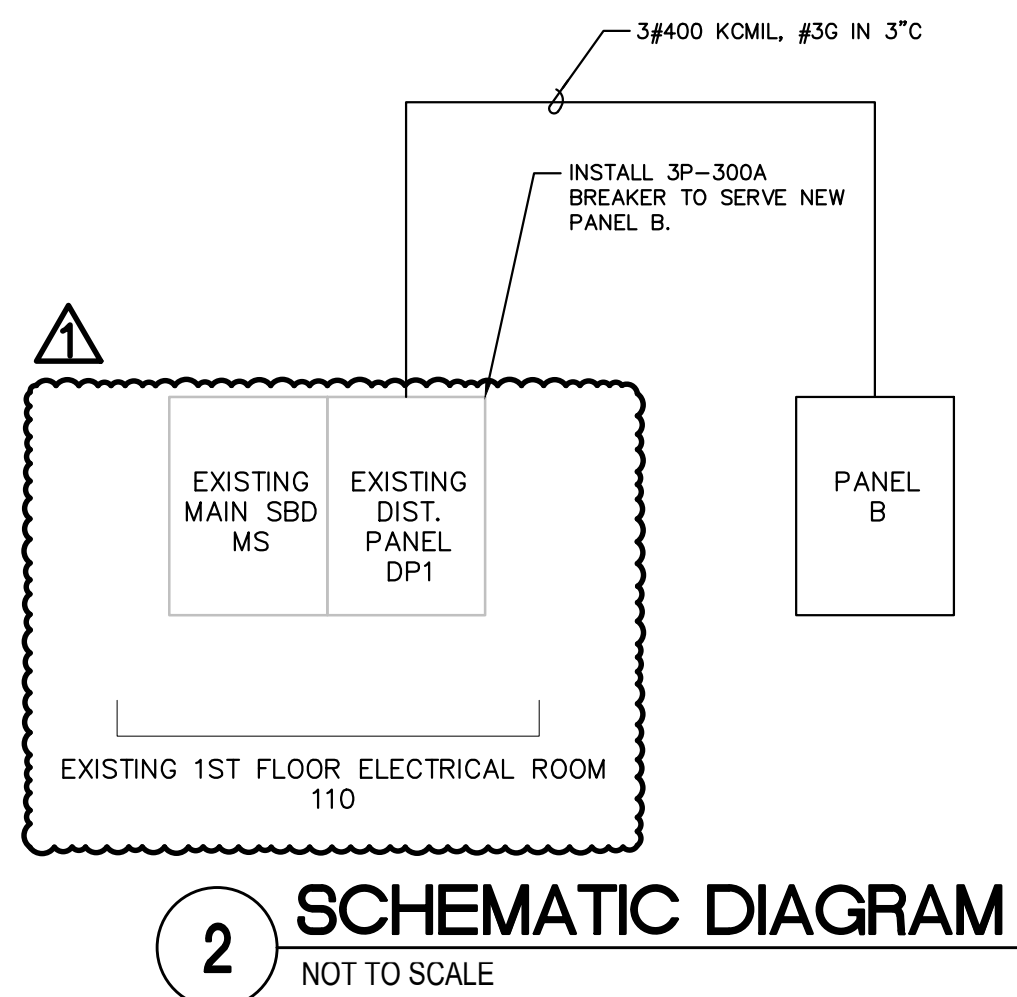

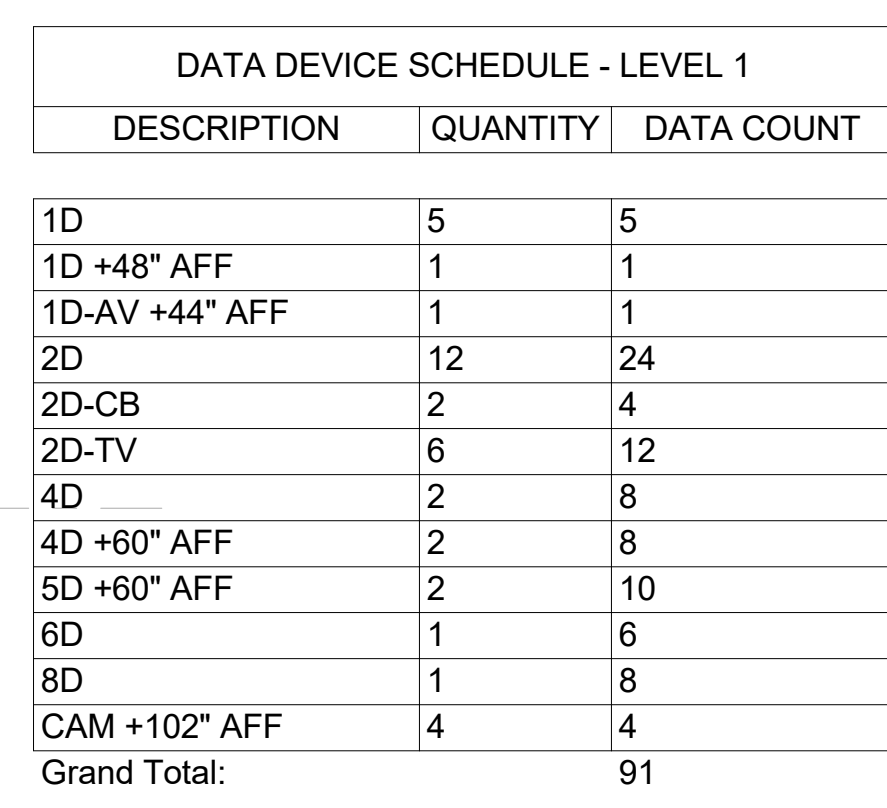[illegible]

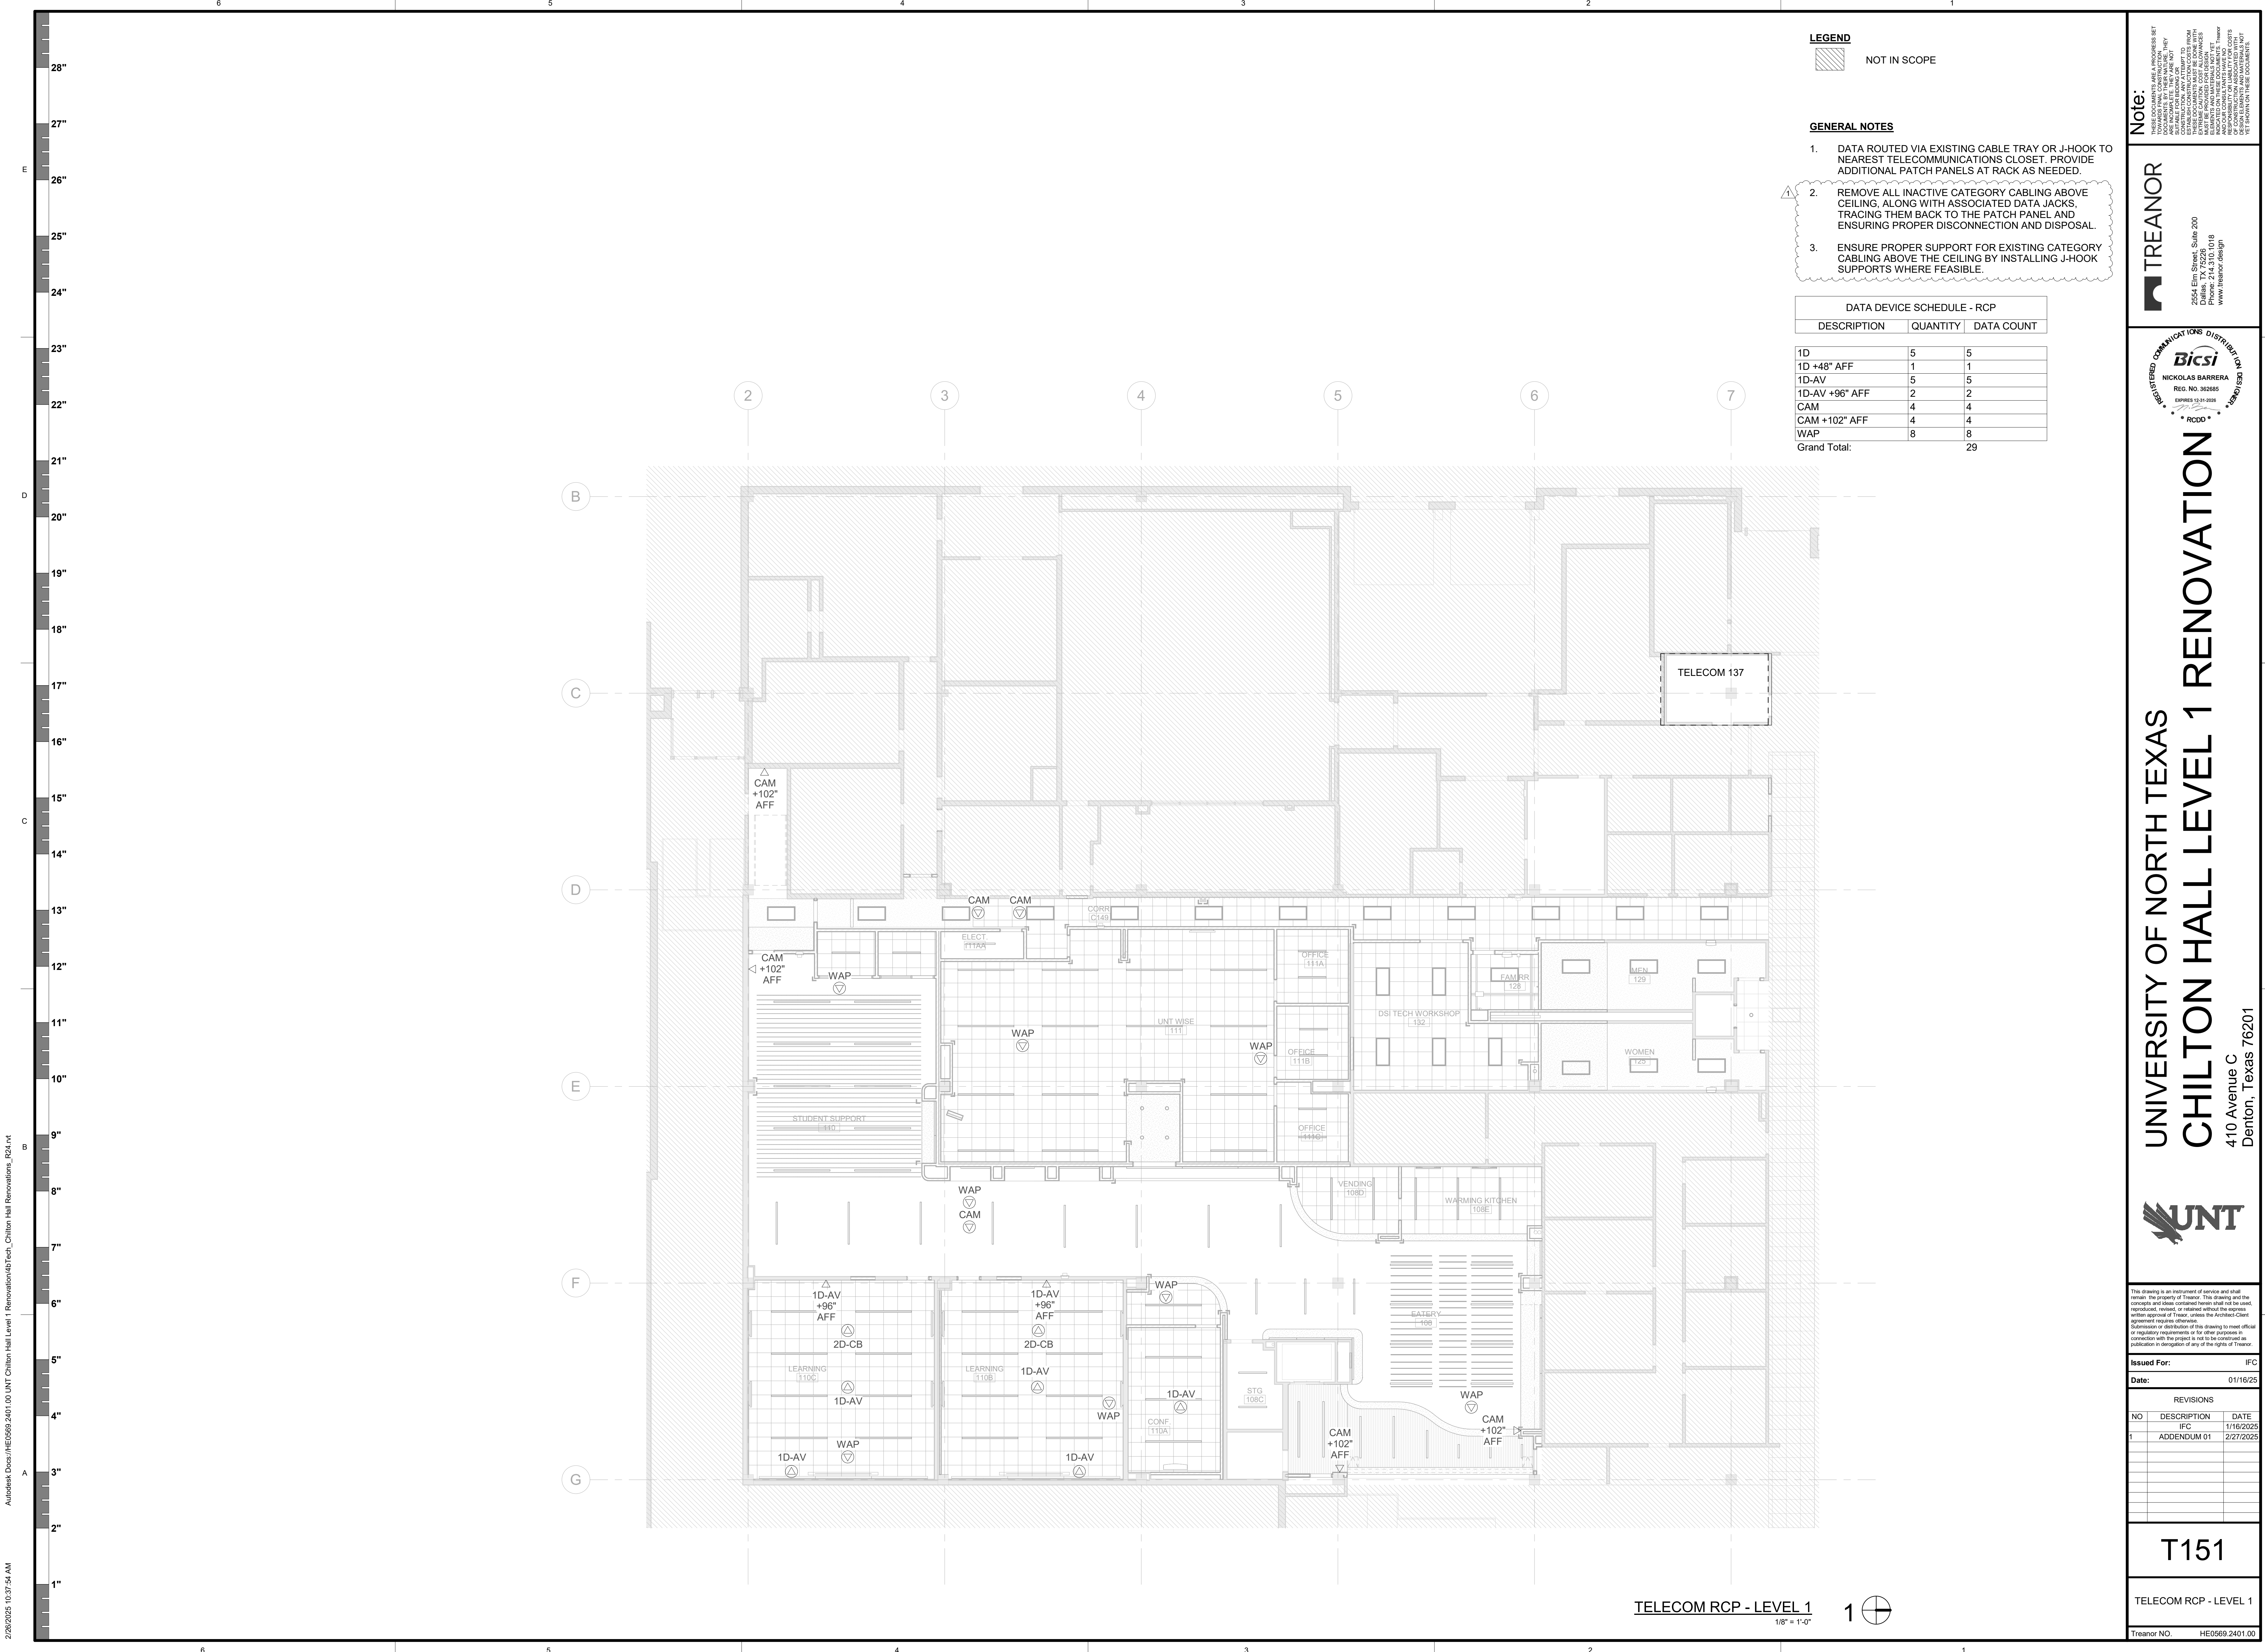

LEGEND

NOT IN SCOPE

GENERAL NOTES

- DATA ROUTED VIA EXISTING CABLE TRAY OR J-HOOK TO NEAREST TELECOMMUNICATIONS CLOSET. PROVIDE ADDITIONAL PATCH PANELS AT RACK AS NEEDED.
- REMOVE ALL INACTIVE CATEGORY CABLING ABOVE CEILING, ALONG WITH ASSOCIATED DATA JACKS, TRACING THEM BACK TO THE PATCH PANEL AND ENSURING PROPER DISCONNECTION AND DISPOSAL.
- ENSURE PROPER SUPPORT FOR EXISTING CATEGORY CABLING ABOVE THE CEILING BY INSTALLING J-HOOK SUPPORTS WHERE FEASIBLE.

UNIVERSITY OF NORTH TEXAS
CHILTON HALL LEVEL 1 RENOVATION
410 Avenue C
Denton, Texas 76201

TREANOR
2554 Elm Street, Suite 200
Dallas, TX 75201
Phone: 214.752.0108
www.treanor.com

Bicsi
NICKOLAS BARRERA
REG. NO. 362685
EXPIRES 12-31-2025
RCDD

This drawing is an instrument of service and shall remain the property of Treanor. The drawing and the concepts and ideas contained herein shall not be used, reproduced, copied, or related without the express written approval of Treanor, unless the Architect-Client agreement requires otherwise. Submission or distribution of this drawing to meet official or regulatory requirements or for other purposes in connection with this project is to be controlled as provided in derogation of any of the rights of Treanor.

Issued For: IFC
Date: 01/16/25

REVISIONS		
NO	DESCRIPTION	DATE
1	IFC	1/16/2025
1	ADDENDUM 01	2/27/2025

T151

TELECOM RCP - LEVEL 1

Treanor NO. HE0569.2401.00

SECTION 01 1000
TABLE OF CONTENTS

VOLUME 1

DIVISION 00 - PROCUREMENT AND CONTRACTING REQUIREMENTS
00 7000 GENERAL CONDITIONS

DIVISION 01 - GENERAL REQUIREMENTS
01 0110 TABLE OF CONTENTS
01 1000 SUMMARY OF WORK
01 2200 UNIT PRICES
01 2500 SUBSTITUTION PROCEDURES
01 2600 CONTRACT MODIFICATION PROCEDURES
01 2900 PAYMENT PROCEDURES
01 3100 PROJECT MANAGEMENT AND COORDINATION
01 3200 CONSTRUCTION PROGRESS DOCUMENTATION
01 3233 PHOTOGRAPHIC DOCUMENTATION
01 3300 SUBMITTAL PROCEDURES
01 3516 ALTERATION PROJECT PROCEDURES
01 4000 QUALITY REQUIREMENTS
01 4100 REGULATORY REQUIREMENTS
01 4200 REFERENCES
01 5000 TEMPORARY FACILITIES AND CONTROLS
01 5300 MOLD PREVENTION MEASURES
01 5720 INDOOR AIR QUALITY PLAN DURING CONSTRUCTION
01 6000 PRODUCT REQUIREMENTS
01 7300 EXECUTION
01 7419 CONSTRUCTION WASTE MANAGEMENT AND DISPOSAL
01 7700 CLOSEOUT PROCEDURES
01 7823 OPERATION AND MAINTENANCE DATA
01 7839 PROJECT RECORD DOCUMENTS
01 7900 DEMONSTRATION AND TRAINING
01 9113 GENERAL COMMISSIONING REQUIREMENTS

DIVISION 02 - EXISTING CONDITIONS
02 4119 SELECTIVE DEMOLITION

DIVISION 05 - METALS
05 5000 METAL FABRICATIONS

DIVISION 06 - WOOD, PLASTICS, AND COMPOSITES

- 06 1000 ROUGH CARPENTRY
- 06 2000 INTERIOR FINISH CARPENTRY
- 06 4100 ARCHITECTURAL WOOD CASEWORK

DIVISION 07 - THERMAL AND MOISTURE PROTECTION

- 07 8400 FIRESTOPPING
- 07 9200 JOINT SEALANTS
- 07 9219 ACOUSTICAL JOINT SEALANTS

DIVISION 08 - OPENINGS

~~08 1116 ALUMINUM DOORS AND FRAMES~~

- 08 1213 HOLLOW METAL FRAMES
- 08 1416 FLUSH WOOD DOORS
- 08 3100 ACCESS DOORS AND PANELS
- 08 3323 OVERHEAD COILING DOORS
- 08 3326 OVERHEAD COILING GRILLES
- 08 4313 ALUMINUM-FRAMED STOREFRONTS
- 08 7100 DOOR HARDWARE
- 08 7113 POWER DOOR OPERATORS
- 08 8000 GLAZING

DIVISION 09 - FINISHES

- 09 2116 GYPSUM BOARD ASSEMBLIES
- 09 3000 TILING
- 09 5100 ACOUSTICAL CEILINGS
- 09 5426 SUSPENDED WOOD CEILINGS
- 09 6500 RESILIENT FLOORING
- 09 6813 TILE CARPETING
- 09 8430 SOUND-ABSORBING WALL AND CEILING UNITS
- 09 9123 INTERIOR PAINTING

DIVISION 10 - SPECIALTIES

~~10 1100 VISUAL DISPLAY UNITS~~

~~10 1419 DIMENSIONAL LETTER SIGNAGE~~

~~10 1423 PANEL SIGNAGE~~

- 10 2113.19 PLASTIC TOILET COMPARTMENTS
- 10 2600 WALL AND DOOR PROTECTION
- 10 2800 TOILET, BATH, AND LAUNDRY ACCESSORIES
- 10 4400 FIRE PROTECTION SPECIALTIES

DIVISION 11 – EQUIPMENT

11 7311 PATIENT LIFTS

DIVISION 12 - FURNISHINGS

12 3600 COUNTERTOPS

VOLUME 2

DIVISION 22 - PLUMBING

22 0010 BASIC PLUMBING REQUIREMENTS
22 0506 PLUMBING DEMOLITION
22 0512 PLUMBING AND ELECTRICAL COORDINATION
22 0529 PLUMBING SUPPORTS AND ANCHORS
22 0553 PLUMBING IDENTIFICATION
22 0593 PLUMBING TESTING, ADJUSTING AND BALANCING
22 0716 PLUMBING PIPING INSULATION
22 1000 PLUMBING PIPING
22 1001 PLUMBING SPECIALTIES
22 1119 PIPING SPECIALTIES
22 3000 PLUMBING EQUIPMENT
22 4001 PLUMBING FIXTURES (SHORT FORM)

DIVISION 23 - HEATING, VENTILATING, AND AIR-CONDITIONING (HVAC)

23 0010 BASIC MECHANICAL REQUIREMENTS
23 0506 MECHANICAL DEMOLITION
23 0512 MECHANICAL AND ELECTRICAL COORDINATION
23 0529 MECHANICAL SUPPORTS AND ANCHORS
23 0553 MECHANICAL IDENTIFICATION
23 0593 MECHANICAL TESTING, ADJUSTING AND BALANCING
23 0713 HVAC DUCT INSULATION
23 0719 HVAC PIPING INSULATION
23 0923 BUILDING CONTROL SYSTEM (BCS)
23 2113.23 HYDRONIC PIPING
23 2113.24 HYDRONIC SPECIALTIES
23 3113 METAL DUCTWORK
23 3113.19 DUCTWORK ACCESSORIES
23 3319 SOUND ATTENUATORS
23 3613 AIR TERMINALS
23 3713 AIR OUTLETS AND INLETS

DIVISION 26 - ELECTRICAL

26 0000 BASIC ELECTRICAL REQUIREMENTS
26 0500 BASIC ELECTRICAL MATERIALS AND METHODS

26 0518	ELECTRICAL CONNECTIONS TO EQUIPMENT
26 0519	CABLE, WIRE AND CONNECTORS, 600 VOLT
26 0526	GROUNDING
26 0529	SECURING AND SUPPORTING METHODS
26 0533	RACEWAYS, CONDUITS AND BOXES
26 0553	ELECTRICAL IDENTIFICATION
26 0573	SYSTEM COORDINATION AND ANALYSIS
26 0936	MODULAR DIMMING CONTROLS
26 0943	NETWORK LIGHTING CONTROLS
26 2213	DRY TYPE TRANSFORMERS
26 2416	PANELBOARDS
26 2726	WIRING DEVICES
26 2813	FUSES, 600 VOLT
26 2816	ENCLOSED SWITCHES AND CIRCUIT BREAKERS
26 2923	INSTALLATION OF VARIABLE FREQUENCY DRIVES
26 5100	INTERIOR LIGHTING

DIVISION 27 – SPECIFICATION SECTION

27 0500	COMMON WORK RESULTS FOR COMMUNICATIONS
27 0528	PATHWAYS FOR COMMUNICATIONS SYSTEMS
27 0553	IDENTIFICATIONS FOR COMMUNICATIONS SYSTEMS
27 1100	COMMUNICATIONS EQUIPMENT ROOM FITTINGS
27 1500	COMMUNICATIONS HORIZONTAL CABLING
27 1600	COMMUNICATION CONNECTING CORDS, DEVICES AND ADAPTORS
27 2000	DATA COMMUNICATIONS EQUIPMENT
27 3000	VOICE COMMUNICATIONS EQUIPMENT
27 4000	AUDIOVISUAL SYSTEM

DIVISION 28 - ELECTRONIC SAFETY AND SECURITY

28 0500	COMMON WORK RESULTS FOR ELECTRONIC SAFETY AND SECURITY
28 1300	ACCESS CONTROL
28 2300	VIDEO SURVEILLANCE
28 3107	EXTENSION OF EXISTING FIRE ALARM SYSTEM

SECTION 01 1000
TABLE OF CONTENTS

VOLUME 1

DIVISION 00 - PROCUREMENT AND CONTRACTING REQUIREMENTS
00 7000 GENERAL CONDITIONS

DIVISION 01 - GENERAL REQUIREMENTS
01 0110 TABLE OF CONTENTS SEALS PAGE (ARCHITECTURAL)
01 1000 SUMMARY OF WORK
01 2200 UNIT PRICES
01 2500 SUBSTITUTION PROCEDURES
01 2600 CONTRACT MODIFICATION PROCEDURES
01 2900 PAYMENT PROCEDURES
01 3100 PROJECT MANAGEMENT AND COORDINATION
01 3200 CONSTRUCTION PROGRESS DOCUMENTATION
01 3233 PHOTOGRAPHIC DOCUMENTATION
01 3300 SUBMITTAL PROCEDURES
01 3516 ALTERATION PROJECT PROCEDURES
01 4000 QUALITY REQUIREMENTS
01 4100 REGULATORY REQUIREMENTS
01 4200 REFERENCES
01 5000 TEMPORARY FACILITIES AND CONTROLS
01 5300 MOLD PREVENTION MEASURES
01 5720 INDOOR AIR QUALITY PLAN DURING CONSTRUCTION
01 6000 PRODUCT REQUIREMENTS
01 7300 EXECUTION
01 7419 CONSTRUCTION WASTE MANAGEMENT AND DISPOSAL
01 7700 CLOSEOUT PROCEDURES
01 7823 OPERATION AND MAINTENANCE DATA
01 7839 PROJECT RECORD DOCUMENTS
01 7900 DEMONSTRATION AND TRAINING
01 9113 GENERAL COMMISSIONING REQUIREMENTS

DIVISION 02 - EXISTING CONDITIONS
02 4119 SELECTIVE DEMOLITION

DIVISION 05 - METALS
05 5000 METAL FABRICATIONS

DIVISION 06 - WOOD, PLASTICS, AND COMPOSITES

- 06 1000 ROUGH CARPENTRY
- 06 2000 INTERIOR FINISH CARPENTRY
- 06 4100 ARCHITECTURAL WOOD CASEWORK

DIVISION 07 - THERMAL AND MOISTURE PROTECTION

- 07 8400 FIRESTOPPING
- 07 9200 JOINT SEALANTS
- 07 9219 ACOUSTICAL JOINT SEALANTS

DIVISION 08 - OPENINGS

~~08 1116 ALUMINUM DOORS AND FRAMES~~

- 08 1213 HOLLOW METAL FRAMES
- 08 1416 FLUSH WOOD DOORS
- 08 3100 ACCESS DOORS AND PANELS
- 08 3323 OVERHEAD COILING DOORS
- 08 3326 OVERHEAD COILING GRILLES
- 08 4313 ALUMINUM-FRAMED STOREFRONTS
- 08 7100 DOOR HARDWARE
- 08 7113 POWER DOOR OPERATORS
- 08 8000 GLAZING

DIVISION 09 - FINISHES

- 09 2116 GYPSUM BOARD ASSEMBLIES
- 09 3000 TILING
- 09 5100 ACOUSTICAL CEILINGS
- 09 5426 SUSPENDED WOOD CEILINGS
- 09 6500 RESILIENT FLOORING
- 09 6813 TILE CARPETING
- 09 8430 SOUND-ABSORBING WALL AND CEILING UNITS
- 09 9123 INTERIOR PAINTING

DIVISION 10 - SPECIALTIES

~~10 1100 VISUAL DISPLAY UNITS~~

~~10 1419 DIMENSIONAL LETTER SIGNAGE~~

~~10 1423 PANEL SIGNAGE~~

- 10 2113.19 PLASTIC TOILET COMPARTMENTS
- 10 2600 WALL AND DOOR PROTECTION
- 10 2800 TOILET, BATH, AND LAUNDRY ACCESSORIES
- 10 4400 FIRE PROTECTION SPECIALTIES

~~JANUARY 16, 2025~~

FEBRUARY 27, 2025

ADDENDUM 01

DIVISION 11 – EQUIPMENT

11 7311 PATIENT LIFTS

DIVISION 12 - FURNISHINGS

12 3600 COUNTERTOPS

SECTION 01 1000
TABLE OF CONTENTS

VOLUME 2

01 0110 TABLE OF CONTENTS SEALS PAGE (MEP)

DIVISION 22 - PLUMBING

22 0010 BASIC PLUMBING REQUIREMENTS
22 0506 PLUMBING DEMOLITION
22 0512 PLUMBING AND ELECTRICAL COORDINATION
22 0529 PLUMBING SUPPORTS AND ANCHORS
22 0553 PLUMBING IDENTIFICATION
22 0593 PLUMBING TESTING, ADJUSTING AND BALANCING
22 0716 PLUMBING PIPING INSULATION
22 1000 PLUMBING PIPING
22 1001 PLUMBING SPECIALTIES
22 1119 PIPING SPECIALTIES
22 3000 PLUMBING EQUIPMENT
22 4001 PLUMBING FIXTURES (SHORT FORM)

DIVISION 23 - HEATING, VENTILATING, AND AIR-CONDITIONING (HVAC)

23 0010 BASIC MECHANICAL REQUIREMENTS
23 0506 MECHANICAL DEMOLITION
23 0512 MECHANICAL AND ELECTRICAL COORDINATION
23 0529 MECHANICAL SUPPORTS AND ANCHORS
23 0553 MECHANICAL IDENTIFICATION
23 0593 MECHANICAL TESTING, ADJUSTING AND BALANCING
23 0713 HVAC DUCT INSULATION
23 0719 HVAC PIPING INSULATION
23 0923 BUILDING CONTROL SYSTEM (BCS)
23 2113.23 HYDRONIC PIPING
23 2113.24 HYDRONIC SPECIALTIES
23 3113 METAL DUCTWORK
23 3113.19 DUCTWORK ACCESSORIES
23 3319 SOUND ATTENUATORS
23 3613 AIR TERMINALS
23 3713 AIR OUTLETS AND INLETS

DIVISION 26 - ELECTRICAL

26 0000 BASIC ELECTRICAL REQUIREMENTS

26 0500	BASIC ELECTRICAL MATERIALS AND METHODS
26 0518	ELECTRICAL CONNECTIONS TO EQUIPMENT
26 0519	CABLE, WIRE AND CONNECTORS, 600 VOLT
26 0526	GROUNDING
26 0529	SECURING AND SUPPORTING METHODS
26 0533	RACEWAYS, CONDUITS AND BOXES
26 0553	ELECTRICAL IDENTIFICATION
26 0573	SYSTEM COORDINATION AND ANALYSIS
26 0936	MODULAR DIMMING CONTROLS
26 0943	NETWORK LIGHTING CONTROLS
26 2213	DRY TYPE TRANSFORMERS
26 2416	PANELBOARDS
26 2726	WIRING DEVICES
26 2813	FUSES, 600 VOLT
26 2816	ENCLOSED SWITCHES AND CIRCUIT BREAKERS
26 2923	INSTALLATION OF VARIABLE FREQUENCY DRIVES
26 5100	INTERIOR LIGHTING

DIVISION 27 – COMMUNICATION

27 0500	COMMON WORK RESULTS FOR COMMUNICATIONS
27 0528	PATHWAYS FOR COMMUNICATIONS SYSTEMS
27 0553	IDENTIFICATIONS FOR COMMUNICATIONS SYSTEMS
27 1100	COMMUNICATIONS EQUIPMENT ROOM FITTINGS
27 1500	COMMUNICATIONS HORIZONTAL CABLING
27 1600	COMMUNICATION CONNECTING CORDS, DEVICES AND ADAPTORS
27 2000	DATA COMMUNICATIONS EQUIPMENT
27 3000	VOICE COMMUNICATIONS EQUIPMENT
27 4000	AUDIOVISUAL SYSTEM

DIVISION 28 - ELECTRONIC SAFETY AND SECURITY

28 0500	COMMON WORK RESULTS FOR ELECTRONIC SAFETY AND SECURITY
28 1300	ACCESS CONTROL
28 2300	VIDEO SURVEILLANCE
28 3107	EXTENSION OF EXISTING FIRE ALARM SYSTEM

**SECTION 08 1213
HOLLOW METAL FRAMES**

PART 1 GENERAL

1.01 SECTION INCLUDES

- A. Non-fire-rated hollow metal frames for non-hollow metal doors.
- B. Fire-rated hollow metal frames for non-hollow metal doors.

1.02 RELATED REQUIREMENTS

- A. Section 08 7100 - Door Hardware: Hardware, silencers, and weatherstripping.

1.03 REFERENCE STANDARDS

- A. AAMA/WDMA/CSA 101/I.S.2/A440 - North American Fenestration Standard/Specification for Windows, Doors, and Skylights; 2022.
- B. ADA Standards - 2010 ADA Standards for Accessible Design; 2010.
- C. ANSI/SDI A250.8 - Specifications for Standard Steel Doors and Frames (SDI-100); 2023.
- D. ANSI/SDI A250.10 - Test Procedure and Acceptance Criteria for Prime Painted Steel Surfaces for Steel Doors and Frames; 2020.
- E. ASTM A653/A653M - Standard Specification for Steel Sheet, Zinc-Coated (Galvanized) or Zinc-Iron Alloy-Coated (Galvannealed) by the Hot-Dip Process; 2023.
- F. ASTM A1008/A1008M - Standard Specification for Steel, Sheet, Cold-Rolled, Carbon, Structural, High-Strength Low-Alloy, High-Strength Low-Alloy with Improved Formability, Required Hardness, Solution Hardened, and Bake Hardenable; 2023, with Editorial Revision.
- G. ASTM A1011/A1011M - Standard Specification for Steel, Sheet and Strip, Hot-Rolled, Carbon, Structural, High-Strength Low-Alloy, High-Strength Low-Alloy with Improved Formability, and Ultra-High Strength; 2023.
- H. BHMA A156.115 - Hardware Preparation in Steel Doors and Frames; 2016.
- I. ICC A117.1 - Accessible and Usable Buildings and Facilities; 2017.
- J. ITS (DIR) - Directory of Listed Products; Current Edition.
- K. NAAMM HMMA 830 - Hardware Selection for Hollow Metal Doors and Frames; 2002.
- L. NAAMM HMMA 831 - Hardware Locations for Hollow Metal Doors and Frames; 2011.
- M. NAAMM HMMA 840 - Guide Specifications For Receipt, Storage and Installation of Hollow Metal Doors and Frames; 2017.
- N. NFPA 80 - Standard for Fire Doors and Other Opening Protectives; 2022.
- O. UL (DIR) - Online Certifications Directory; Current Edition.
- P. UL 10C - Standard for Positive Pressure Fire Tests of Door Assemblies; Current Edition, Including All Revisions.

1.04 SUBMITTALS

- A. See Section 01 3300 - Submittal Procedures.
- B. Product Data: Materials and details of design and construction, hardware locations, reinforcement type and locations, anchorage and fastening methods, and finishes; and one copy of referenced grade standard.
- C. Shop Drawings: Details of each opening, showing elevations, glazing, frame profiles, and identifying location of different finishes, if any.
- D. Manufacturer's qualification statement.
- E. Installer's qualification statement.

1.05 QUALITY ASSURANCE

- A. Manufacturer Qualifications: Provide hollow metal frames from SDI Certified manufacturer: <https://steeldoor.org/sdi-certified/#sle>.
- B. Installer Qualifications: Company specializing in performing work of the type specified and with at least three years of documented experience.

1.06 DELIVERY, STORAGE, AND HANDLING

- A. Store in accordance with applicable requirements and in compliance with standards and/or custom guidelines as indicated.

PART 2 PRODUCTS

2.01 PERFORMANCE REQUIREMENTS

- A. Hollow Metal Frames: AAMA/WDMA/CSA 101/I.S.2/A440 requirements for specific frame type:
 - 1. Performance Class (PC): AW.
- B. Refer to Door and Frame Schedule on drawings for frame sizes, fire ratings, sound ratings, finishing, door hardware to be installed, and other variations, if any.
- C. Door Frame Type: Provide hollow metal door frames with integral casings.
 - 1. Interior Doors: Use frames with integral casings.
- D. Steel Sheet: Comply with one or more of the following requirements; galvanized steel complying with ASTM A653/A653M, cold-rolled steel complying with ASTM A1008/A1008M, or hot-rolled pickled and oiled (HRPO) steel complying with ASTM A1011/A1011M, commercial steel (CS) Type B, for each.
- E. Accessibility: Comply with ICC A117.1 and ADA Standards.
- F. Glazed Lights: Non-removable stops on non-secure side; sizes and configurations as indicated on drawings. Style: Manufacturers standard.
- G. Combined Requirements: If a particular door and frame unit is indicated to comply with more than one type of requirement, comply with the specified requirements for each type; for instance, an exterior frame that is also indicated as being sound-rated must comply with the requirements specified for exterior frames and for sound-rated frames; where two requirements conflict, comply with the most stringent.
- H. Hardware Preparations, Selections and Locations: Comply with BHMA A156.115, NAAMM HMMA 830, NAAMM HMMA 831 or ANSI/SDI A250.8 (SDI-100) in accordance with specified requirements.

~~Frames Wider than 48 Inches: Reinforce with steel channel fitted tightly into head of frame, and flush with top.~~

2.02 HOLLOW METAL DOOR FRAMES WITH INTEGRAL CASINGS

- A. Interior Door Frames, Non-Fire Rated: Full profile/continuously welded type.
- B. Fire-Rated Door Frames: Full profile/continuously welded type.
 - 1. Fire Rating: As indicated on Door and Frame Schedule, tested in accordance with UL 10C or NFPA 252 ("positive pressure fire tests").
 - 2. Provide units listed and labeled by ITS (DIR) or UL (DIR).
 - a. Attach fire rating label to each fire rated unit.
 - 3. Frame Finish: Factory primed and field finished.

2.03 FINISHES

- A. Primer: Rust-inhibiting, complying with ANSI/SDI A250.10, door manufacturer's standard.

2.04 ACCESSORIES

- A. Silencers: Resilient rubber, fitted into drilled hole; provide three on strike side of single door, three on center mullion of pairs, and two on head of pairs without center mullions.

PART 3 EXECUTION

3.01 EXAMINATION

- A. Verify existing conditions before starting work.
- B. Verify that opening sizes and tolerances are acceptable.
- C. Verify that finished walls are in plane to ensure proper door alignment.

3.02 INSTALLATION

- A. Install frames in accordance with manufacturer's instructions and related requirements of specified frame standards or custom guidelines indicated.
- B. Install fire rated units in accordance with NFPA 80.
- C. Coordinate frame anchor placement with wall construction.
- D. Install door hardware as specified in Section 08 7100.

END OF SECTION

This page intentionally left blank